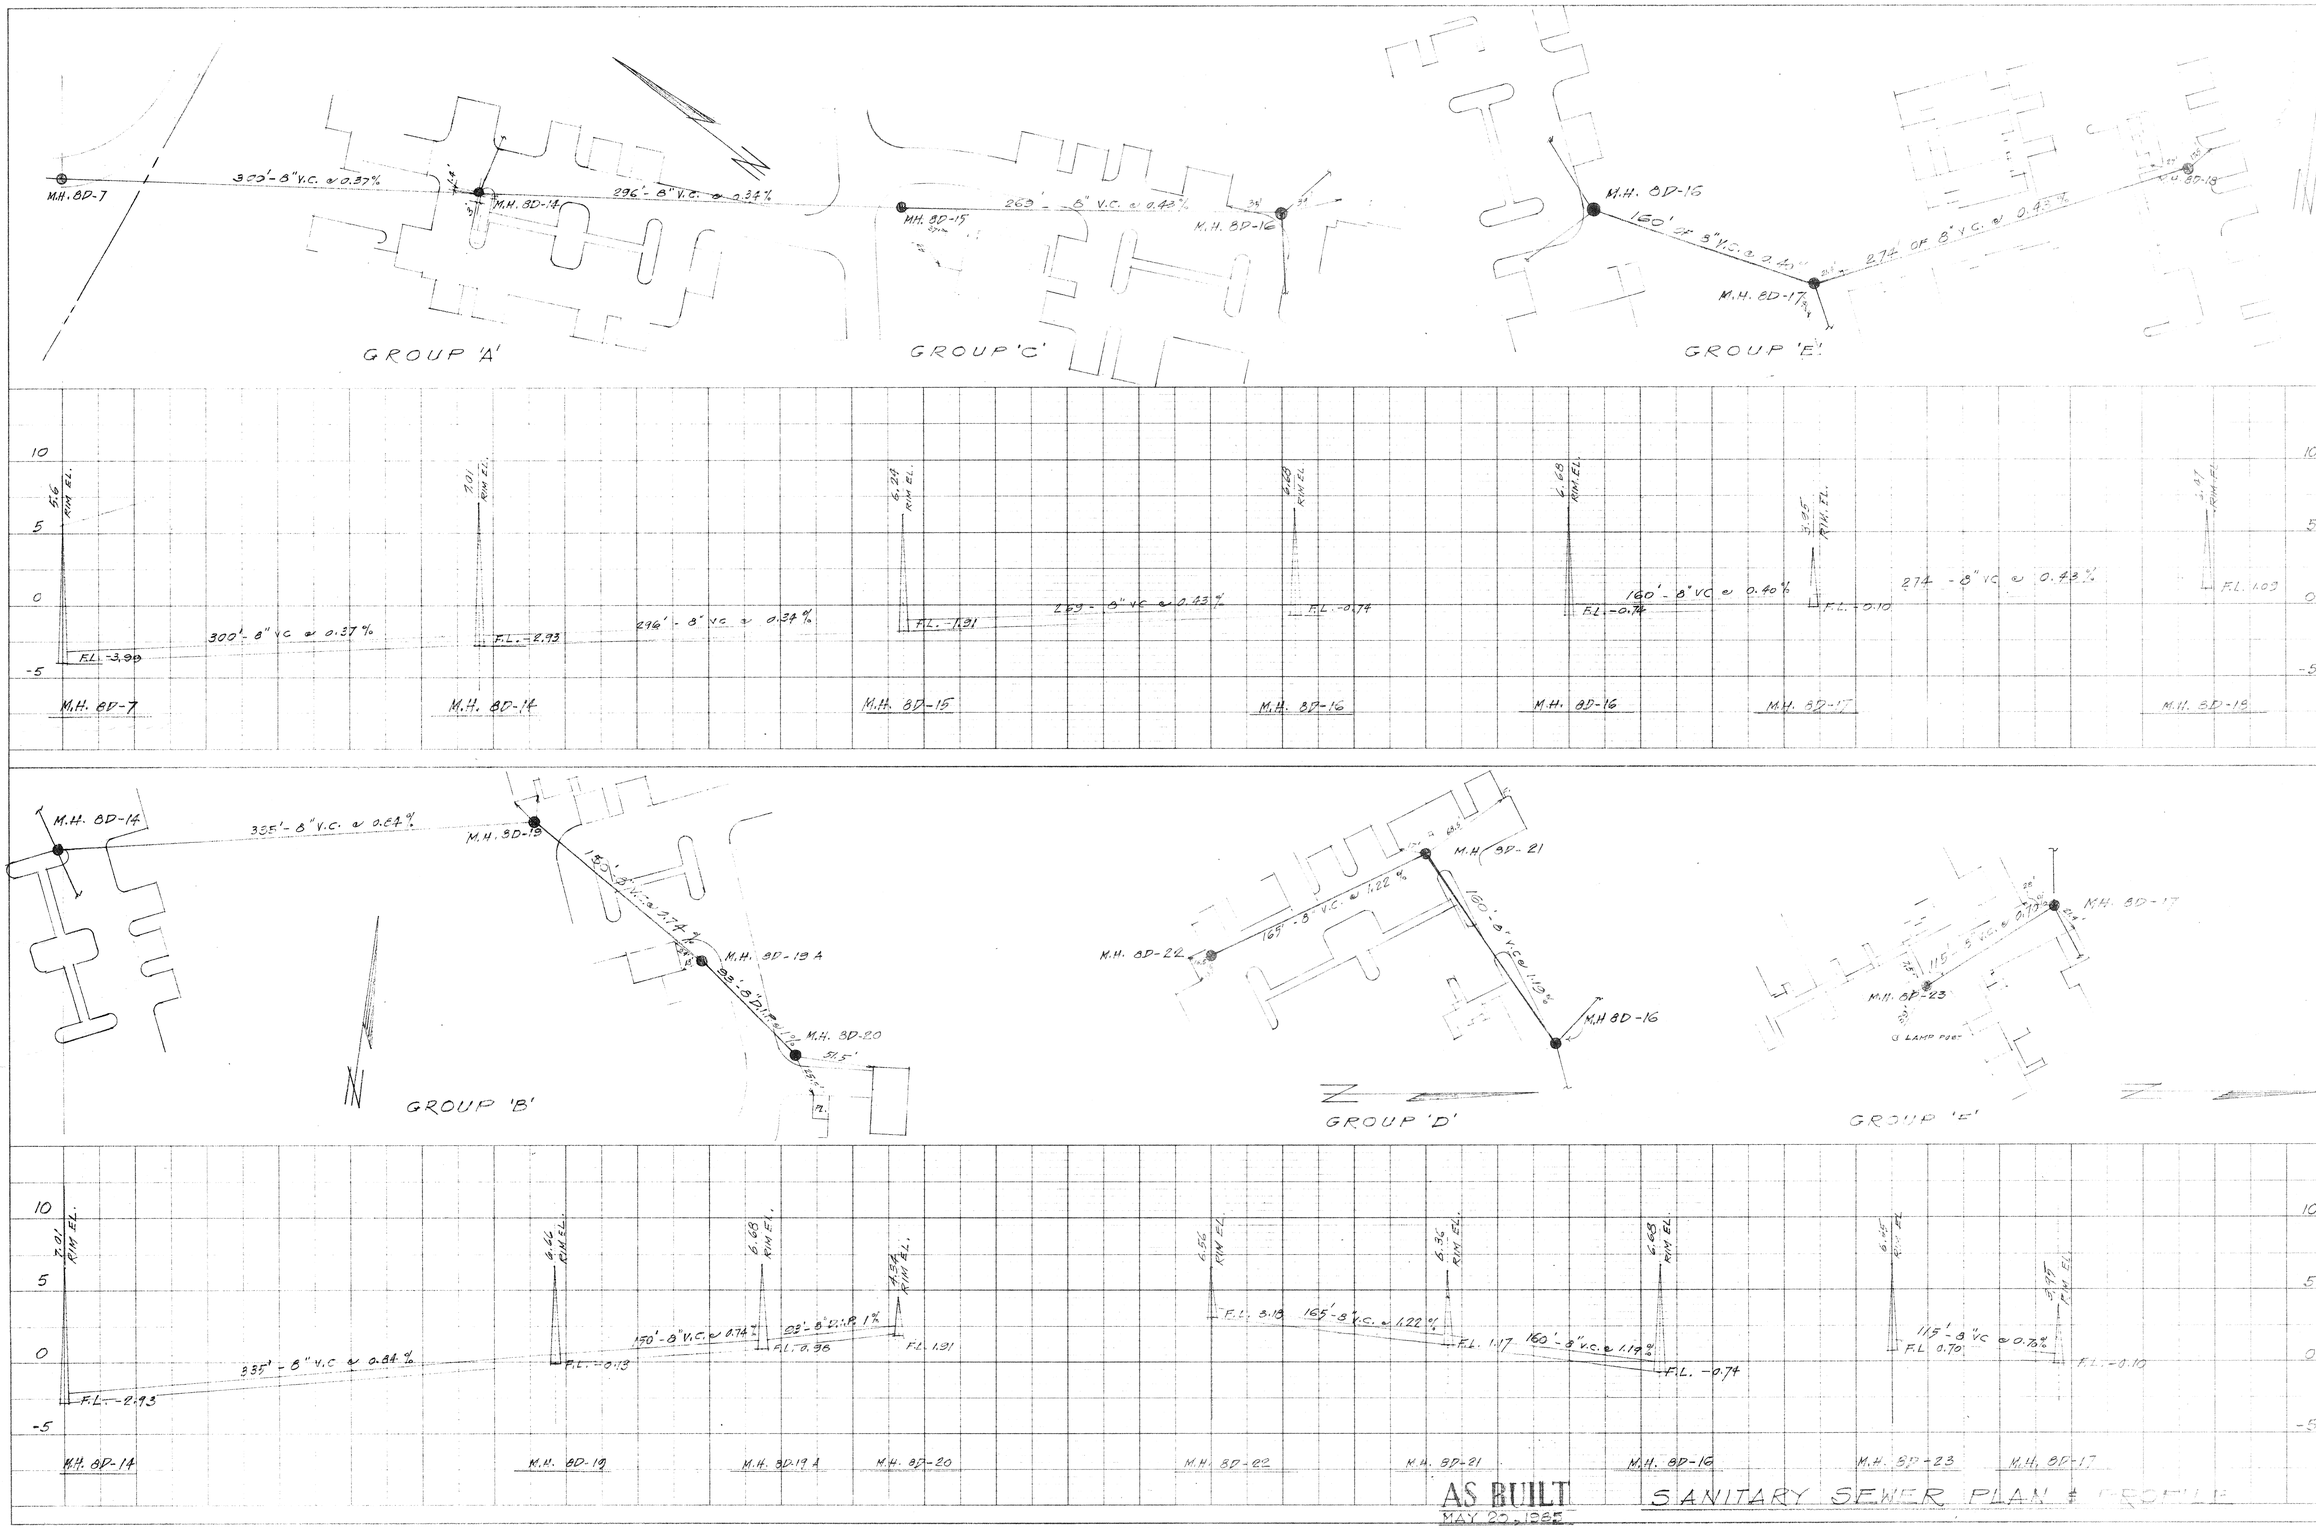

AS BUILT
MAY 20, 1985

SANITARY SEWER PLAN & PROFILE

PLATE 2 PLAN-PROFILE O. P. R. & R. E. STANDARD
100% RAG AGEPROOF VELLUM—MADE AND PRINTED IN U. S. A.
EUGENE DIETZGEN CO.

PLAN
SURVEYED
PLOTTED
NOTE BOOK
ALIGNMENT CHECKED
RT. OF WAY CHECKED
NO.
BY
DATE

PROFILE
SURVEYED
PLOTTED
PROFILE CHECKED
NOTE BOOK
B. M. NOTED
STRUCTURE NOTE NO. CH. NO.
NO.
BY
DATE

TOWN OF LONGBOAT KEY, FLORIDA
BAYPORT BEACH & TENNIS CLUB
ALBERT L. CONYERS
CONSULTING ENG. PE
BEWARE & JAEBERT
ARCHITECT & PLANNER-ATA
REGISTER
LOCATION

DESIGNED BY
PROJECT ENGINEER
DATE 6.22.84
CHECKED BY
PROJECT NO.
SCALE 1" = 50' HORIZ. 1" = 5' VERT.
DRAWN BY E. I.
BY
REVISION
LTR.
DATE
4.3.85
SHEET NUMBER
REVISION

BAYPORT BEACH AND TENNIS CLUB