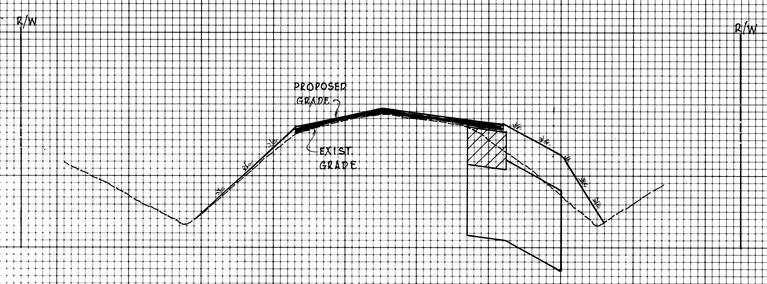

STA. 9+00

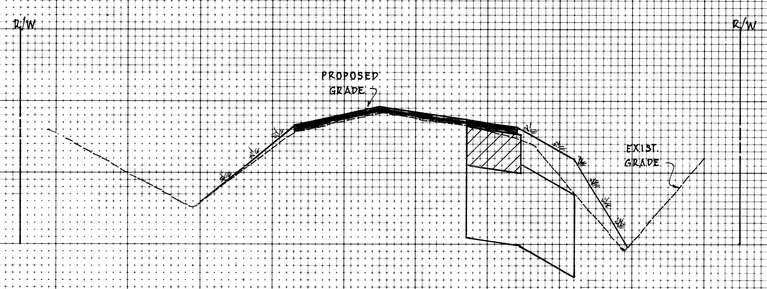

STA. 8+00

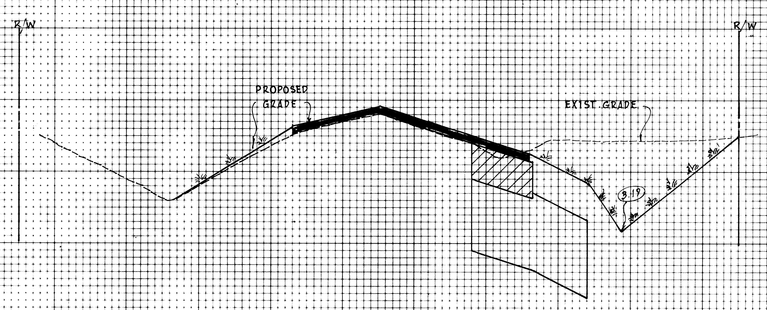

STA. 7+00

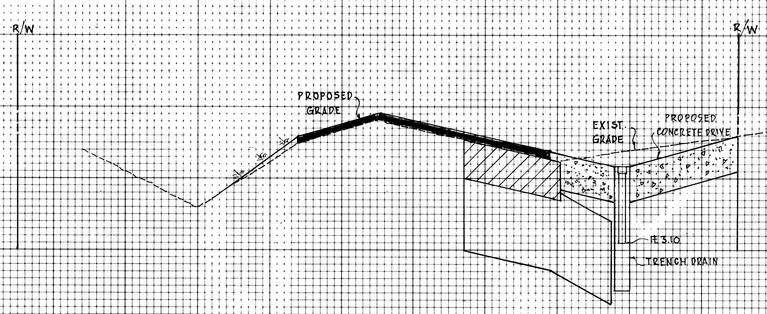

STA. 6+00

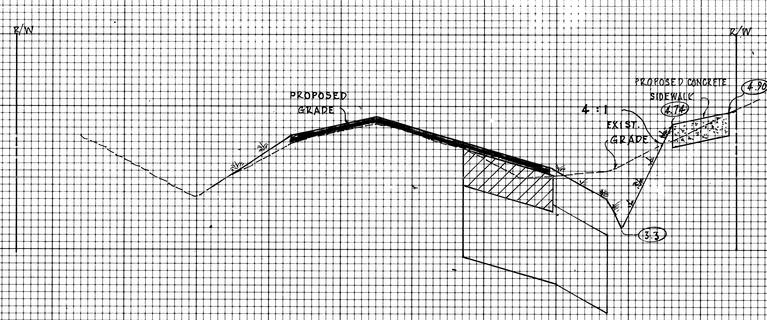

STA. 5+00

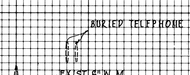

RECORD DRAWING

FOR: RIVIERA CORPORATION	LTR.	DATE	REVISION	BY	SCALE: HOR. 1" = 10' VERT. 1" = 1'	DATE: DEC., 1988	DESIGNED BY M.J.Y./CL.	6/12/91
BEACH WALK CONDOMINIUM	A	2/8/89	GENERAL REVISION	CL/EF	DRAWN BY E.P.	CHECKED BY	PROJECT NO. 2499	MILLARD J. YODER, P.E., FLA. CERT. NO. 33765
CROSS-SECTIONS STA.5+00 TO 9+00	b	11/6/89	ADD SIDEWALK STA. 5+00	MY/EF				
	C	9/10/90	REVISED STA. 5+00, 6+00, 7+00	MY/EF				
	D	3/16/91	STA. 5+00: MOVE SIDEWALK 1' TO R/W	MY/EF				

REVISION D — DRAWING NUMBER 8

SMALLY, WELLFORD & NALVEN, Inc. — CONSULTING ENGINEERS & SURVEYORS — 133 SOUTH McINTOSH RD. — SARASOTA, FLA. 33582

BEACHWALK

INDEX NO. G-2499-017