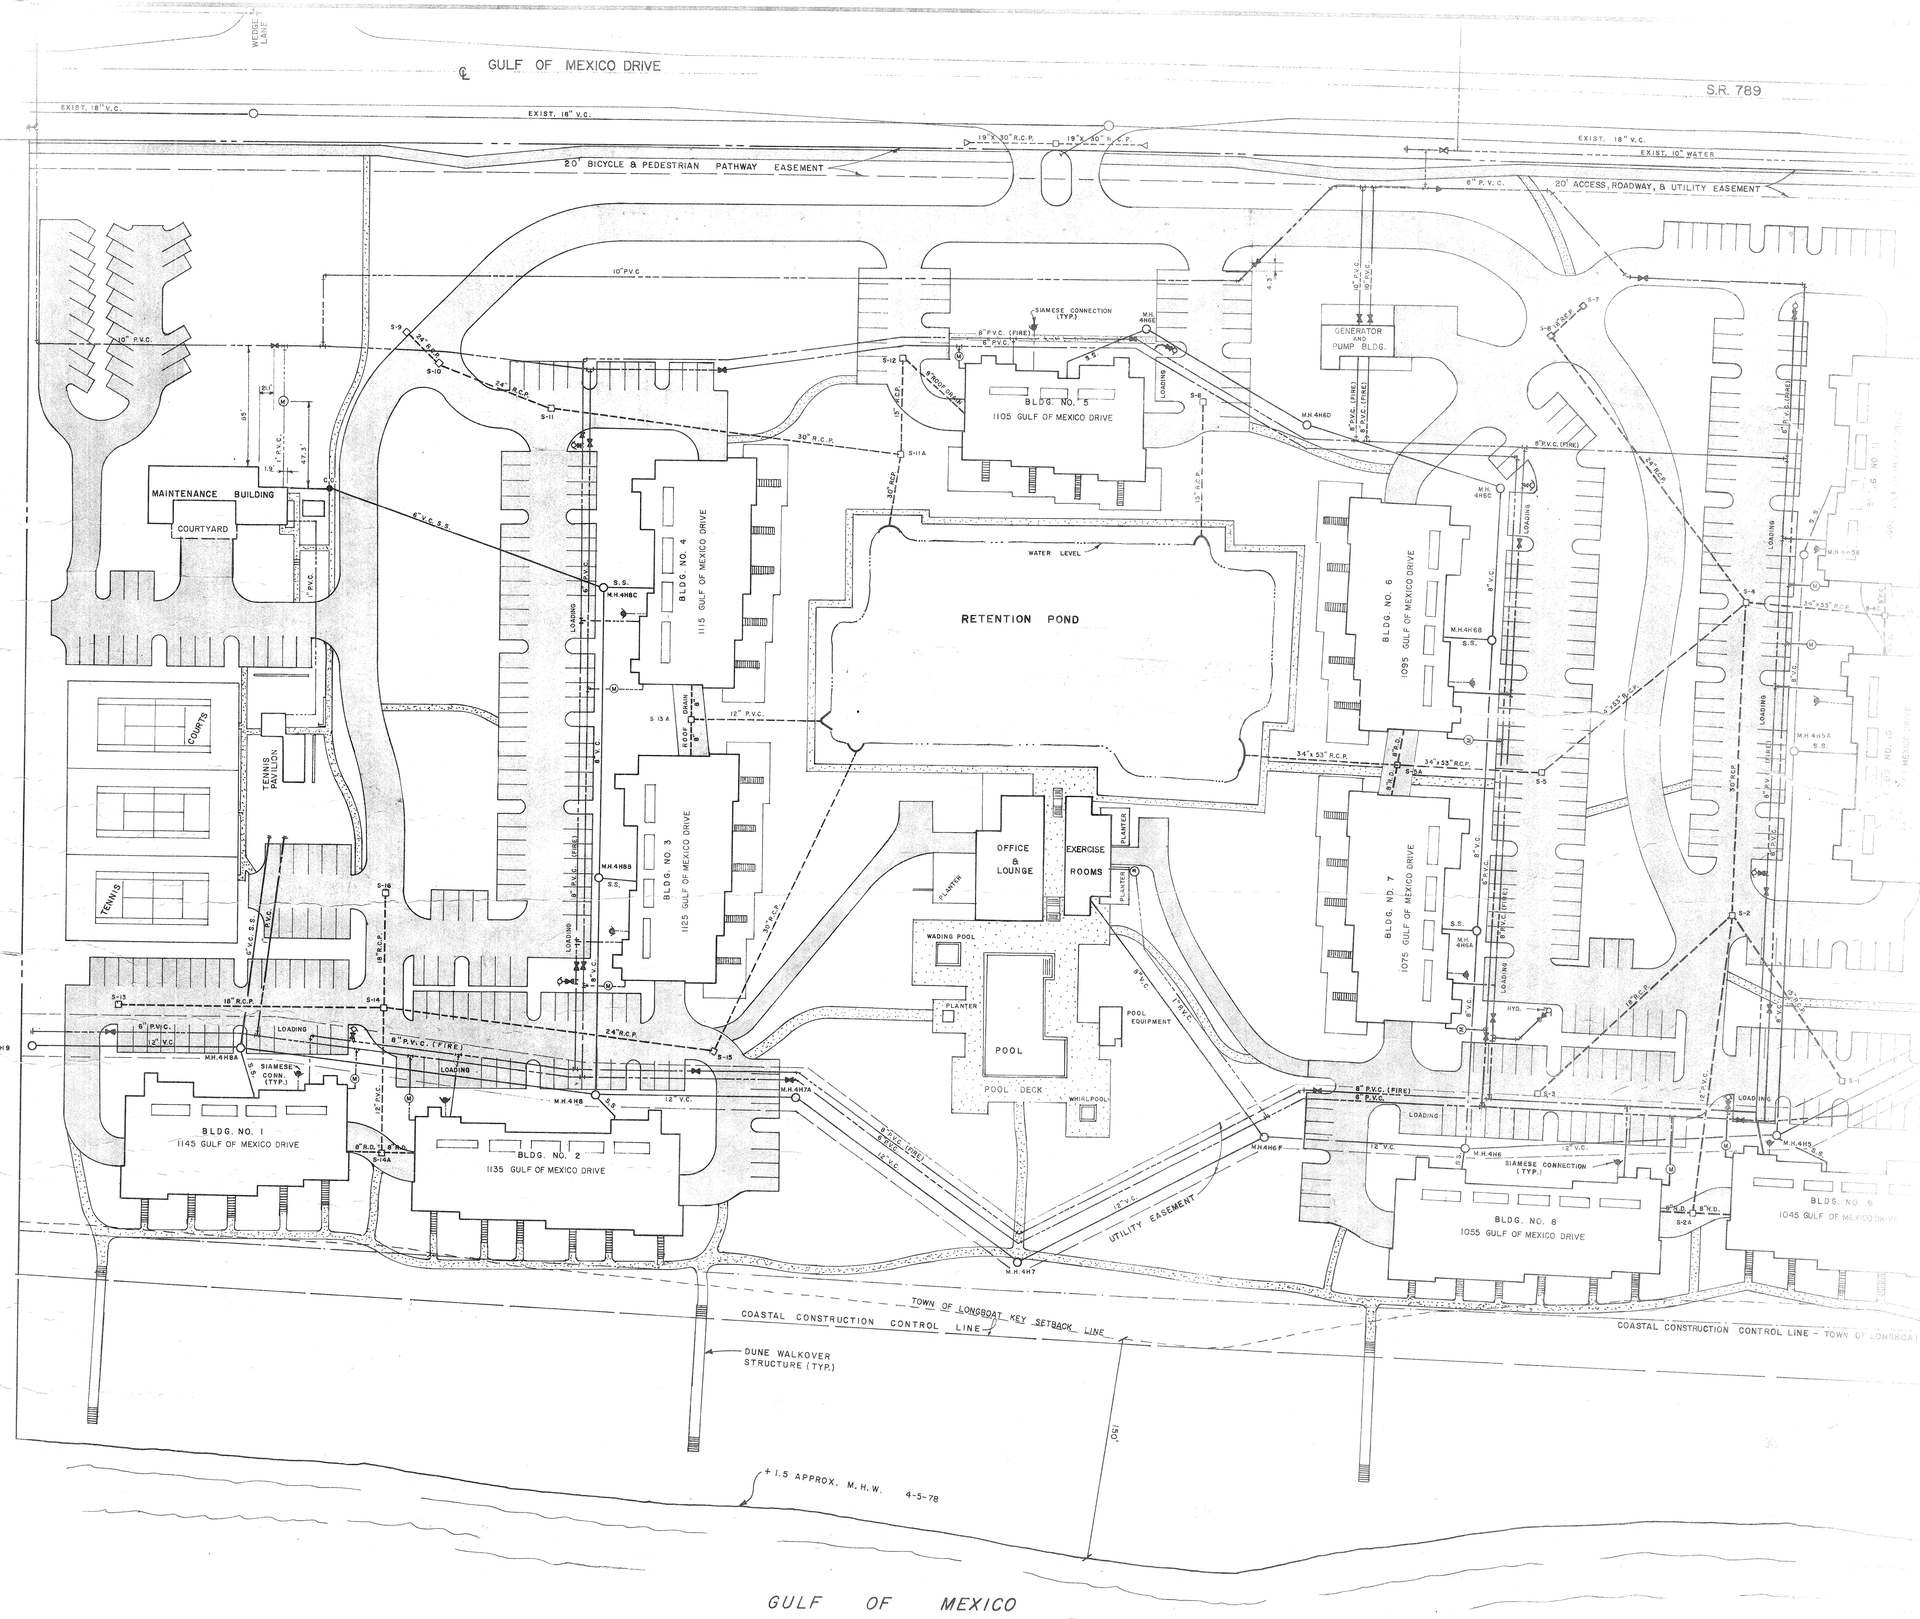

TOWN OF LONGBOAT KEY, FLORIDA

ARVIDA CORPORATION

BEACHPLACE AS-BUILT

ENGINEER BENNETT & BISHOP, INC. ENGINEERS & SURVEYORS 4509 BEE RIDGE ROAD SARASOTA, FLORIDA

DATE 2-8-1978

SHEET NUMBER 250-021 AB

REVISION