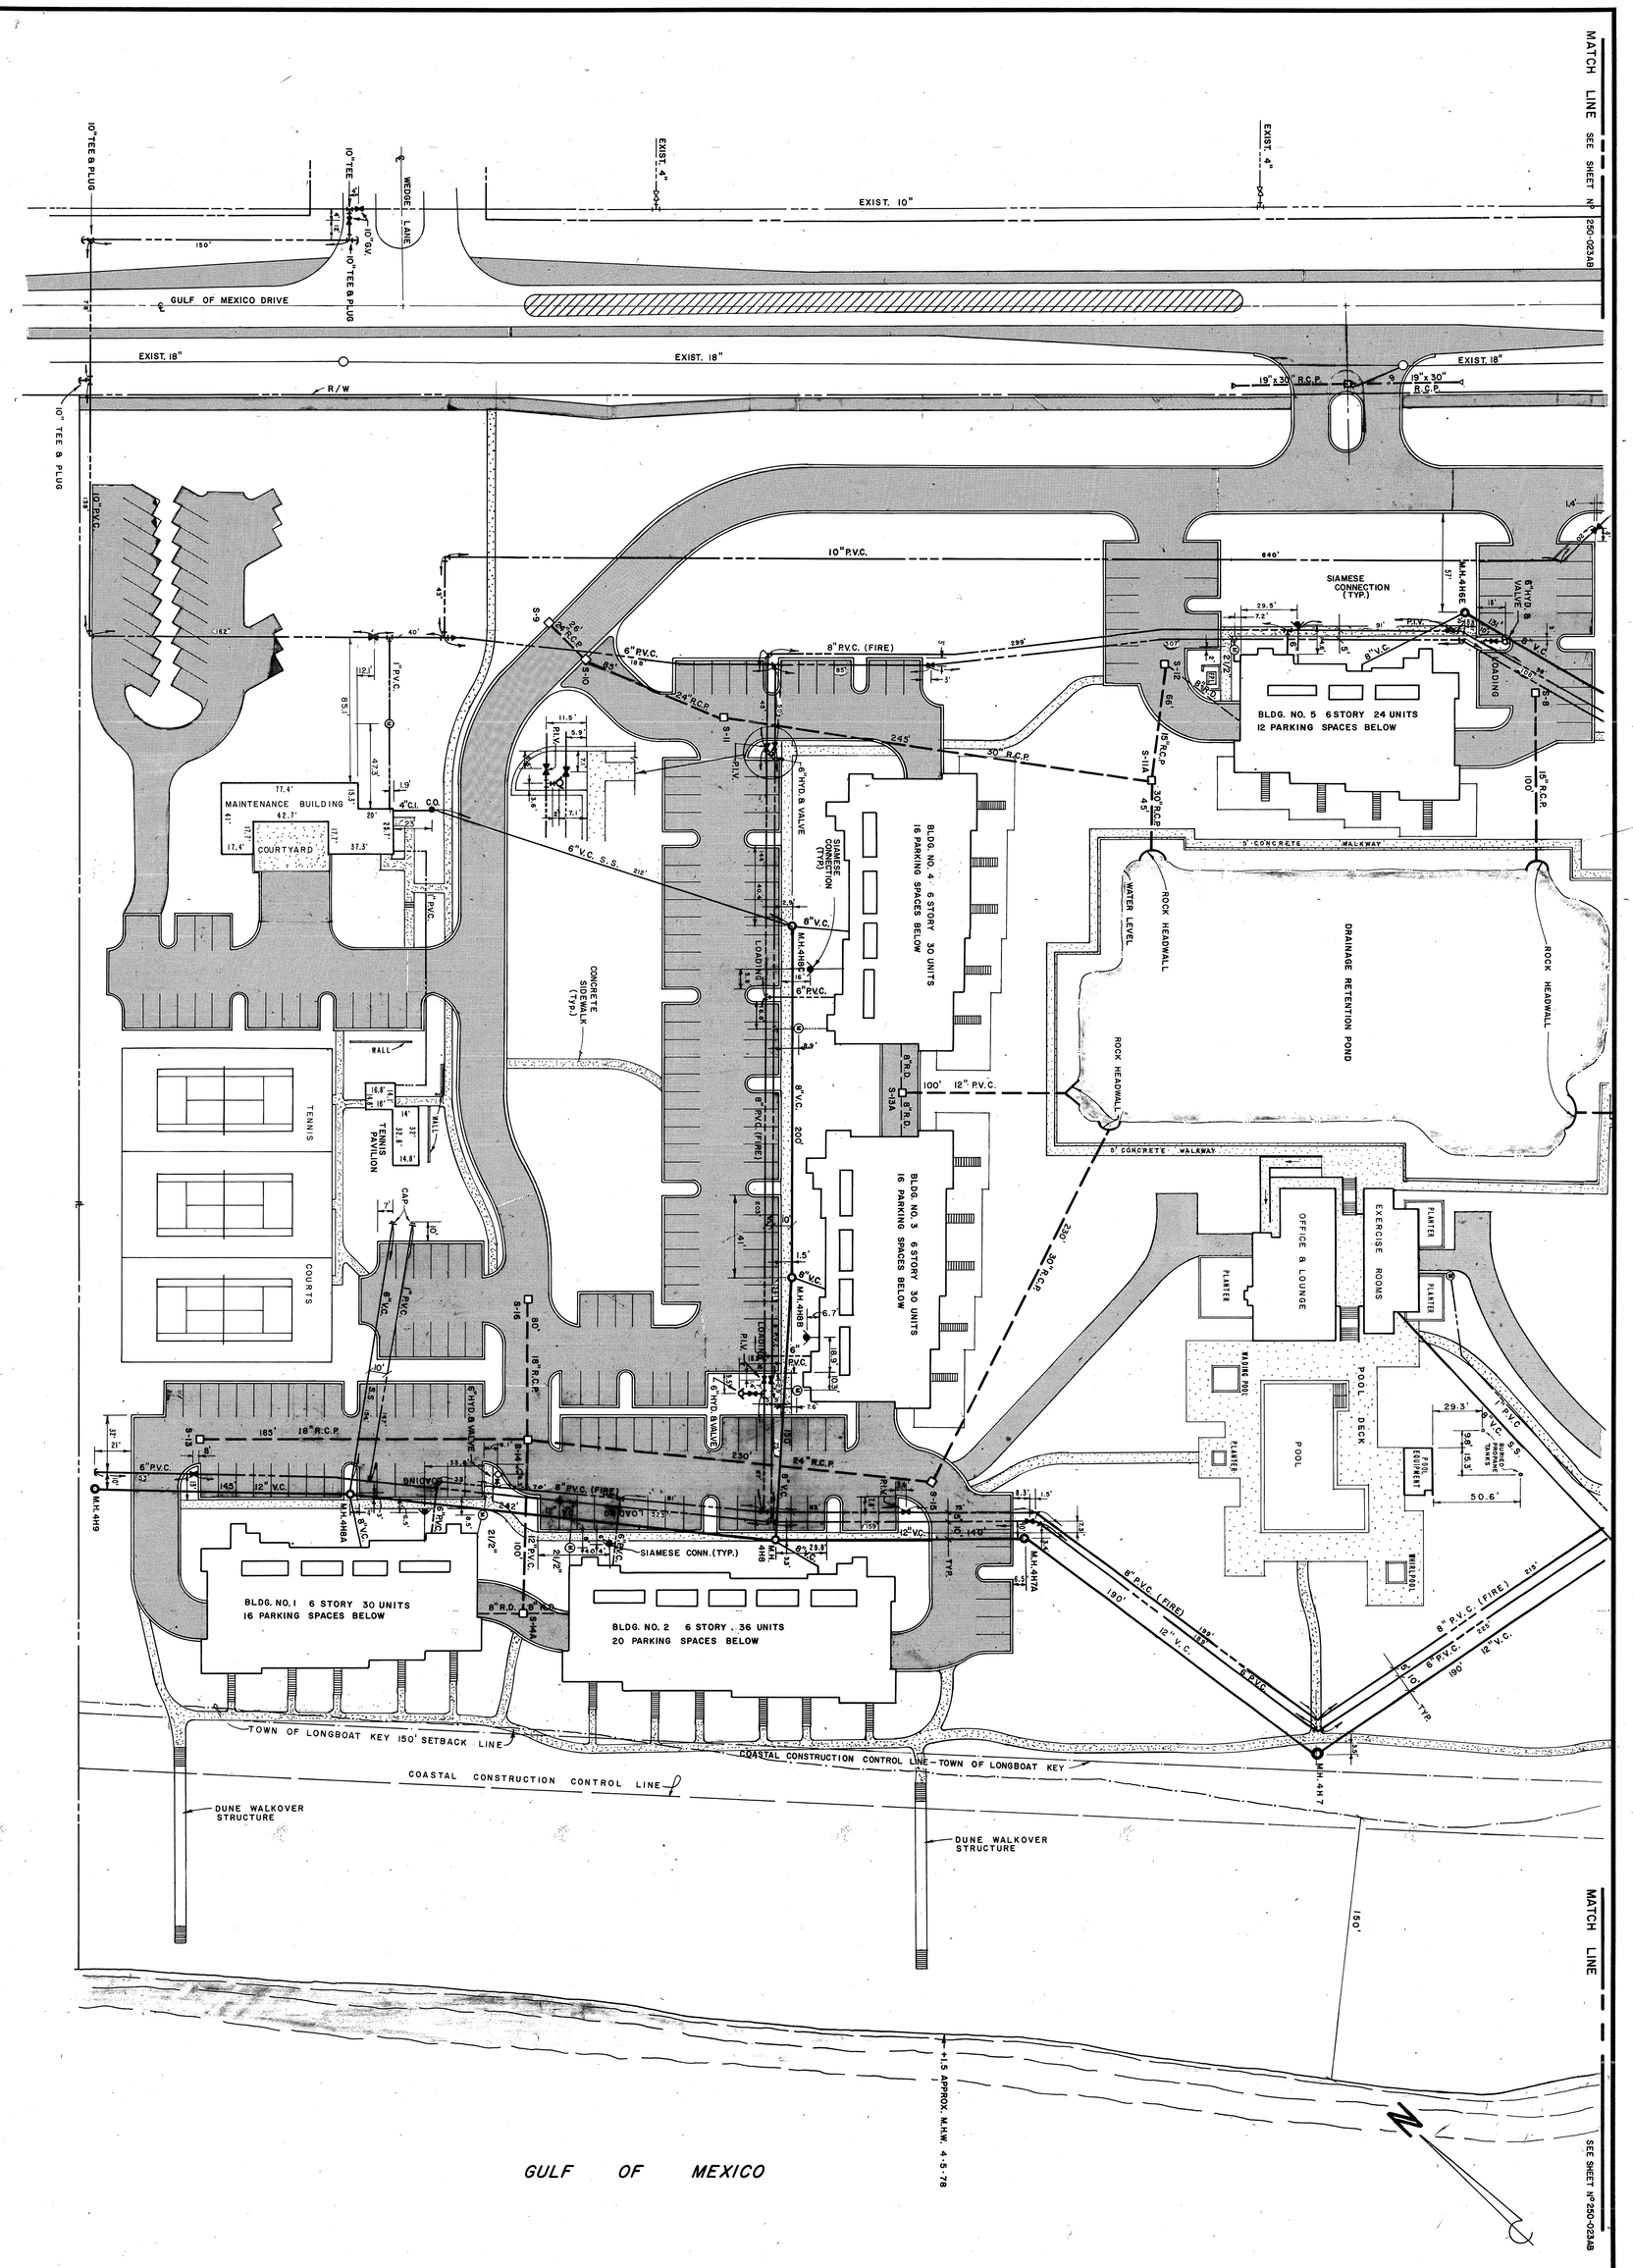

REVISION	SHEET NUMBER	TOWN OF LONGBOAT KEY, FLORIDA	LTR.	DATE	REVISION	BY	SCALE: 1" = 40'	DATE: 8-10-81	DESIGNED BY M. W.	PROJECT ENGINEER
	250-022 AB	ARVIDA CORPORATION BEACHPLACE AS-BUILT					DRAWN BY R.A.BRAND	CHECKED BY	PROJECT NO.	

ENGINEER & LOCATION BENNETT & BISHOP, INC. ENGINEERS & SURVEYORS 4509 BEE RIDGE ROAD SARASOTA, FLORIDA

William C. Bishop #8189

T.L.K. FILE NO.