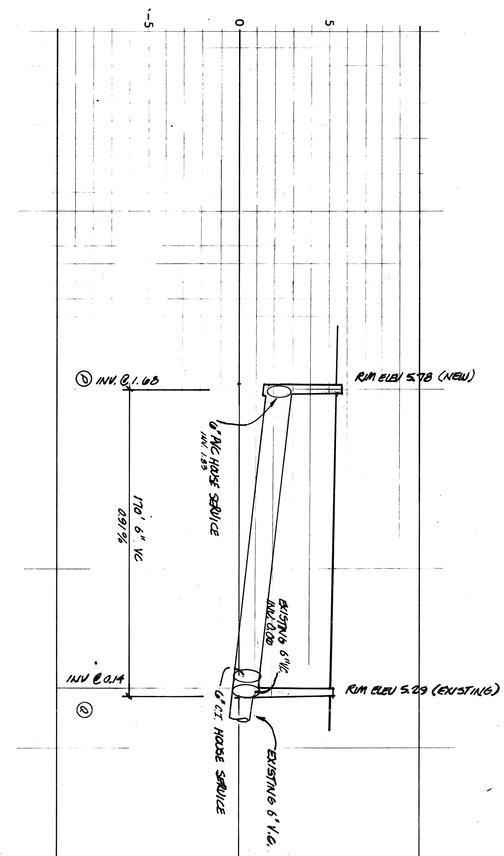



DARRELL E. GERKEN
PROFESSIONAL LAND SURVEYOR
51 Wallace Avenue
Sarasota, Florida 33577
(813) 365-6595


## CERTIFICATE OF SURVEYOR

I, THE UNDERSIGNED REGISTERED LAND SURVEYOR, DO HEREBY CERTIFY THAT THIS PLAT IS A TRUE REPRESENTATION OF THE LANDS DESCRIBED AND SHOWN HEREON ACCORDING TO A SURVEY MADE UNDER MY DIRECTION AND SUPERVISION AND THAT THIS SURVEY MEETS THE MINIMUM TECHNICAL STANDARDS FOR LAND SURVEYING IN THE STATE OF FLORIDA (CHAPTER 21HH-6, F.A.C.)

NOTE: NOT VALID UNLESS IMPRINTED WITH EMBOSSED LAND SURVEYORS SEAL.

DATE OF SURVEY: 7-3-85

Darrell E. Gerken
DARRELL E. GERKEN, REGISTERED LAND SURVEYOR
FLORIDA CERTIFICATE NO. 1747

| REVISION | SHEET NUMBER | TOWN OF LONGBOAT KEY, FLORIDA | LTR. | DATE | REVISION | BY | SCALE: 1"=40' HORZ 1"=4' VERT | DATE: 7/4/85 | DESIGNED BY | PROJECT ENGINEER |
|---|---|---|---|---|---|---|---|---|---|---|
| | 3 | HARBOUR VILLA CLUB AT THE BUCCANEER A CONDOMINIUM<br>AS BUILT SANITARY SEWER PROFILES | | JULY 25, 85<br>JULY 29, 85 | CHANGED 6" HOUSE SERVICE<br>ADDED % OF GRADE, CH'D 8" V.C. TO 8" C.I., ADDED V.C. TO EXISTING 6", CH'D PVC TO VC | | DRAWN BY | CHECKED BY HRL | PROJECT NO. 5-83-10-04-C | |
| | | ENGINEER & LOCATION | | | | | | | | |
| T.L.K. FILE NO. | | | | | | | | | | |