



VROOM DEVELOPMENT (FLA.) INC.

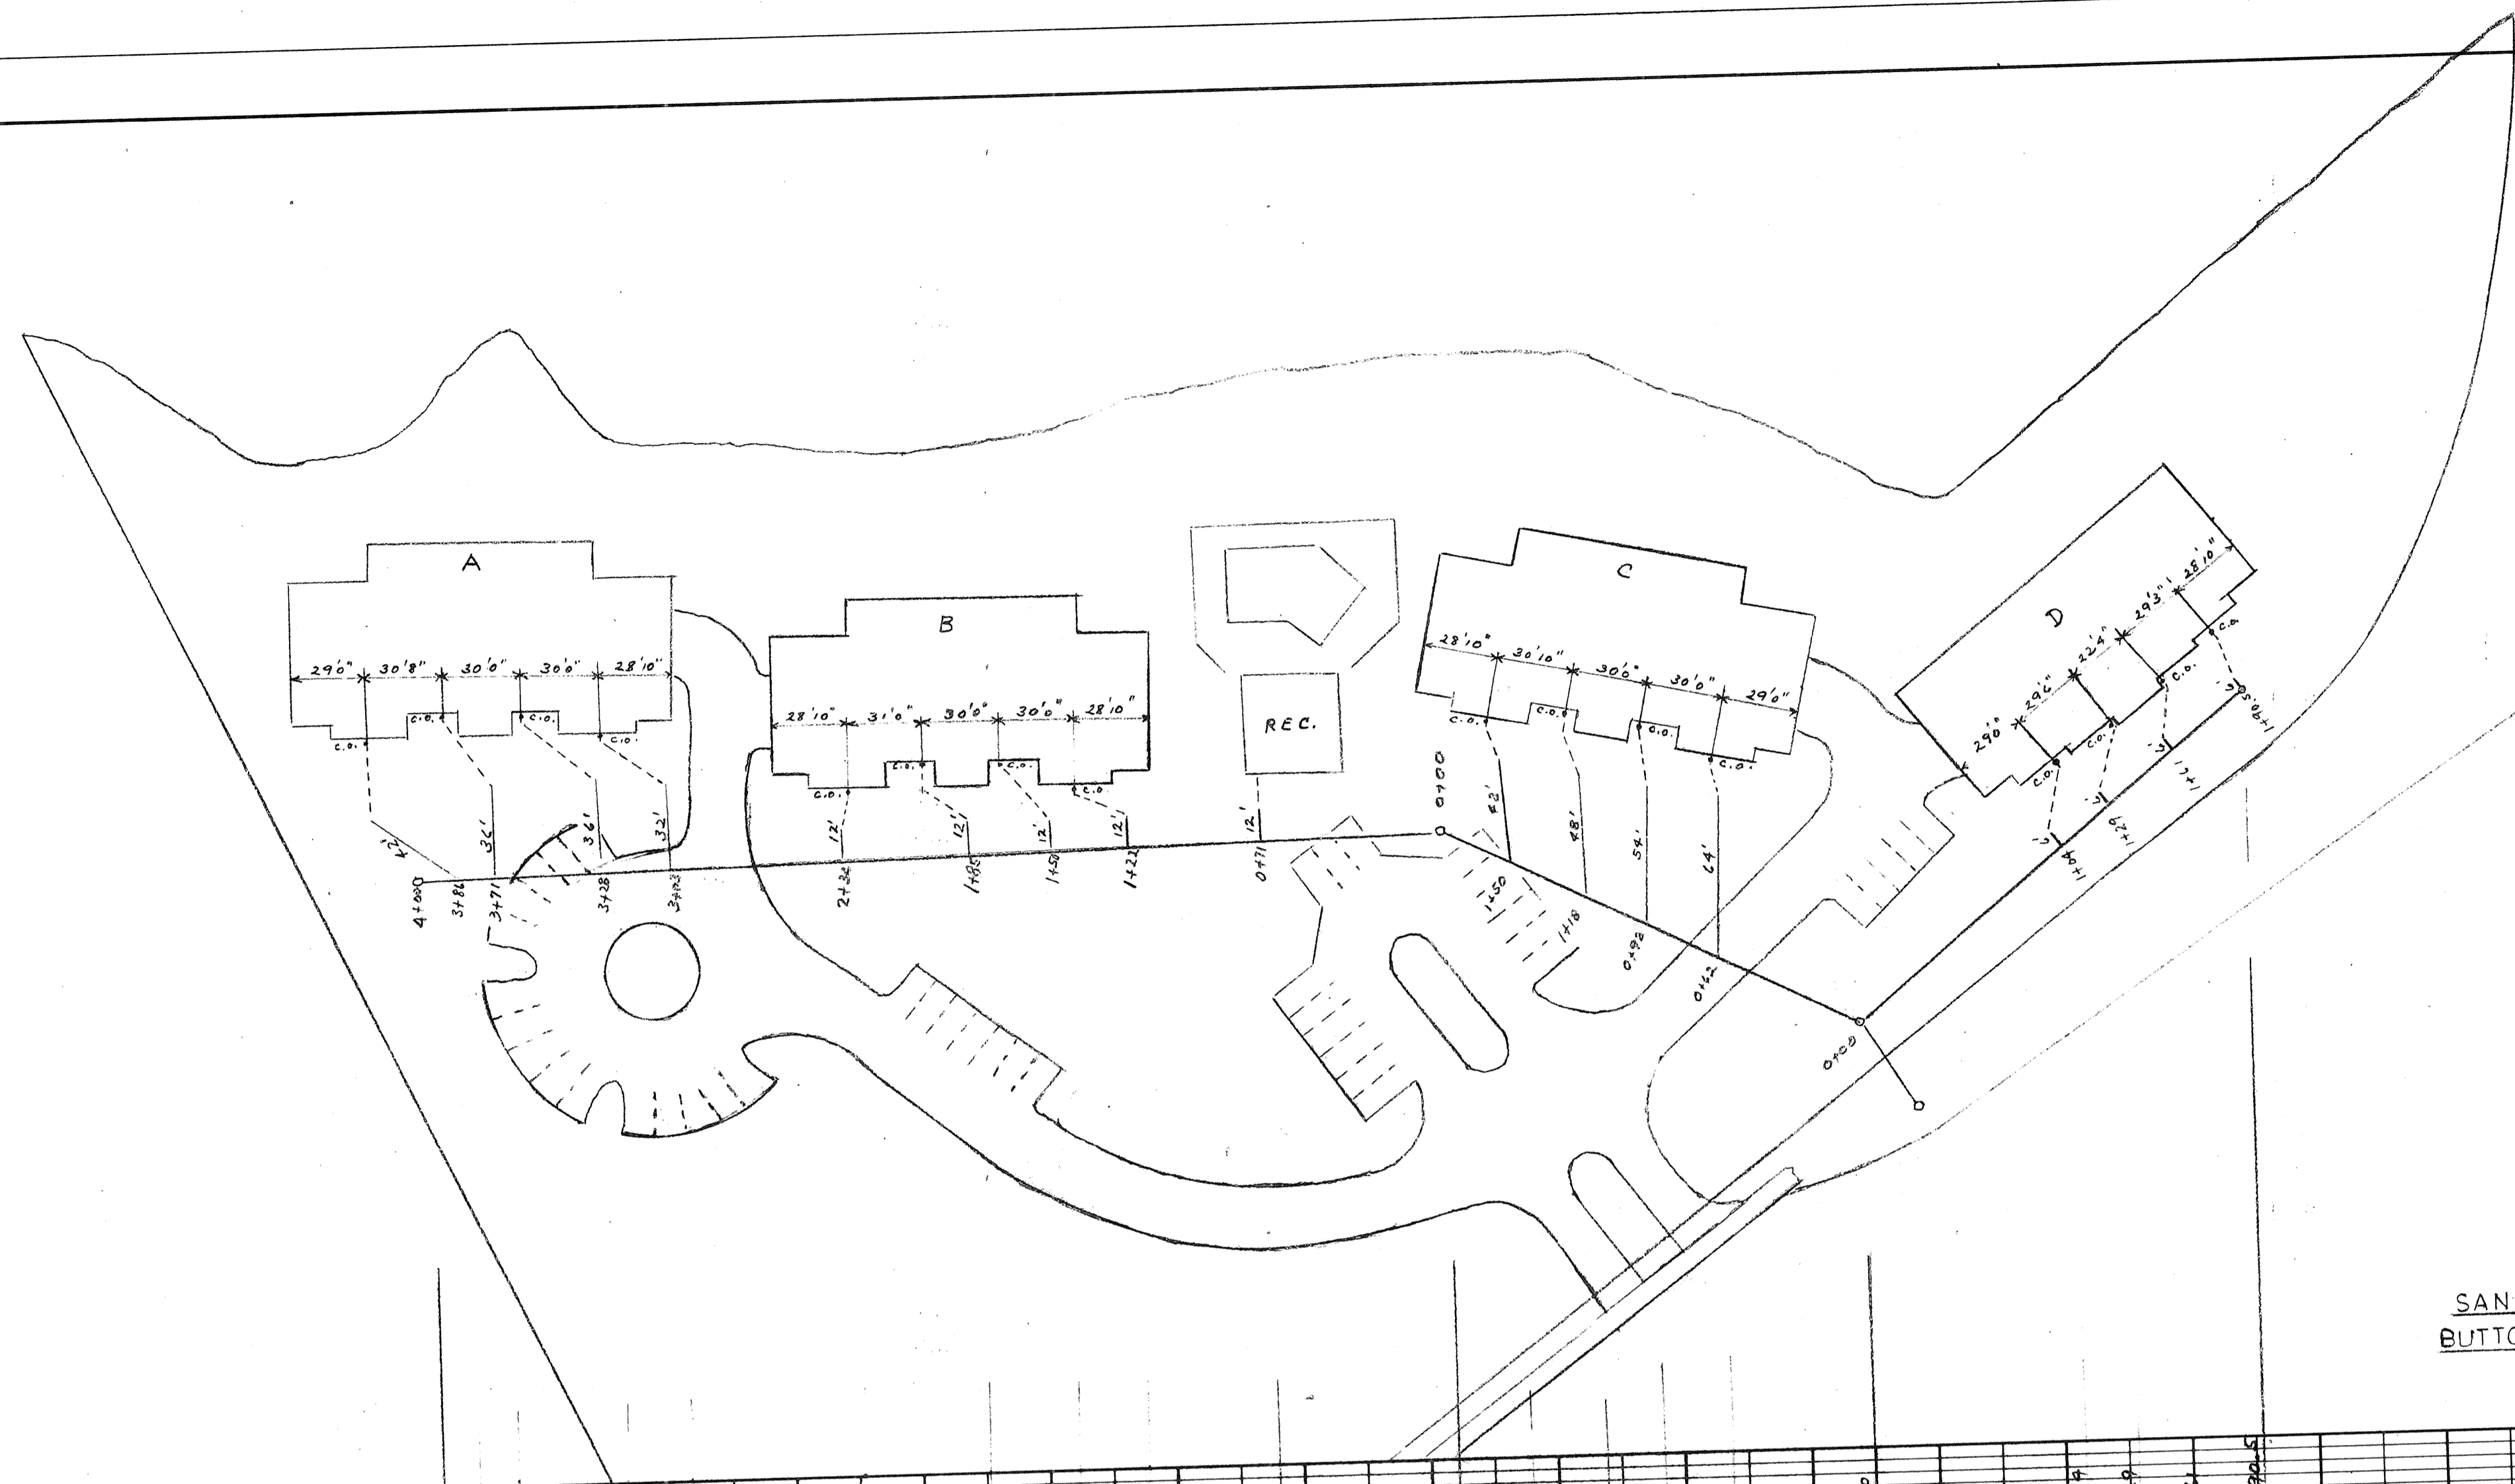

SANITARY SEWER
BUTTONWOOD COVE

SCALE:
HORZ. 1" = 50'
VERT. 1" = 2'

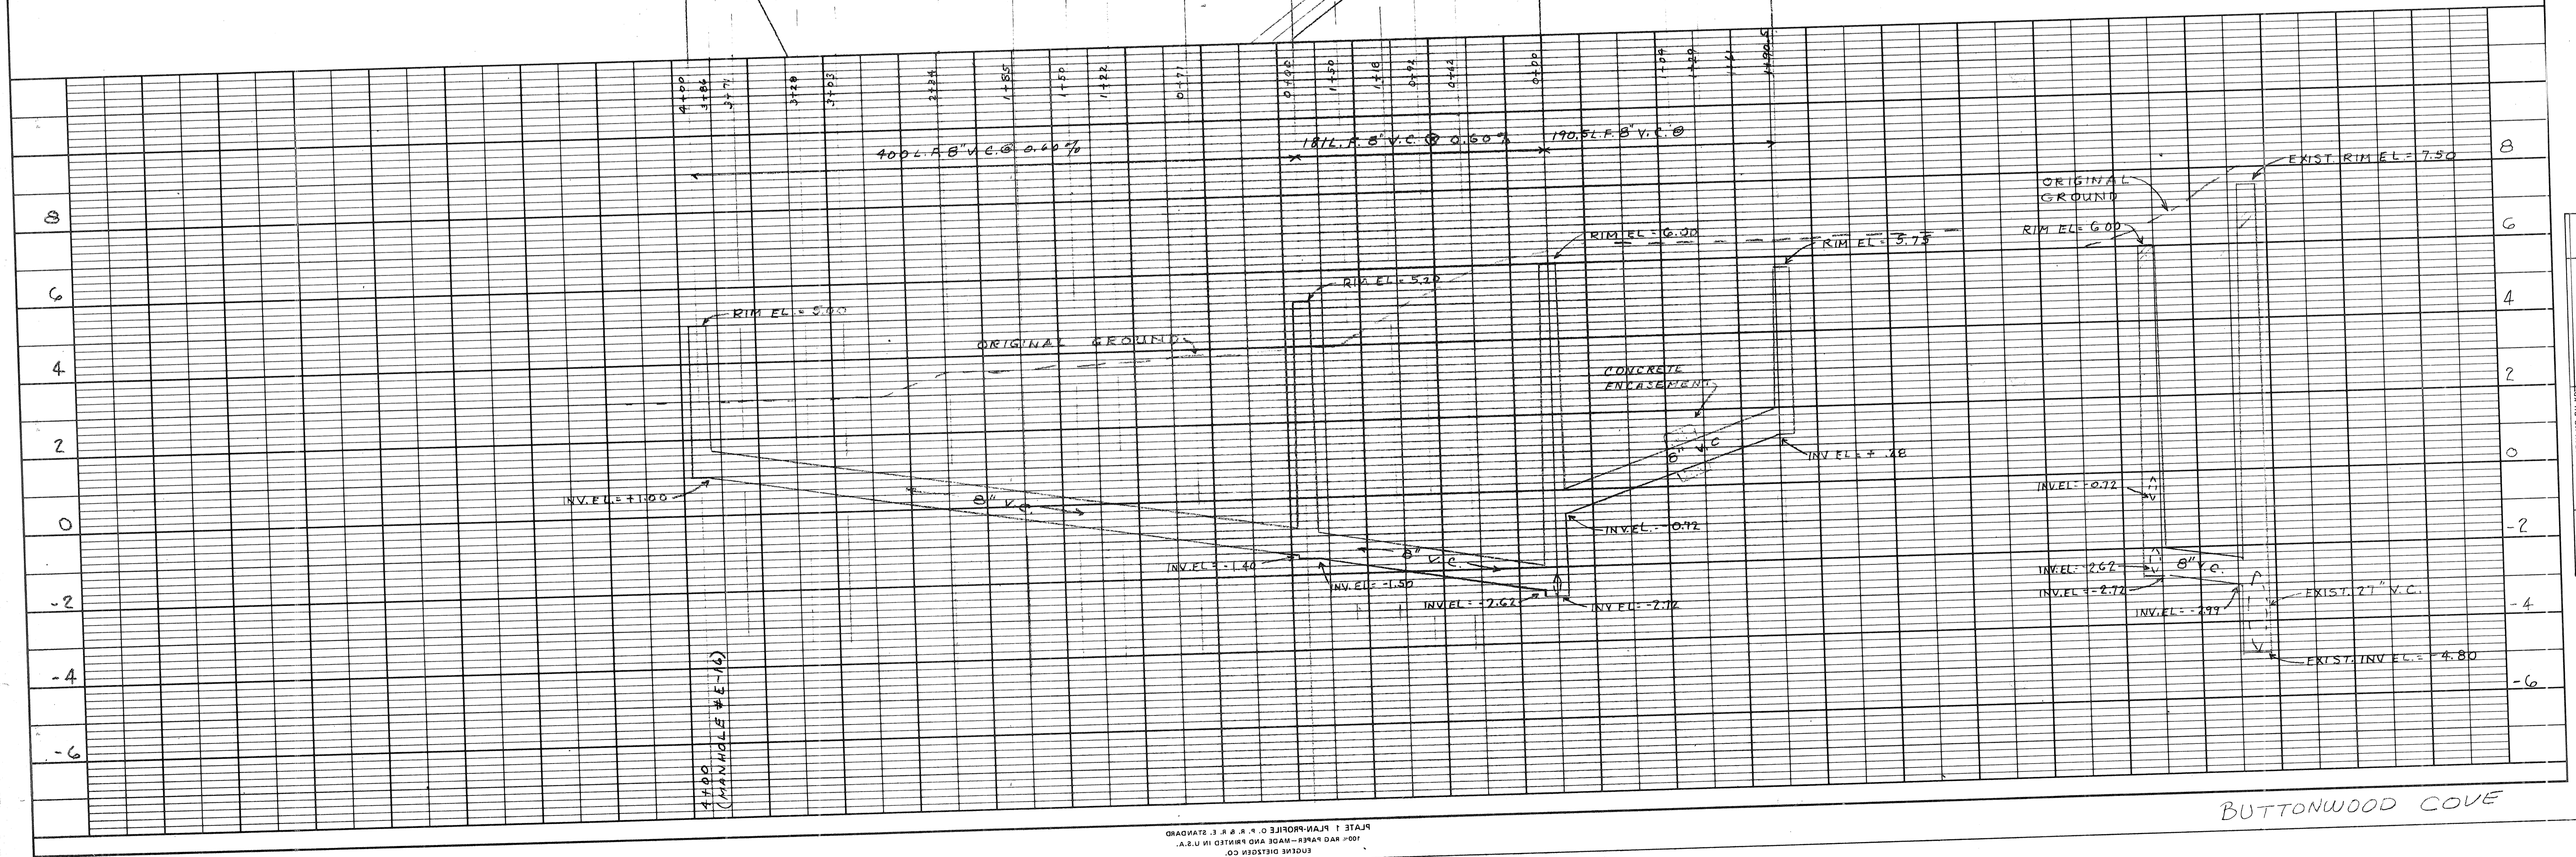


BUTTONWOOD COVE


BUTTONWOOD COVE