



SCALE: 1"=30'

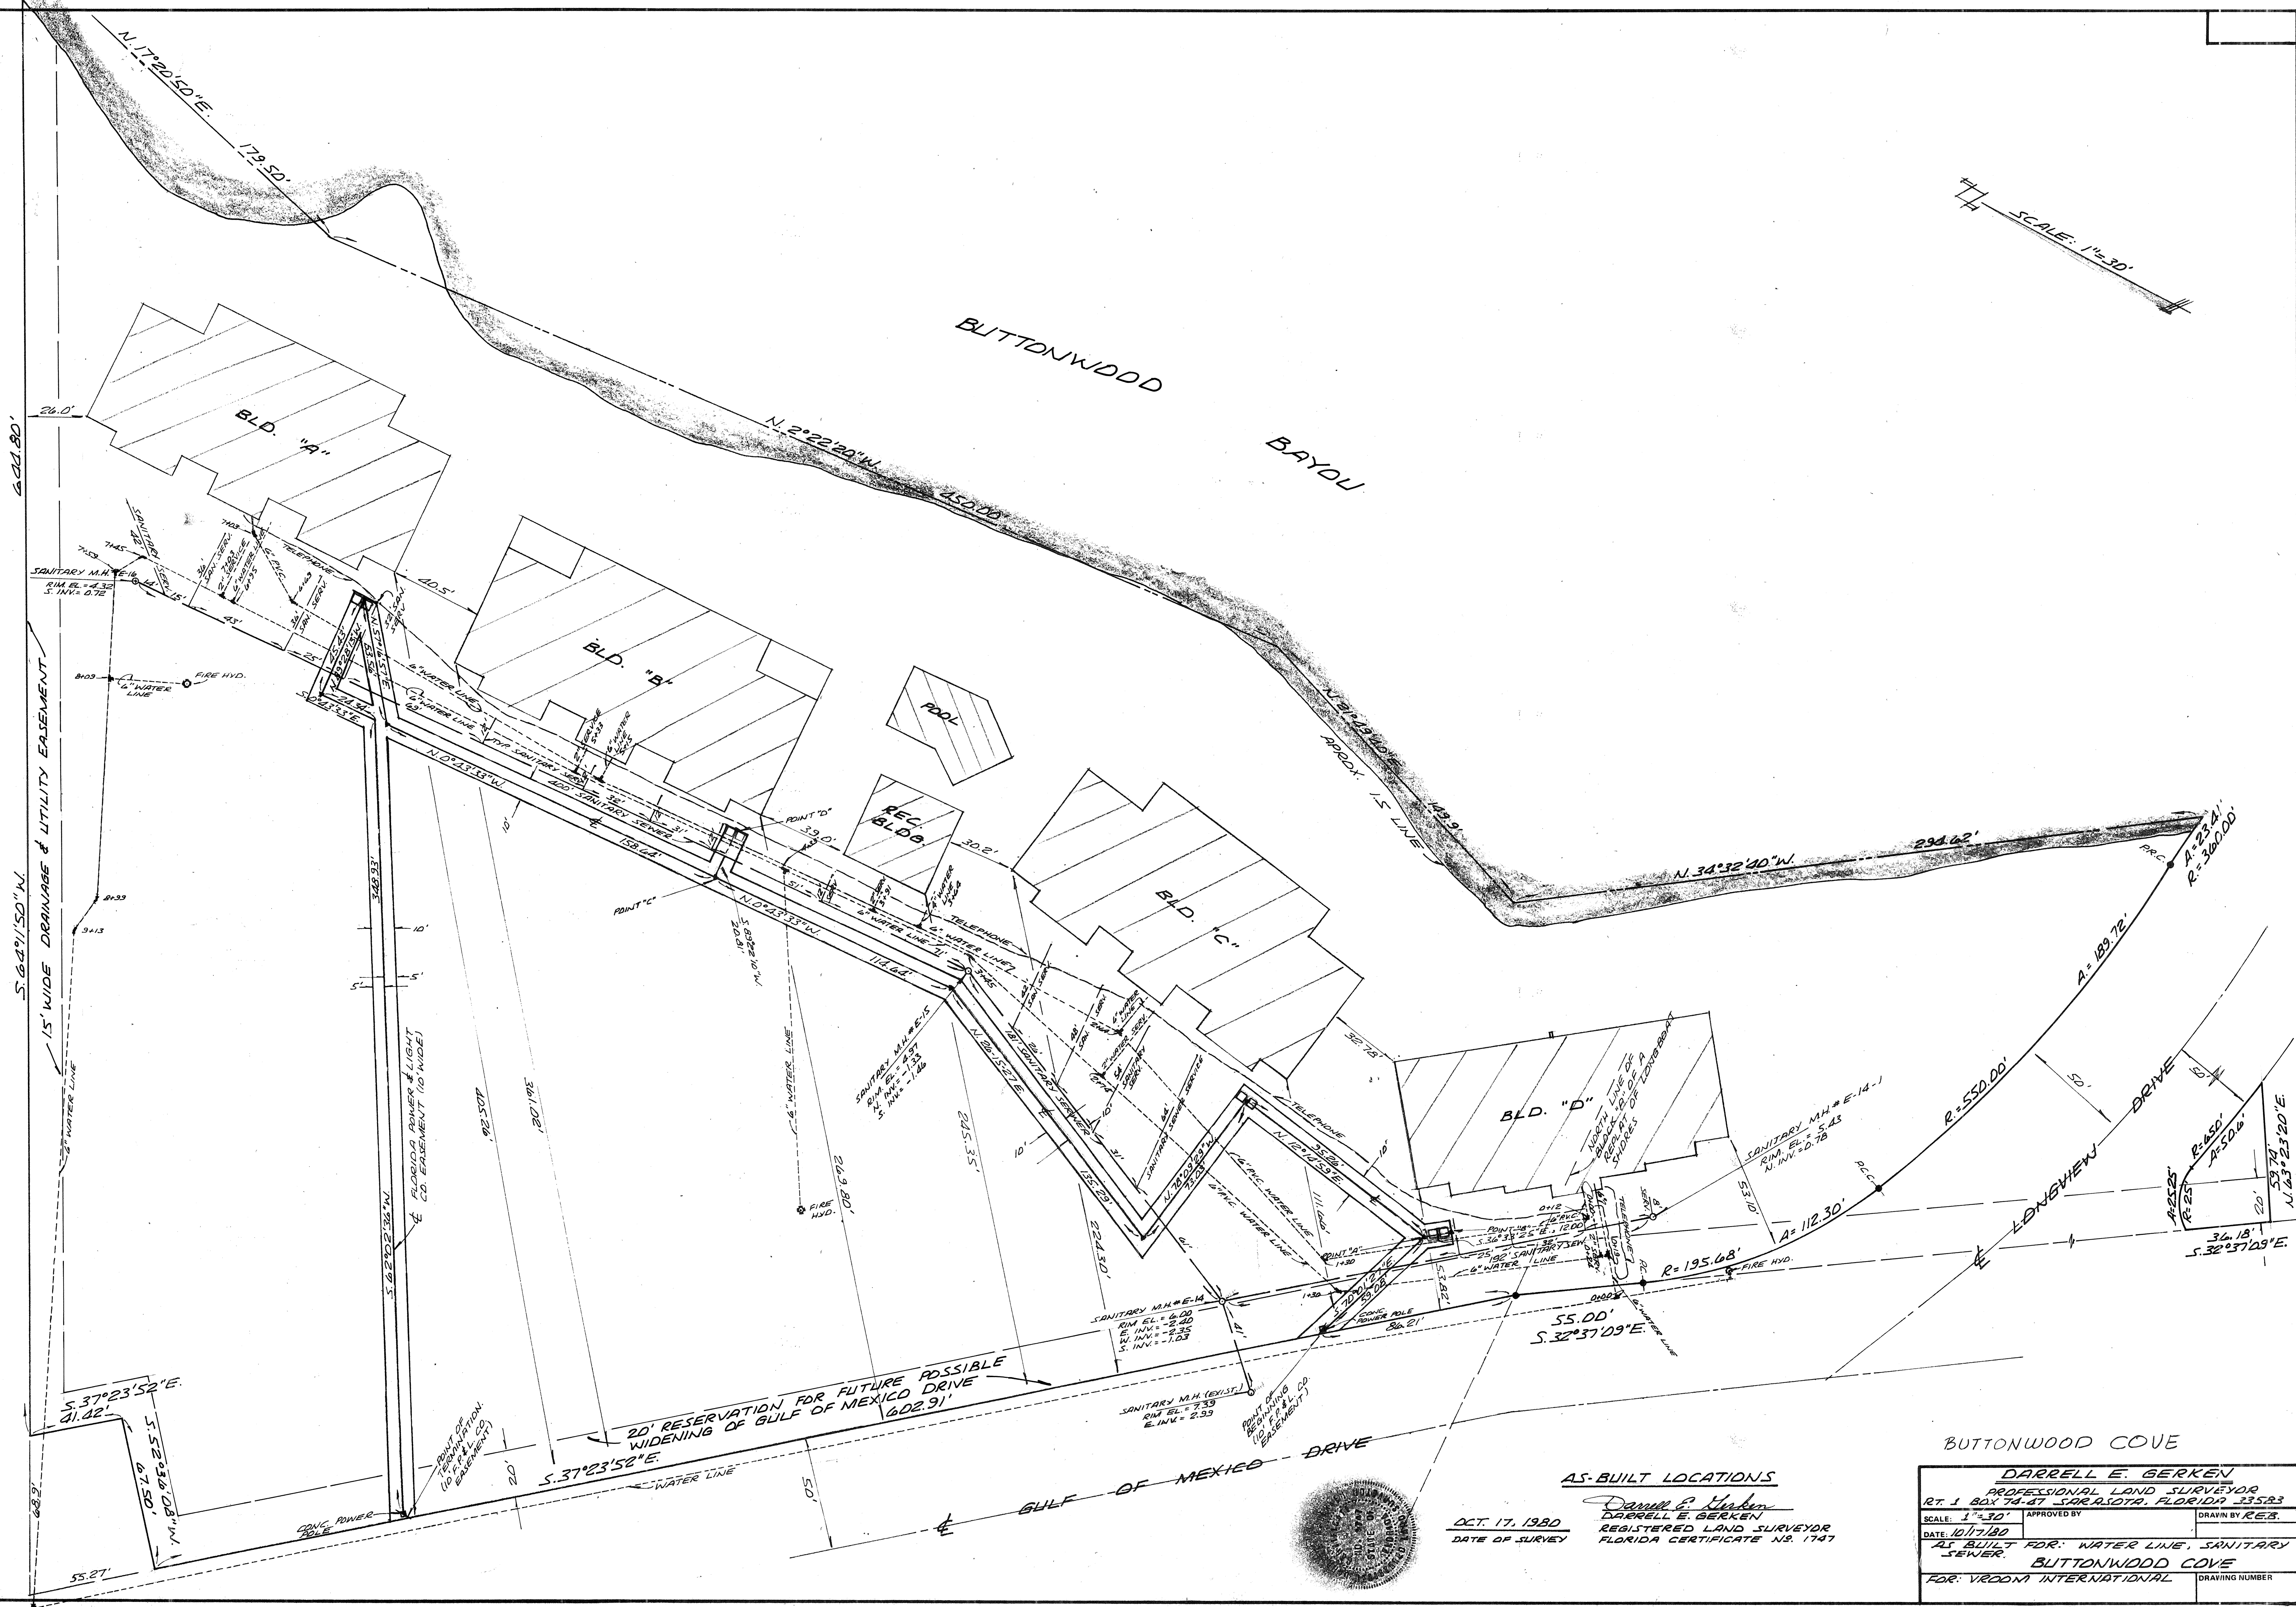

AS-BUILT LOCATIONS
 Darrell E. Berken
 Darrell E. Berken
 REGISTERED LAND SURVEYOR
 FLORIDA CERTIFICATE NO. 1747

OCT. 17, 1980
 DATE OF SURVEY

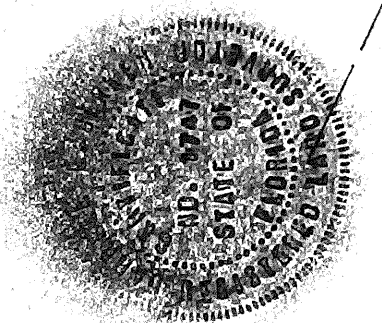

BUTTONWOOD COVE	
DARRELL E. BERKEN	
PROFESSIONAL LAND SURVEYOR	
SCALE: 1"=30'	APPROVED BY
DATE: 10/17/80	DRAWN BY: RES.
AS BUILT FOR: WATER LINE, SANITARY SEWER.	
BUTTONWOOD COVE	
FOR: VRODA INTERNATIONAL	DRAWING NUMBER