
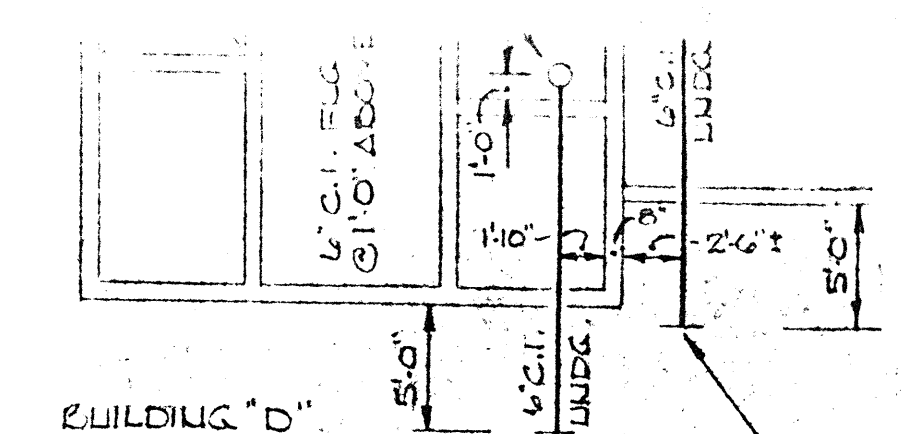


BUTTONWOOD


BAYOU

GENERAL NOTE:



O.A.S.I. TO BEGIN WORK FROM 6" OUTLETS PROVIDED BY OTHERS. OUTLET IS TO BE LOCATED AT A POINT 5'-0" OUTSIDE OF BUILDING LINE. (TYP. FOR BUILDINGS A, B, C, D, & RECREATION BUILDING) LOCATION OF OUTLET TO BE DETERMINED BY O.A.S.I.

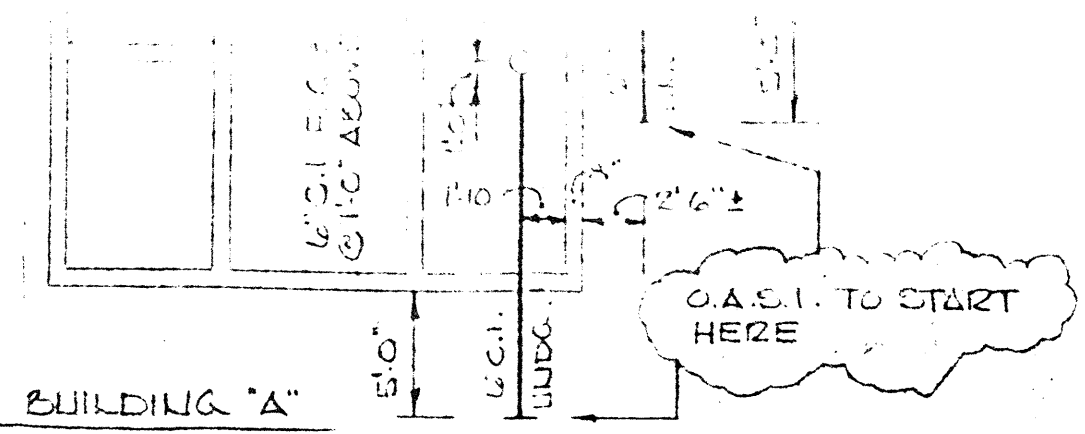

UNDERGROUND LEAD-IN DETAILS SCALE: 1/8"=1'-0"





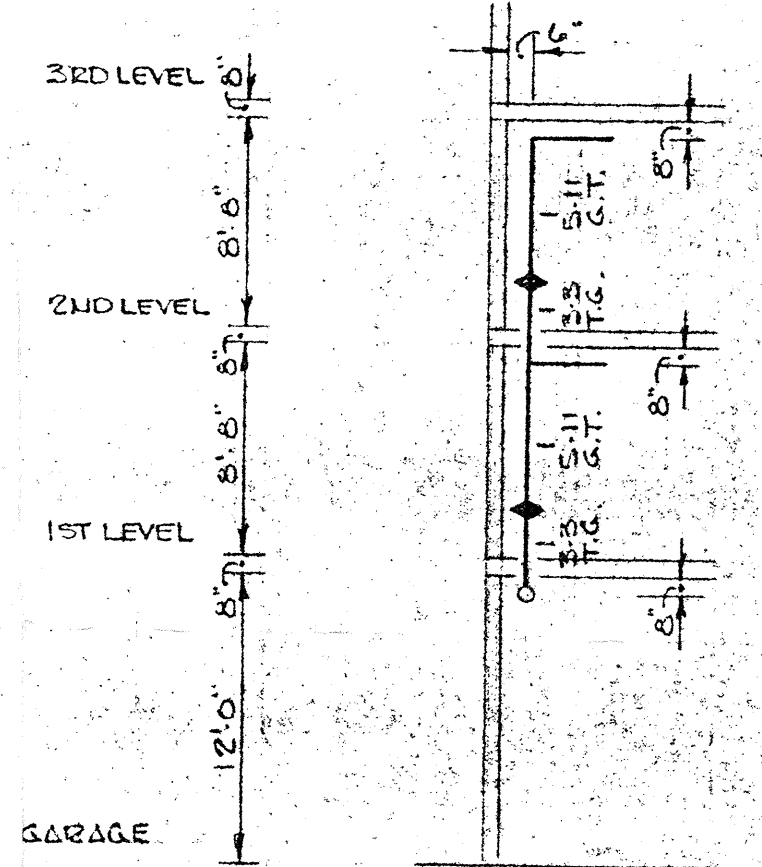


SECTION "A"

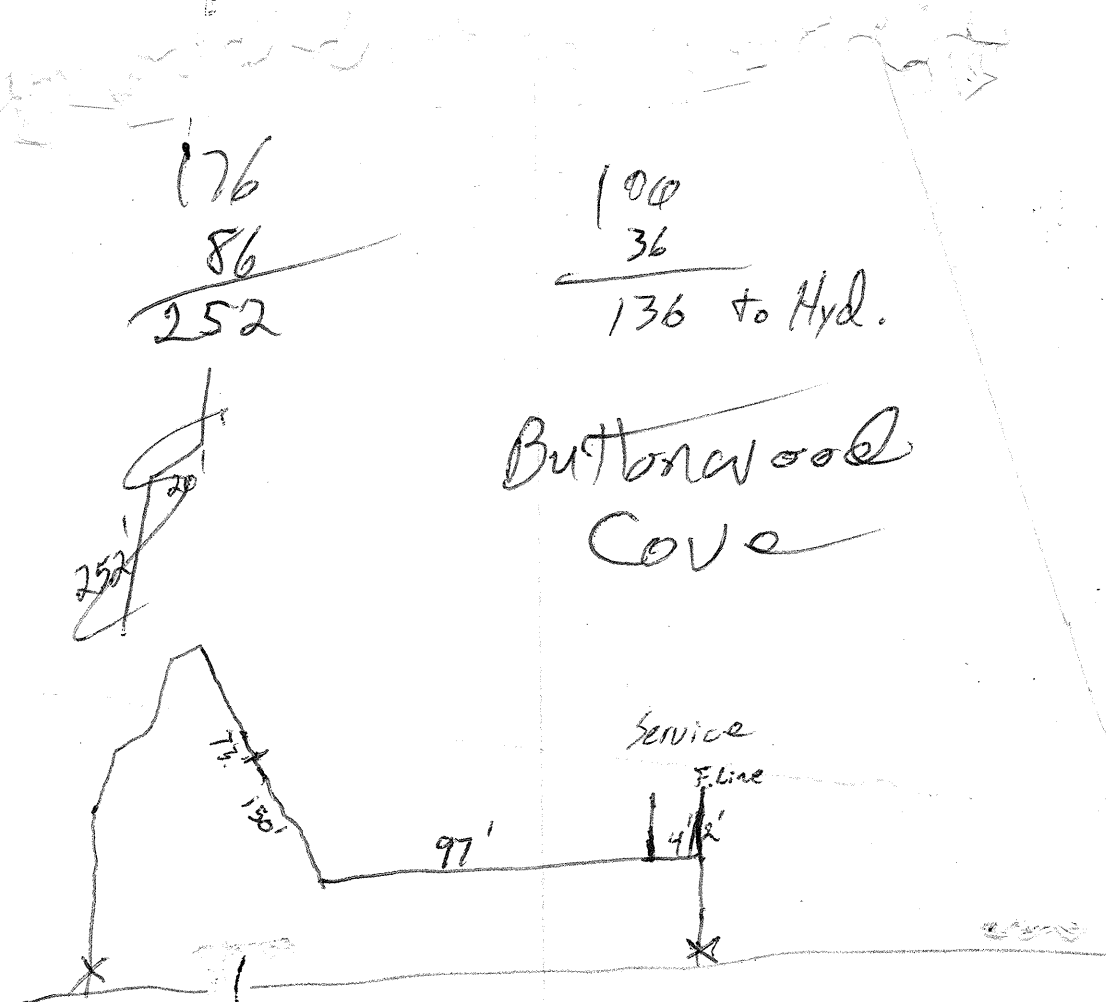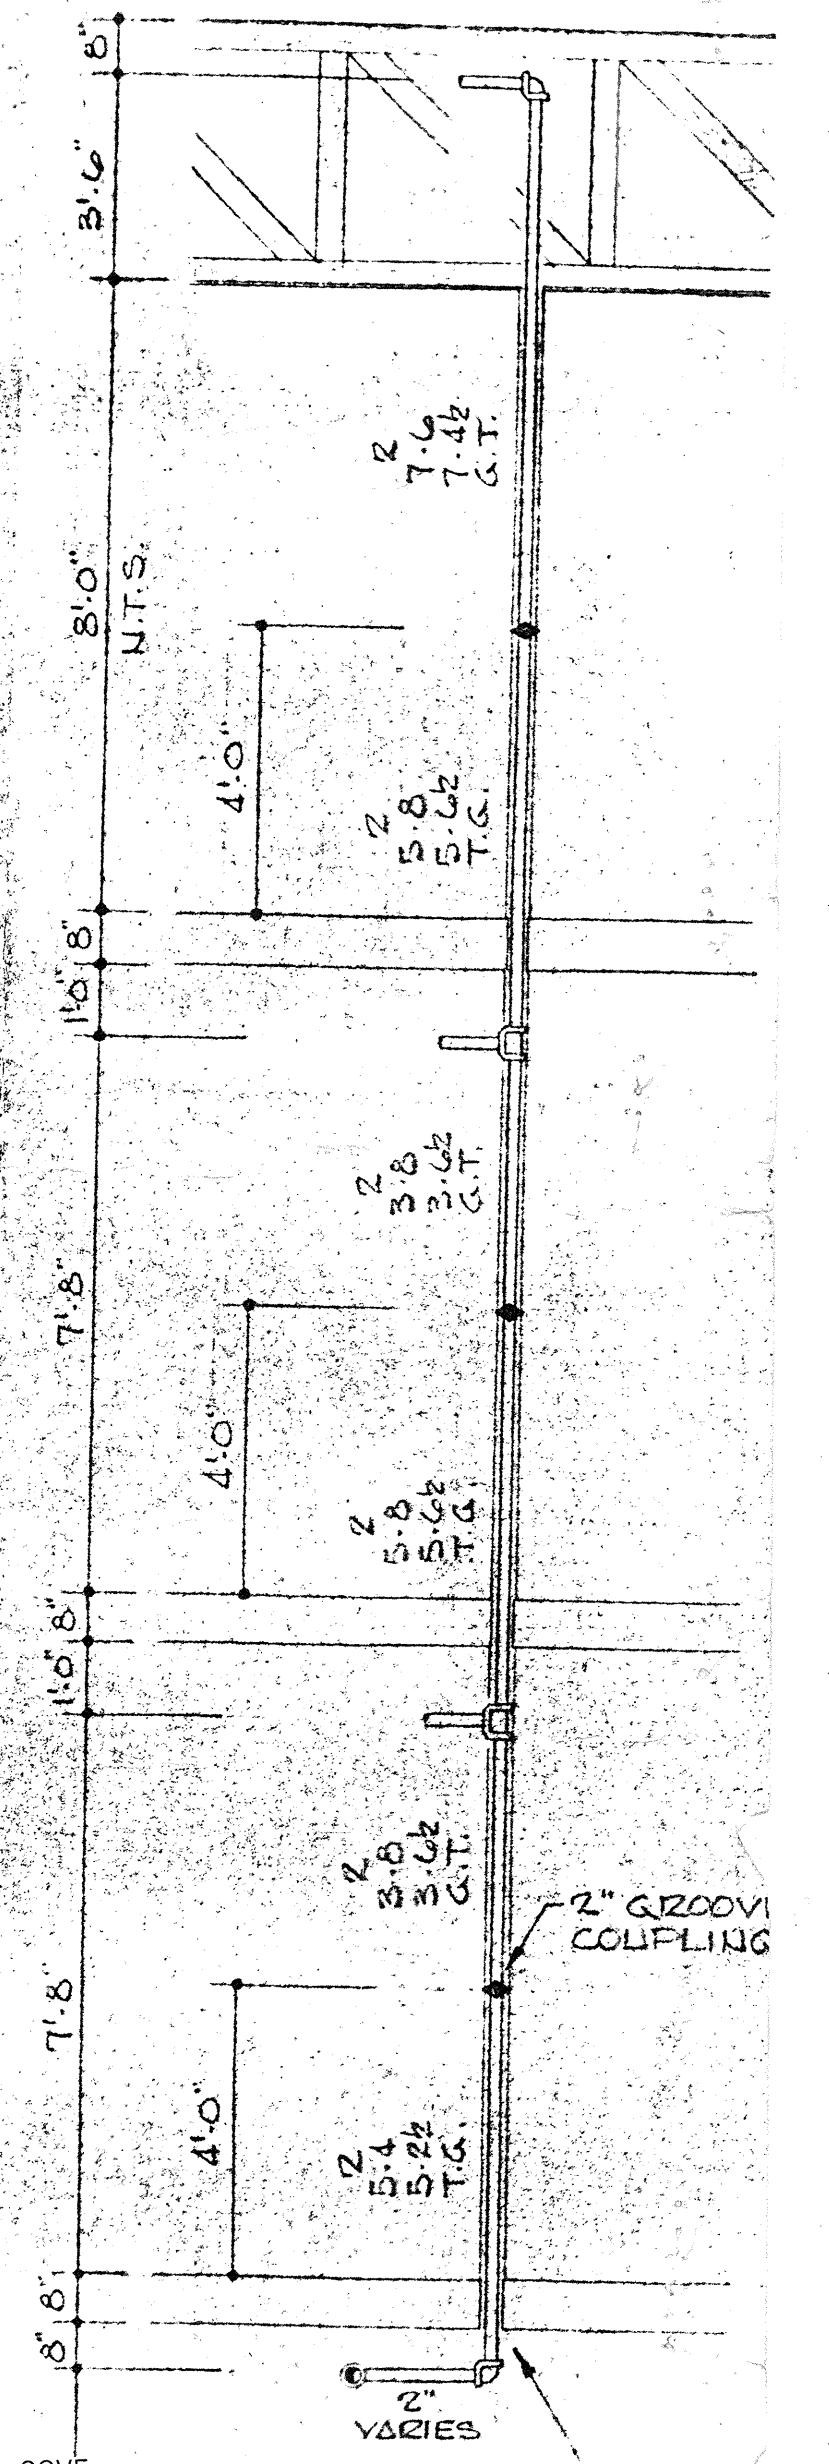

Buttonwood Cove

Valve 12' N of WH Tee 87' " " " in Pool area.

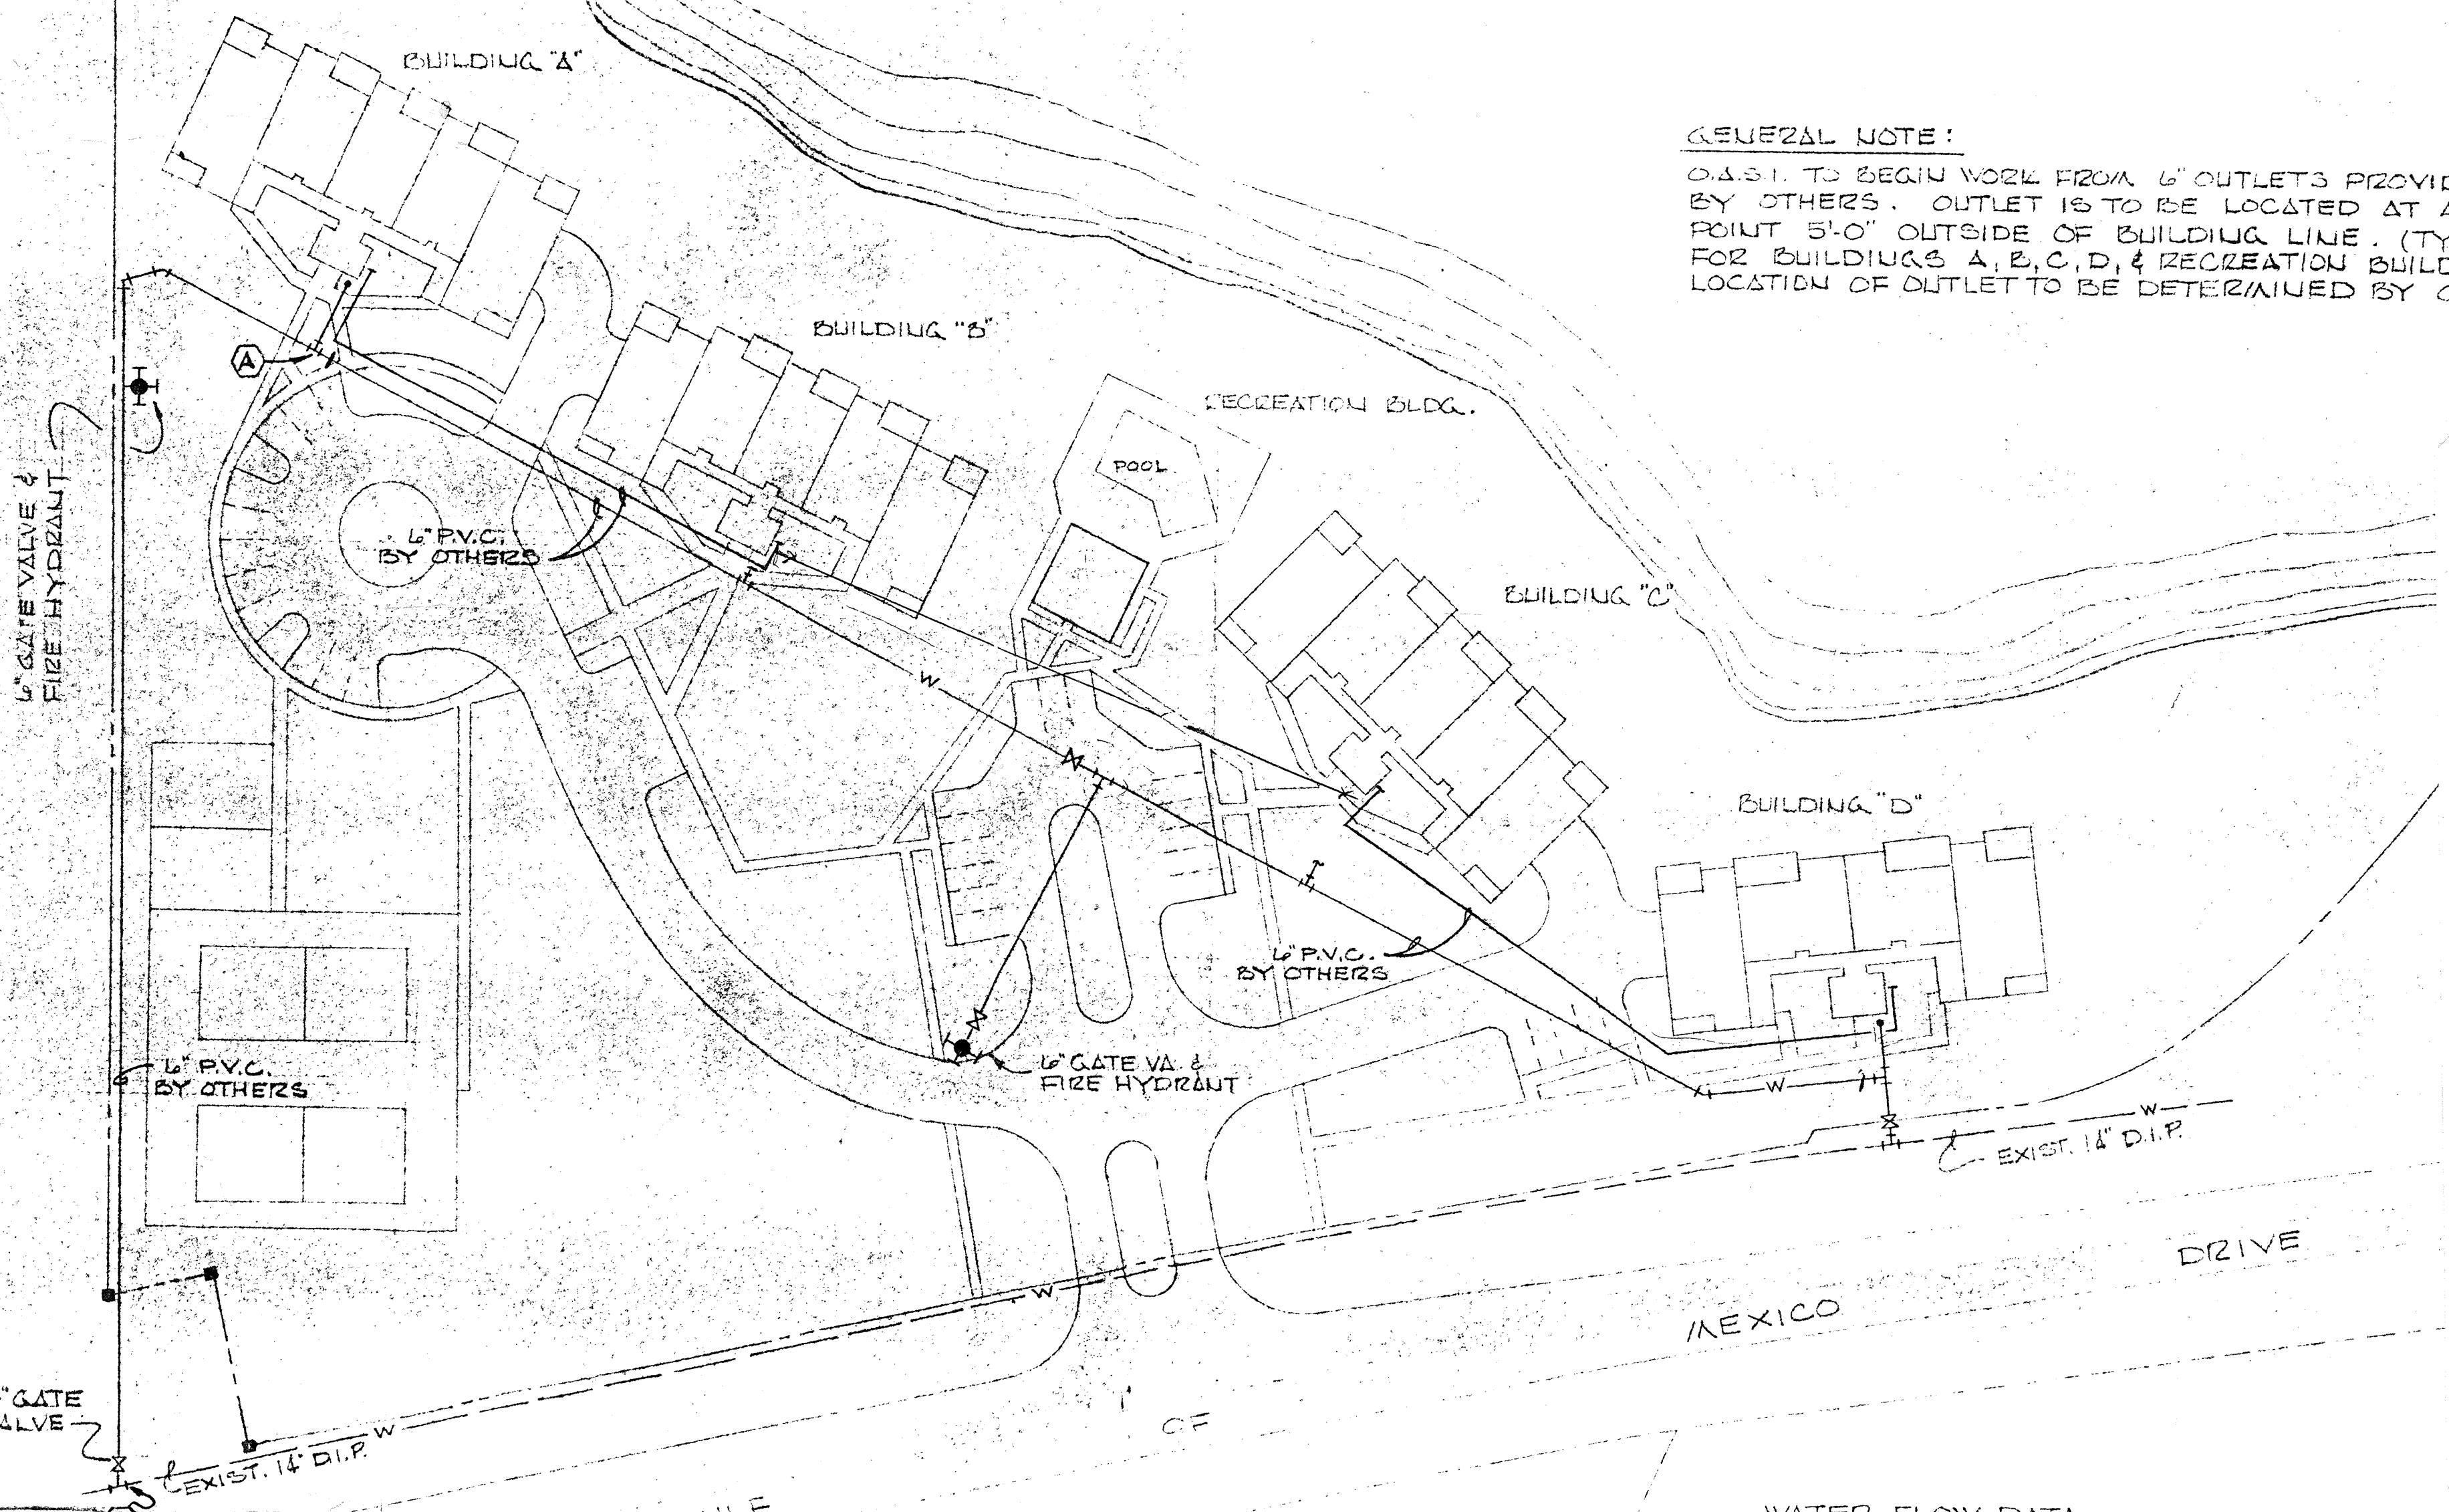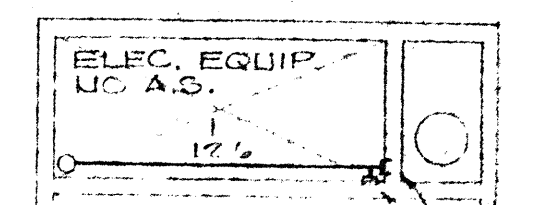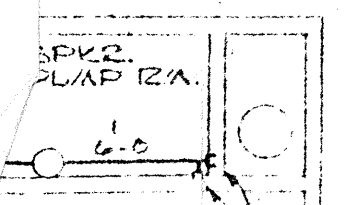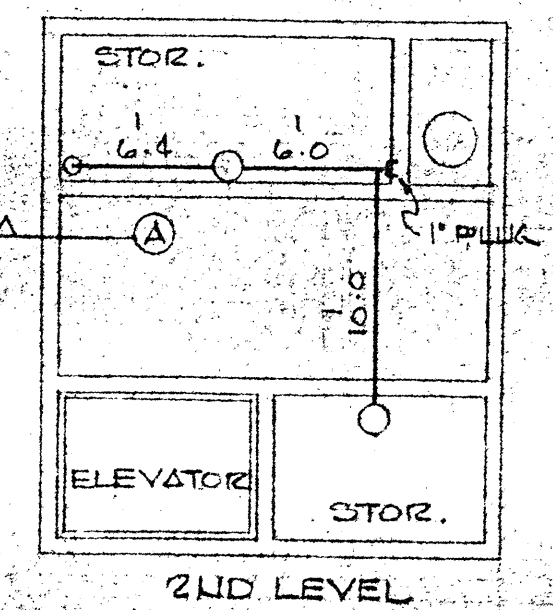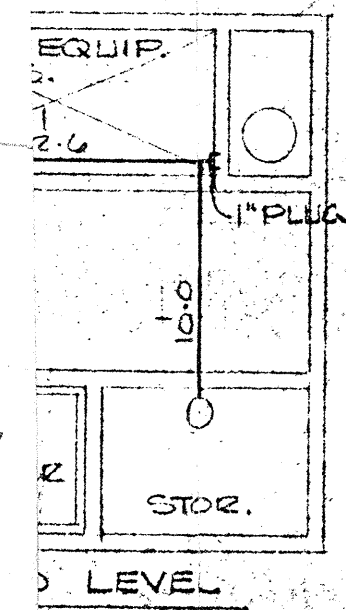

WATER FLOW DATA