

# THE BOATHOUSE AT LONGBOAT KEY

## THE BOATHOUSE ON LONGBOAT, LTD.

BARRY R. LEWIS, GENERAL PARTNER

410 Gulf of Mexico Drive, Longboat Key, Florida 33548


BENNETT & BISHOP  
Consulting Engineers & Surveyors  
Sarasota, Florida

### INDEX

DRWG. NO.	DESCRIPTION
335-01	MASTER LOCATION PLAN
335-02	SKETCH OF SURVEY
335-14	DETAIL SITE PLAN
335-15	TOPOGRAPHIC SURVEY & DEMOLITION PLAN
335-16	FUEL STORAGE TANK - MISC. DETAILS
335-17	SANITARY SEWER PROFILES
335-18	SEAWALL & FINGER PIER PLAN
335-19	SEAWALL DETAILS
335-20	FINGER PIER DETAILS
335-21	SANITARY SEWER DETAILS
335-22	WATER SUPPLY DETAILS
335-23	PAVING & DRAINAGE DETAILS


New Pages  
335-14  
335-15  
335-22  
335-23  
Inserted 6-25/85/July

See Pg 335-14  
Detail Site Plan  
Pg 335-22  
Water Supply Detail

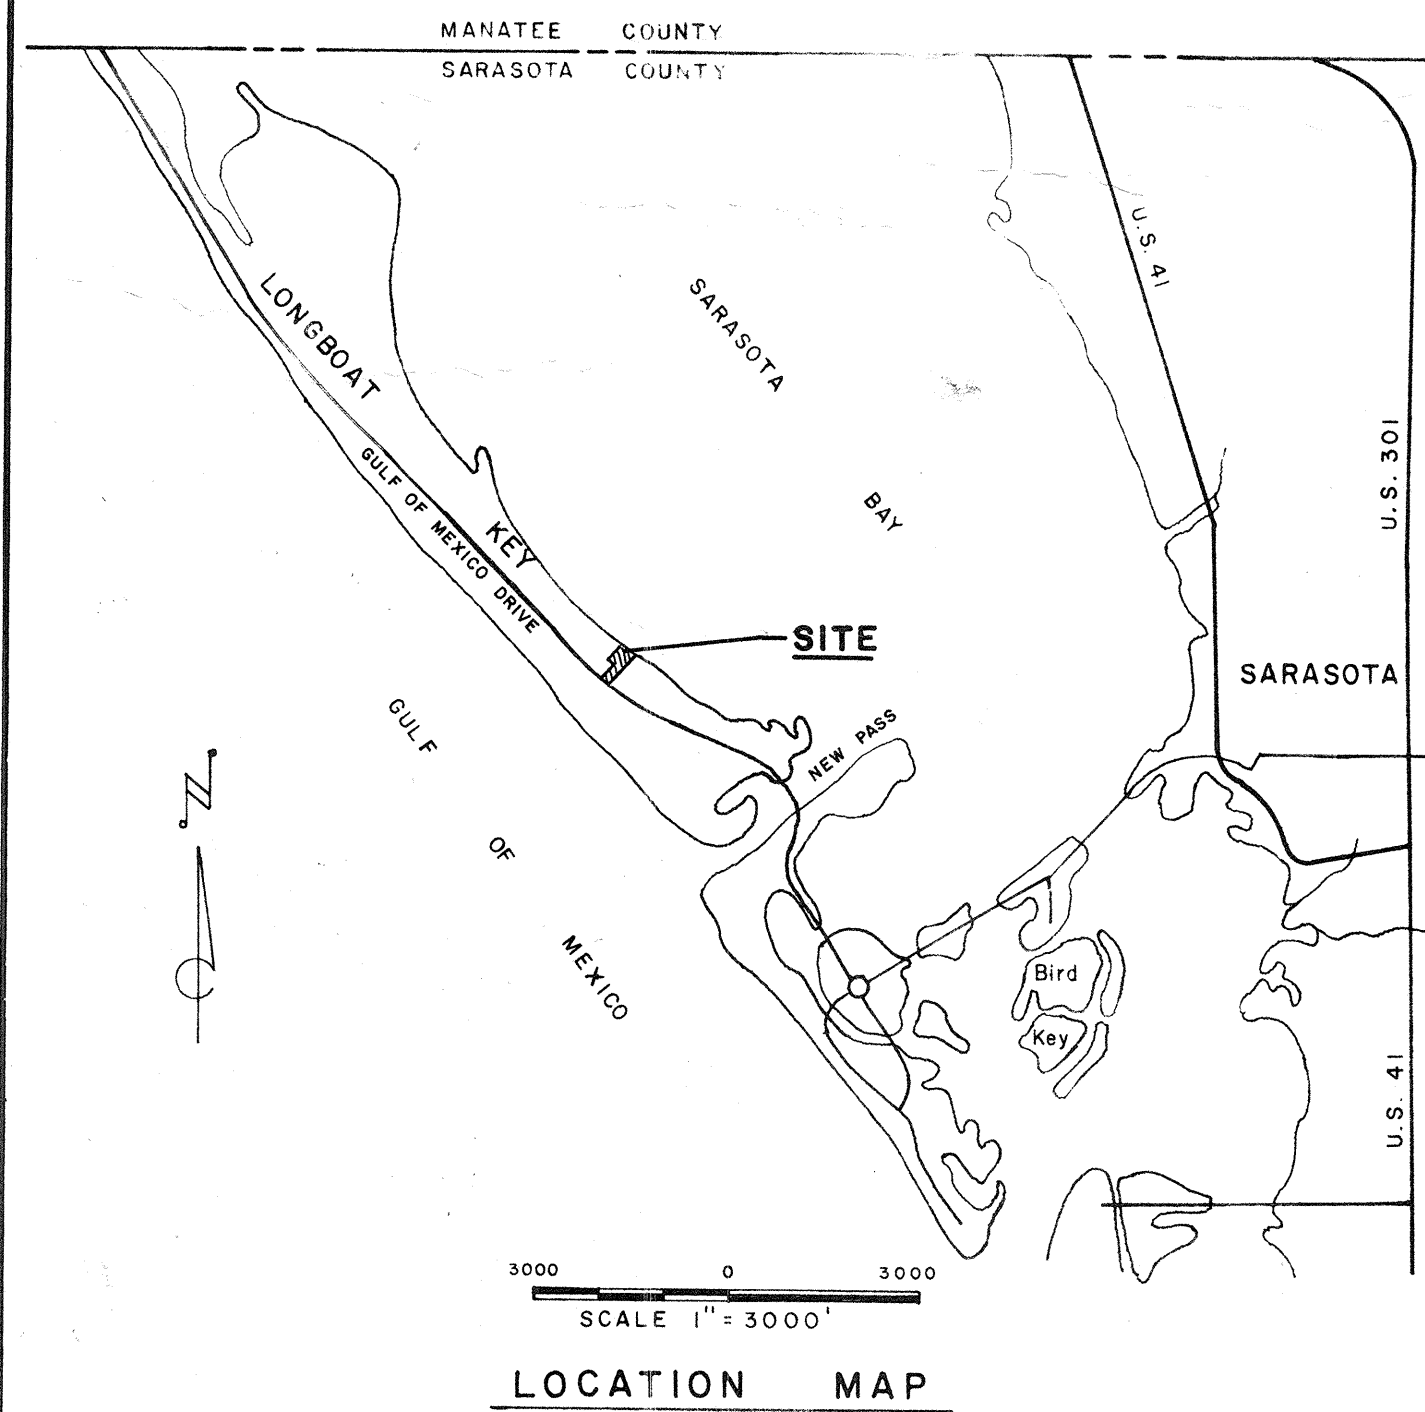

ON STAIRS AS OF 6-25-85  
1. WALL WAS LAMINATED INS  
DRAINAGE SOUTH PL  
2. FURN PEG WALL TIE  
BEAT LIFT.

Rec'd  
SET

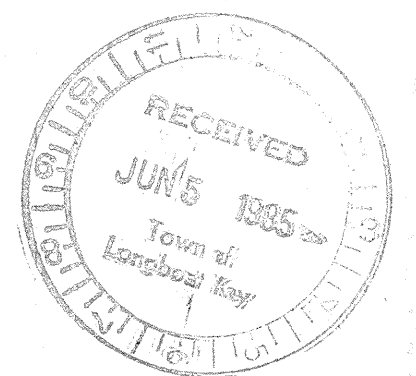

C.O.E. Permit No 84(4)-2910  
D.E.R. Permit No 580896383  
F.D.O.T. Permit No 17-064-84  
COUNTY OF SARASOTA Permit No CS84-0967

Approved by William F. Bishop  
William F. Bishop Florida, P.E. No. 8189

Date 5 Jan 1985