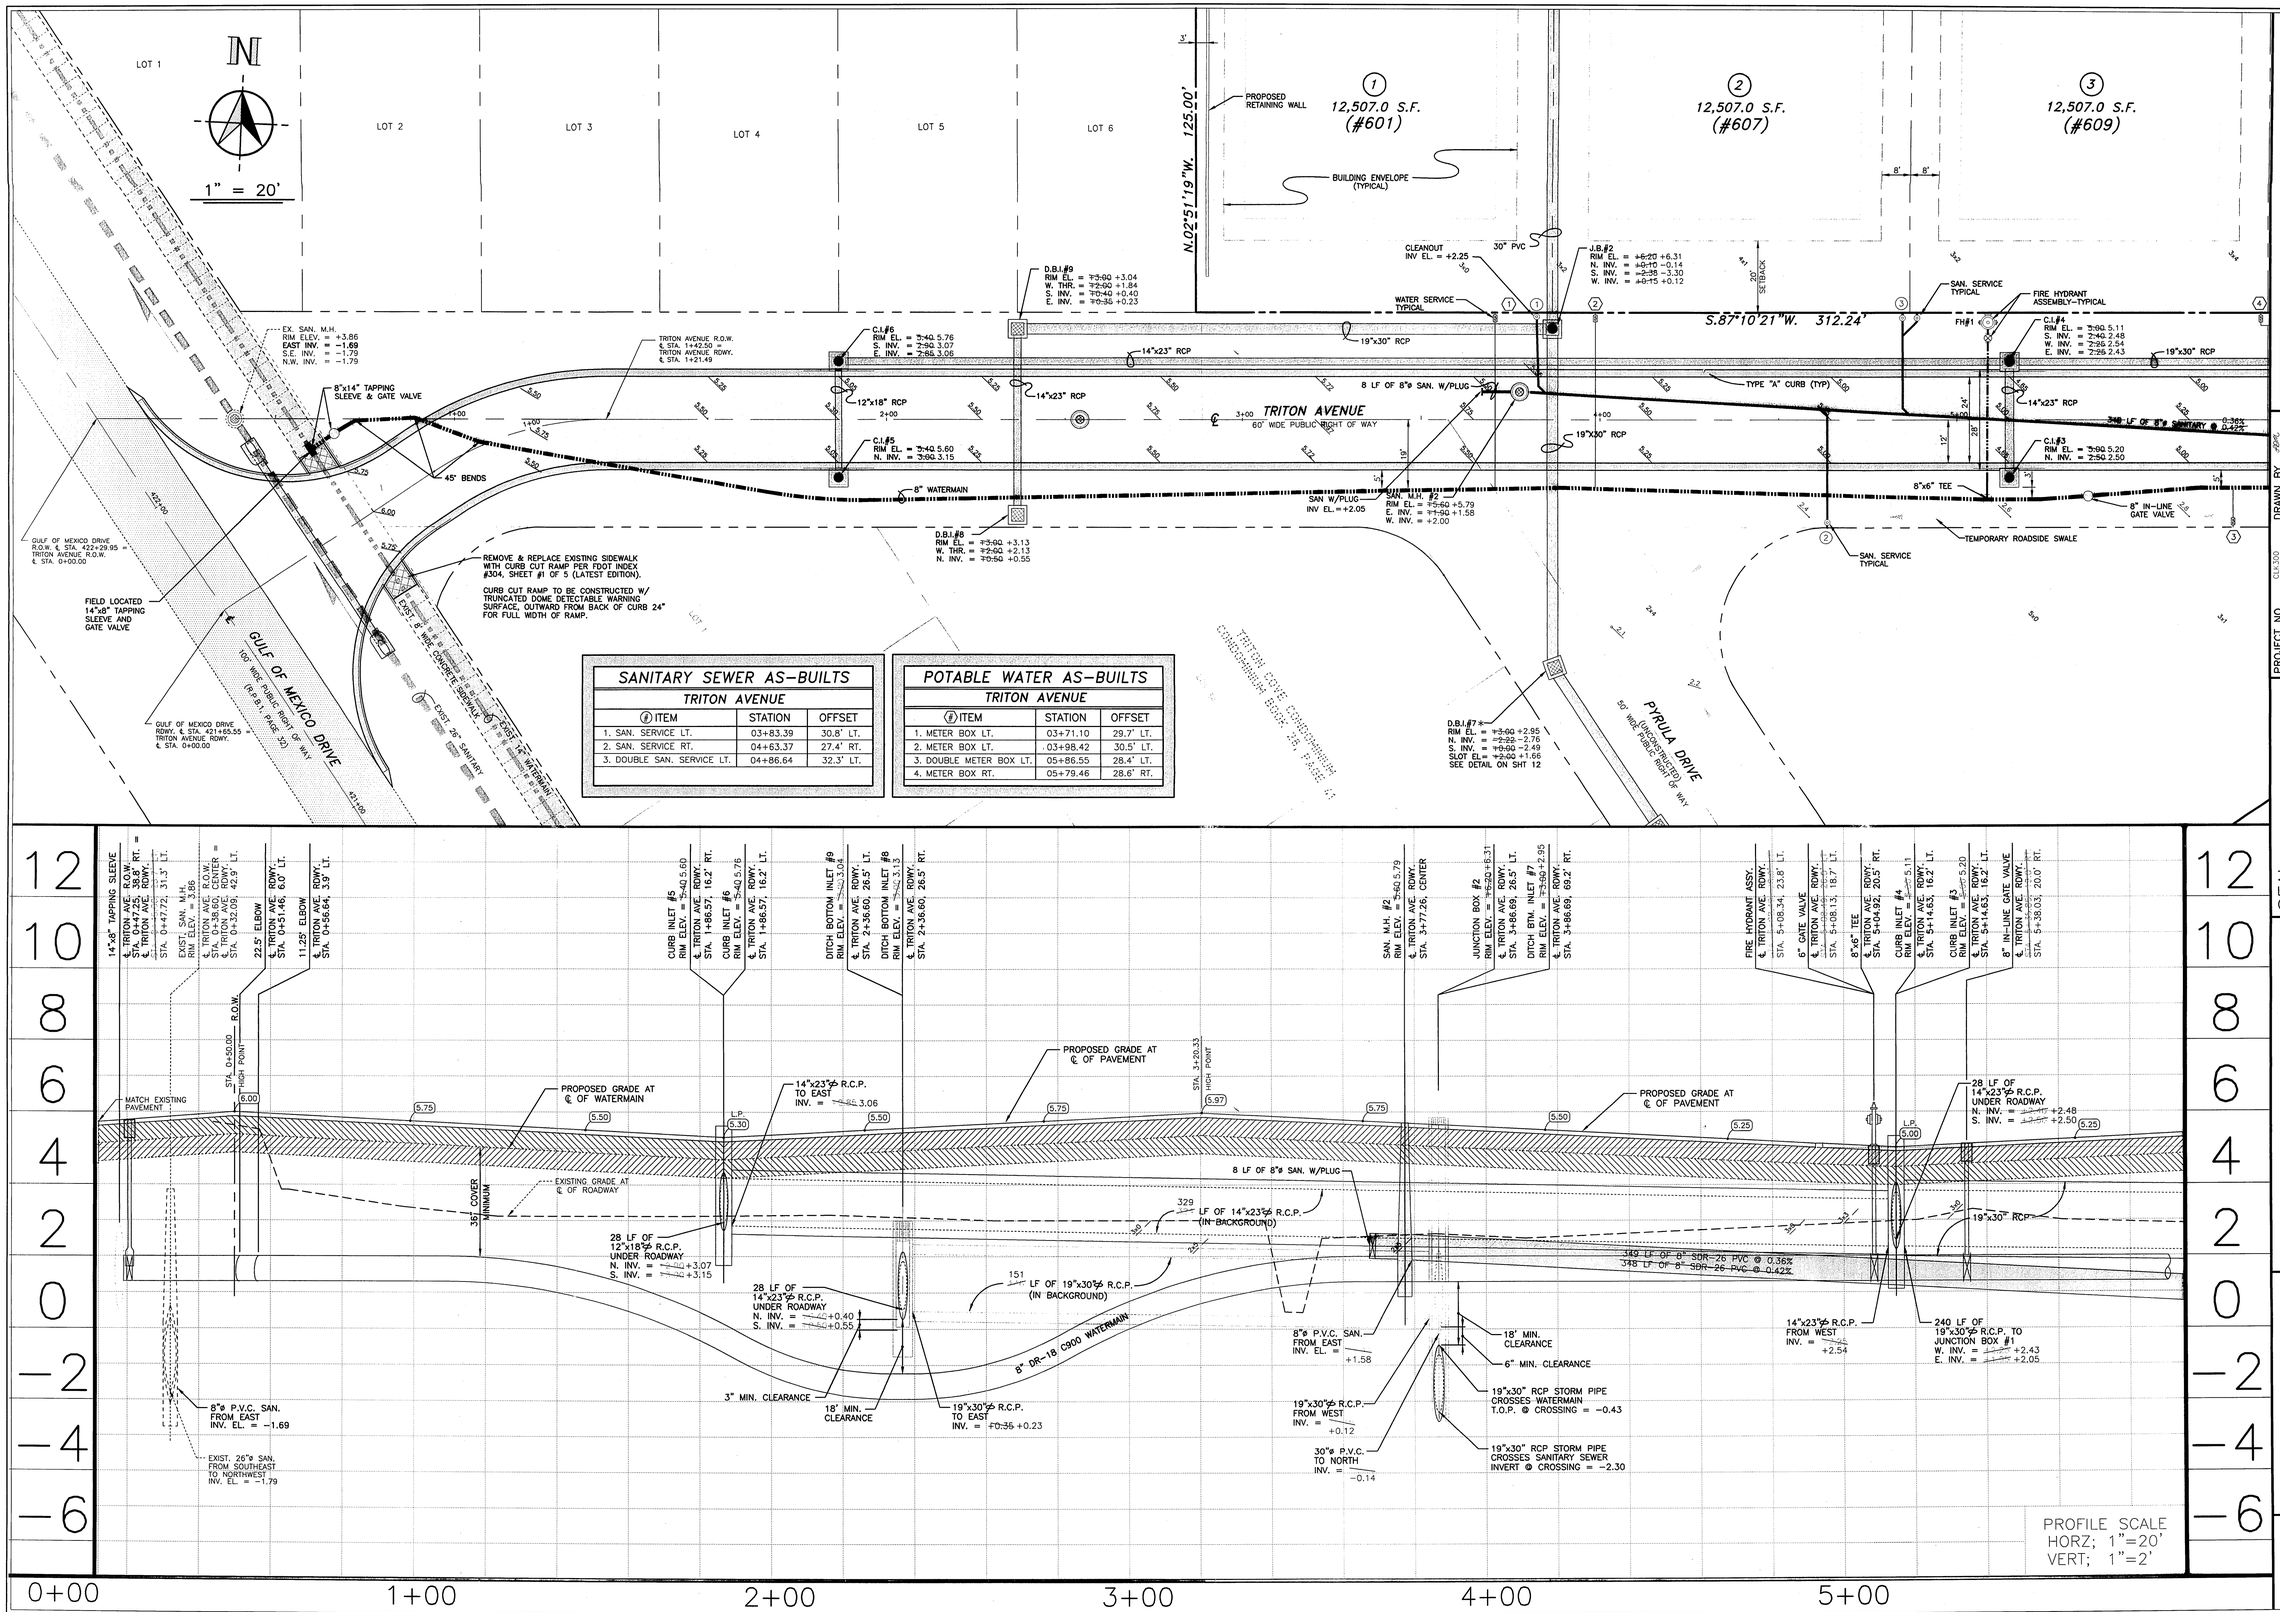

SANITARY SEWER AS-BUILTS

TRITON AVENUE

# ITEM	STATION	OFFSET
1. SAN. SERVICE LT.	03+83.39	30.8' LT.
2. SAN. SERVICE RT.	04+63.37	27.4' RT.
3. DOUBLE SAN. SERVICE LT.	04+86.64	32.3' LT.

POTABLE WATER AS-BUILTS

TRITON AVENUE

# ITEM	STATION	OFFSET
1. METER BOX LT.	03+71.10	29.7' LT.
2. METER BOX LT.	03+98.42	30.5' LT.
3. DOUBLE METER BOX LT.	05+86.55	28.4' LT.
4. METER BOX RT.	05+79.46	28.6' RT.

CYRIX ENGINEERING, INC.
Engineers & Surveyors
11144 Tallevast Rd, #111
Sarasota, Fla 34243
(941) 358-8812 (ph) * (941) 358-8909 (fax)

PROJECT NO. CLX300 DRAWN BY JRP
CHECKED BY JMP DATE 13 APRIL 2004

REVISIONS	DATE	BY
REVISED PER TOWN COMMENTS	15 JUN 04	RM
REVISED PER TOWN COMMENTS	04 NOV 04	JRP
REVISED PER MAN. CO. UTILITIES	04 APR 06	GP
REVISED WATERMAIN AND CULVERT PER THE TOWN OF LONGBOAT KEY	01 MAY 08	JRP

SEAL: J. Mark Privette PE Fl. Reg.# 43394 MAY 01 2008 Date

COQUINA BEACH SUBDIVISION

PLAN & PROFILE
TRITON AVENUE ROADWAY ℄
STA. 0+00.00 TO STA. 5+95.00

SHEET 13 OF 16

RECORD DRAWING: 12 MAY 2008

\\Server - Job Files\Engineering\Coquina Beach\ASBUILTS-MAY08\Coquina-01AB.plt 11:23:02 05/07/2008