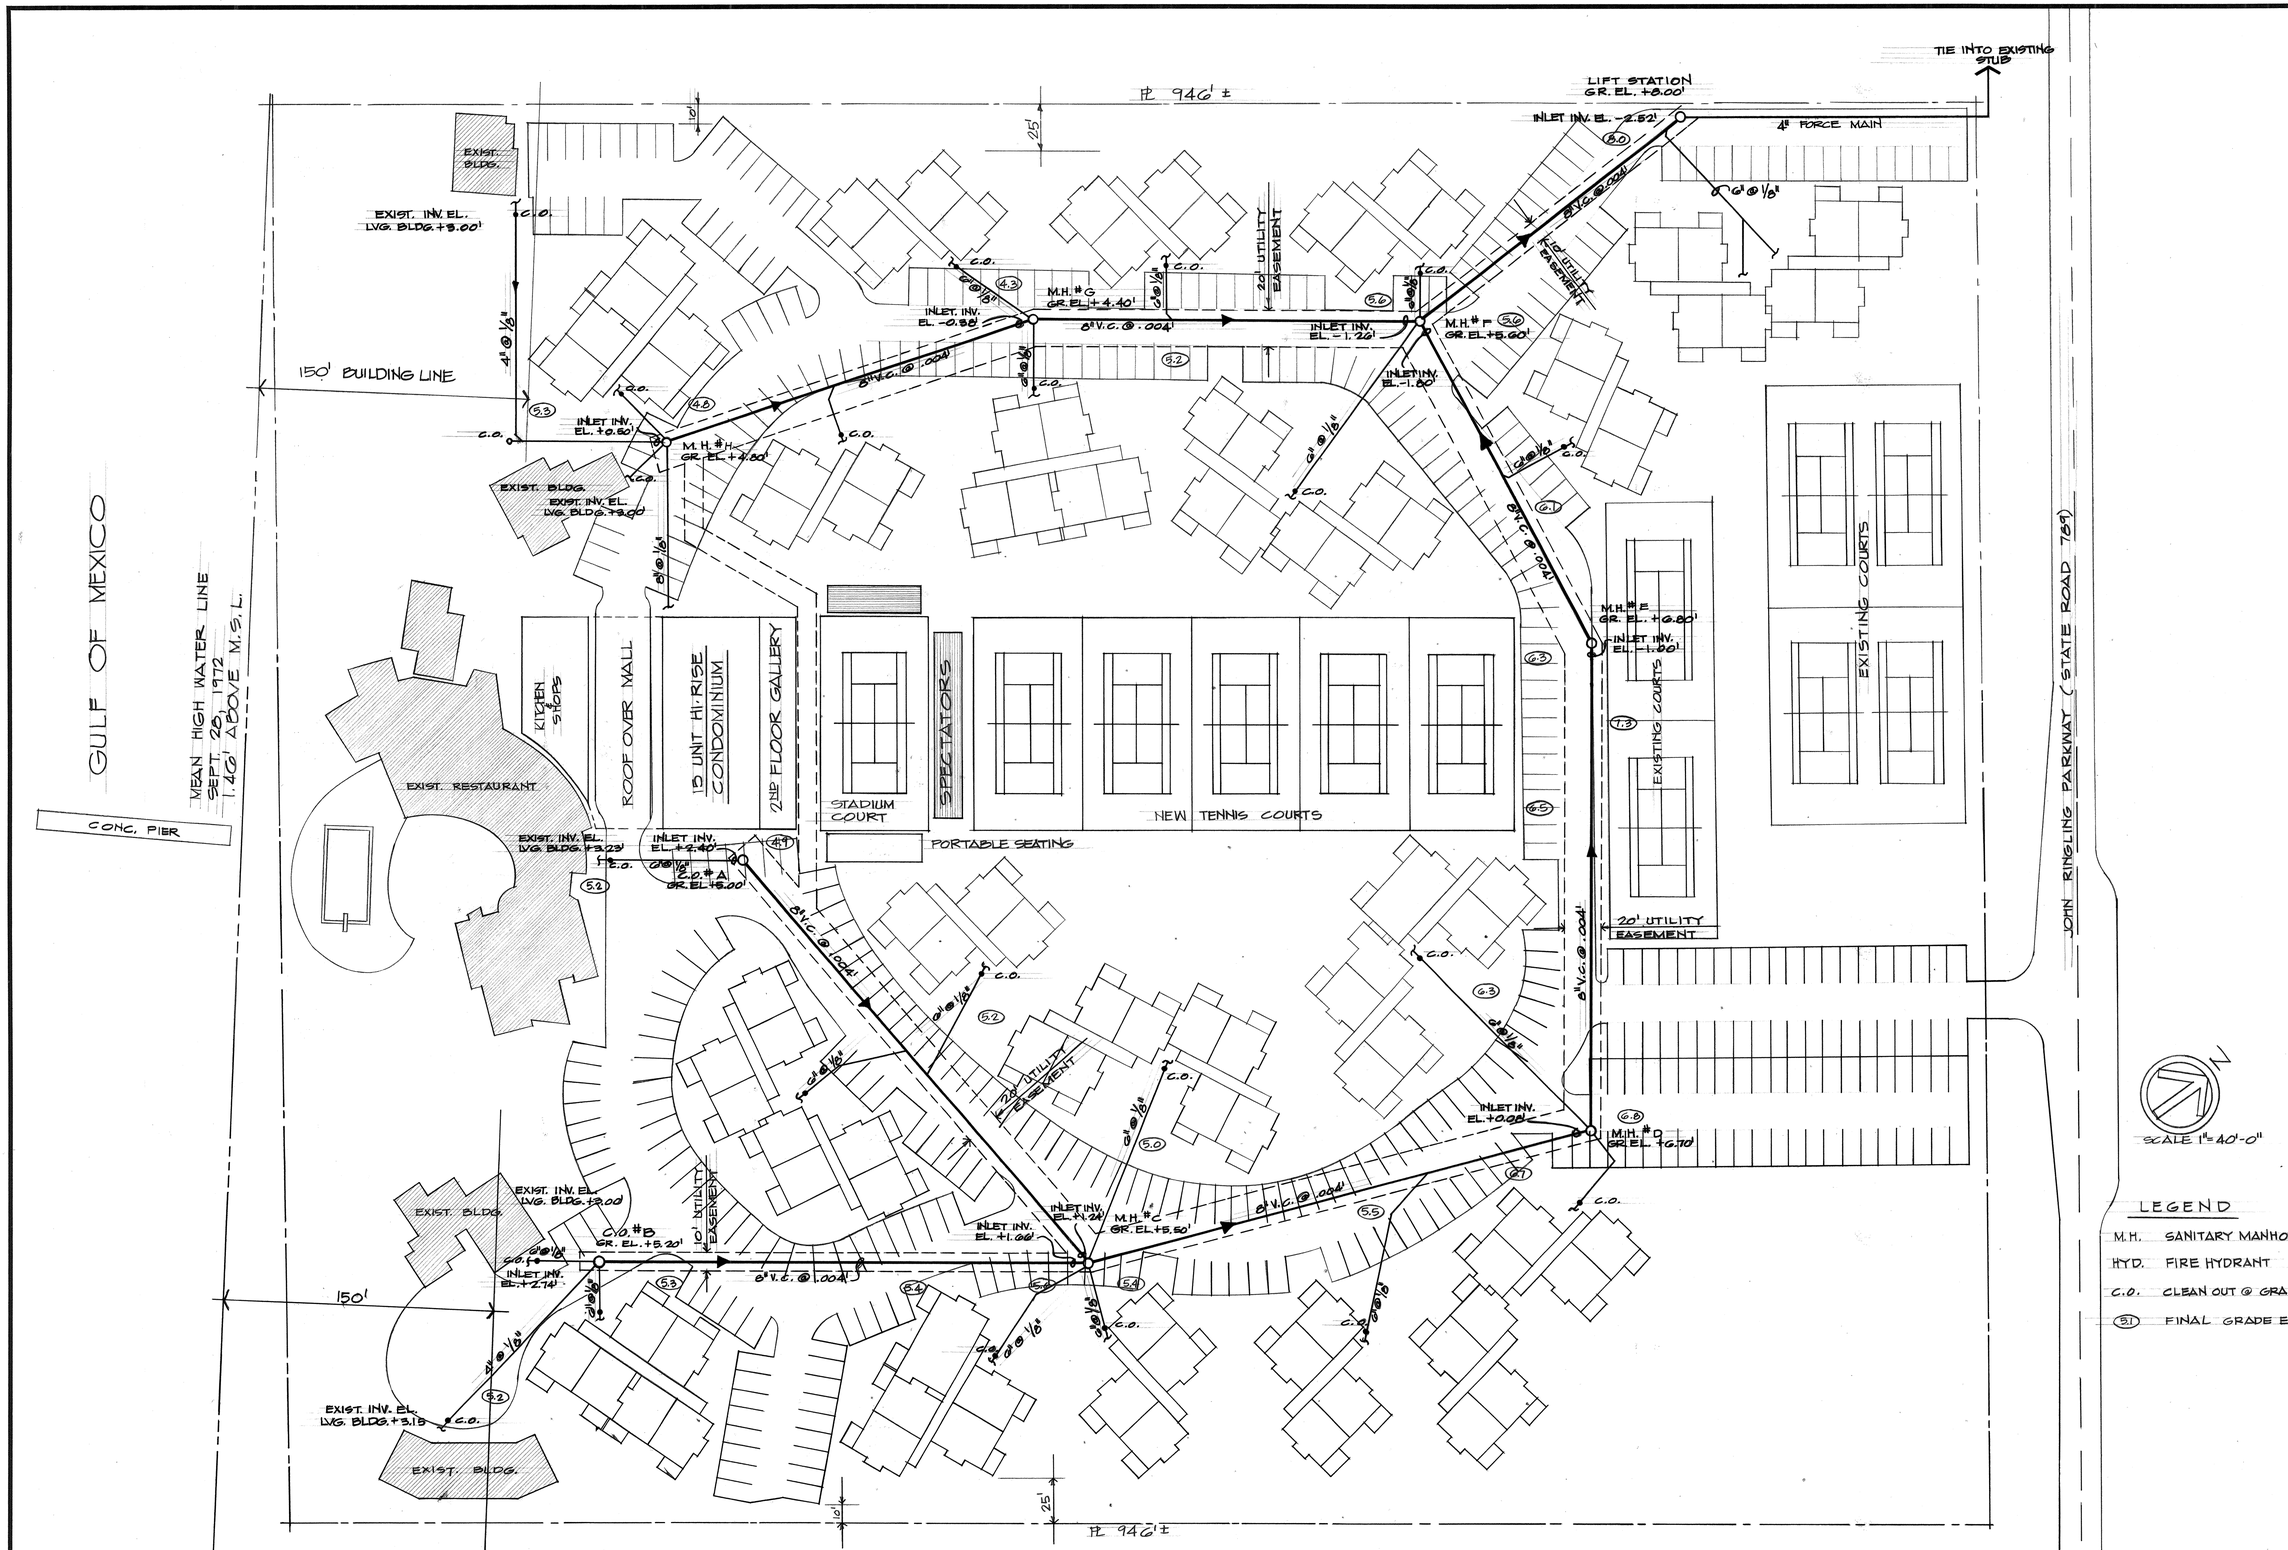

LEGEND

M.H.	SANITARY MANHOLE
HYD.	FIRE HYDRANT
C.O.	CLEAN OUT @ GRADE
(5.1)	FINAL GRADE ELEV.

SITE PLAN

SHOWING "AS BUILT" WASTEWATER COLLECTION SYSTEM

LTR.	DATE	REVISION	BY

SCALE: | DATE: | DESIGNED BY | PROJECT ENGINEER
DRAWN BY | CHECKED BY | PROJECT NO.

D.E. BRITT ASSOC. INC.
1616 N. FEDERAL HWY.
FT. LAUDERDALE, FLA.
FLA. REG. No. 4995
FILE # 62/7

TOWN OF LONGBOAT KEY, FLORIDA
COLONY BEACH & TENNIS CLUB
LONGBOAT KEY SARASOTA FLORIDA

ENGINEER & LOCATION

SHEET NUMBER
W/S-2

REVISION

T.L.K. FILE NO.