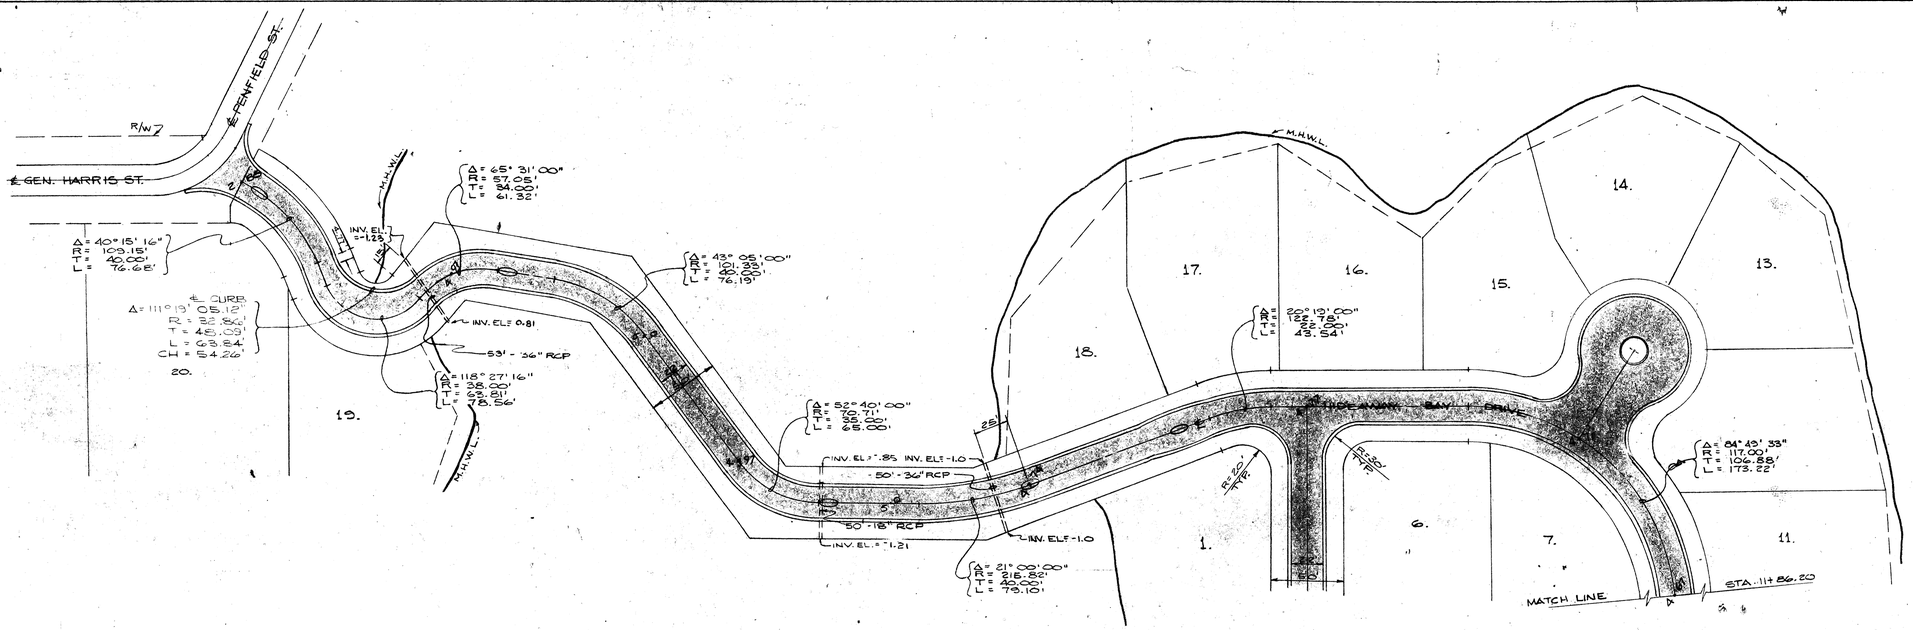

SCALE
HORZ: 1" = 50'
VERT: 1" = 2'

PLAN		BY	DATE
NOTE BOOK	SURVEYED		
	PLOTTED		
	ALIGNMENT CHECKED	KTL	
No.	R/W & EASEMENTS CHECKED		

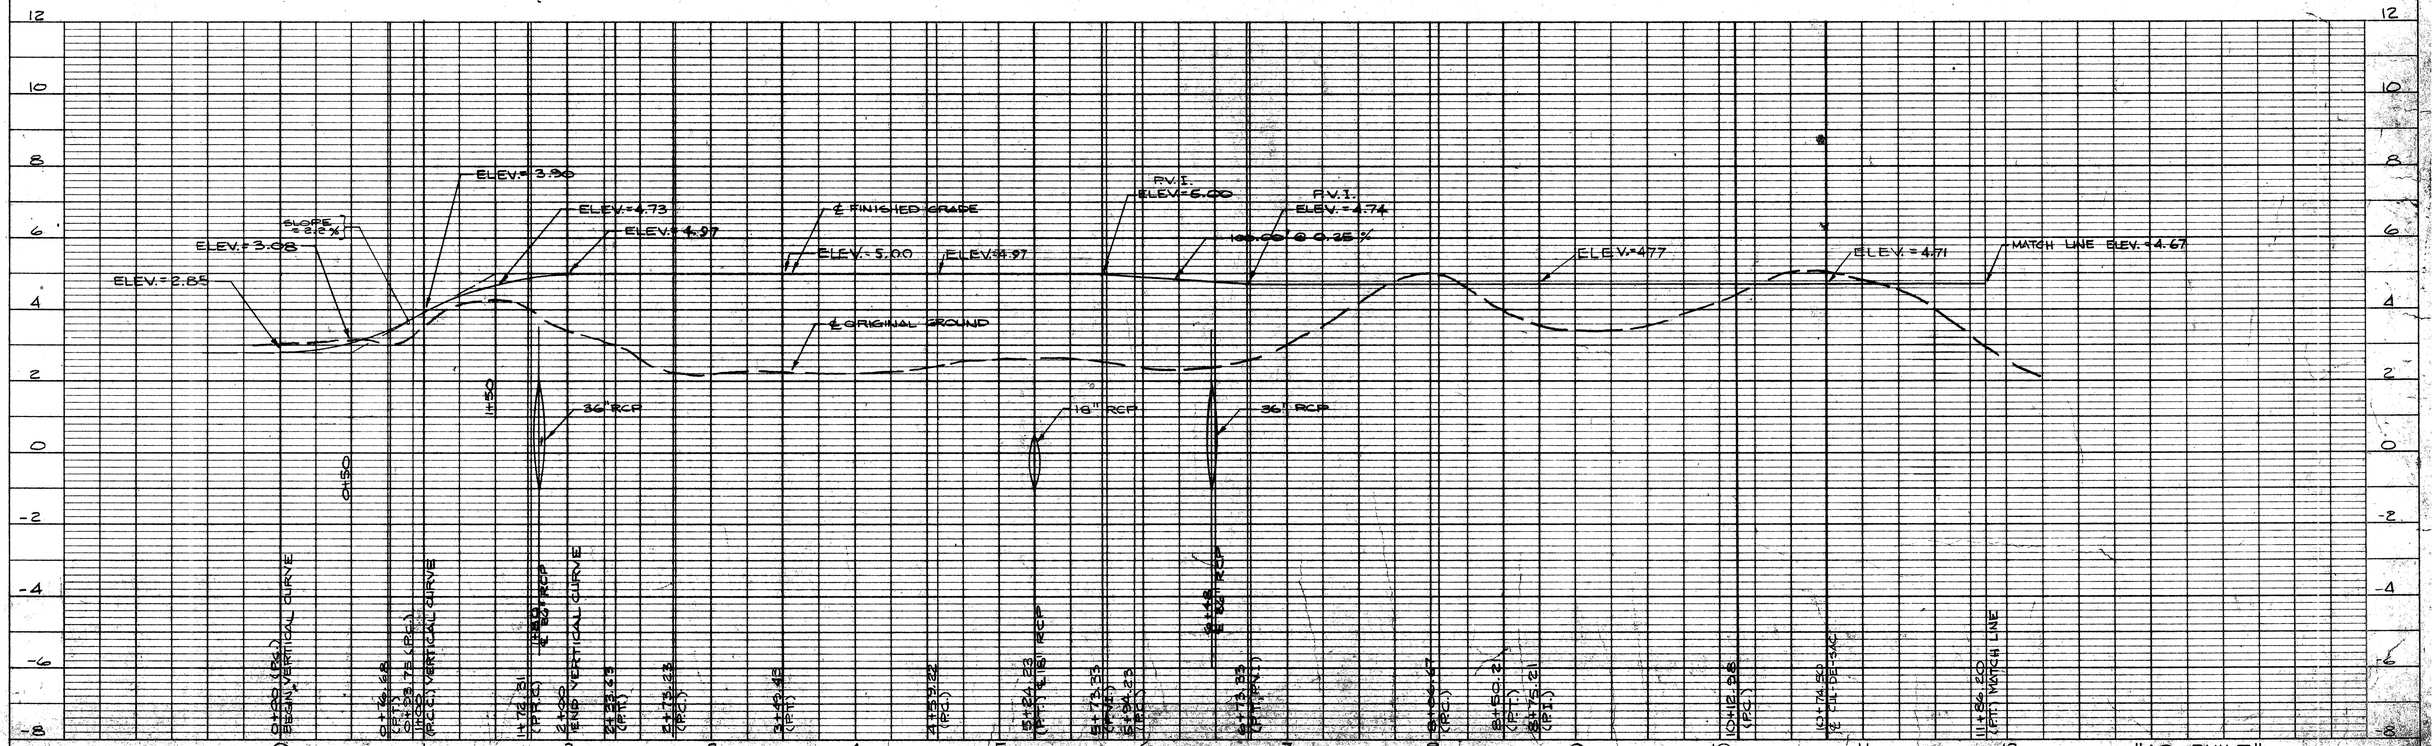

PROFILE		BY	DATE
NOTE BOOK	SURVEYED		
	PLOTTED		
	GRADES CHECKED	KTL	
No.	R/W & EASEMENTS		
	STRUCTURE NOTATIONS CHECKED		

PLATE 1—SINGLE PLAN-PROFILE O. P. R. & R. E. STANDARD
A. L. RIDGWAY COMPANY, INC.
100% RAG MADE IN U.S.A.

ROBERTS & ZOLLER, INC.
CONSULTING ENGINEERS

"AS-BUILT"
STREET CONSTRUCTION PLAN
FOR
HIDEAWAY BAY

(REVISED 4-12-78)

SHEET 2 OF 3