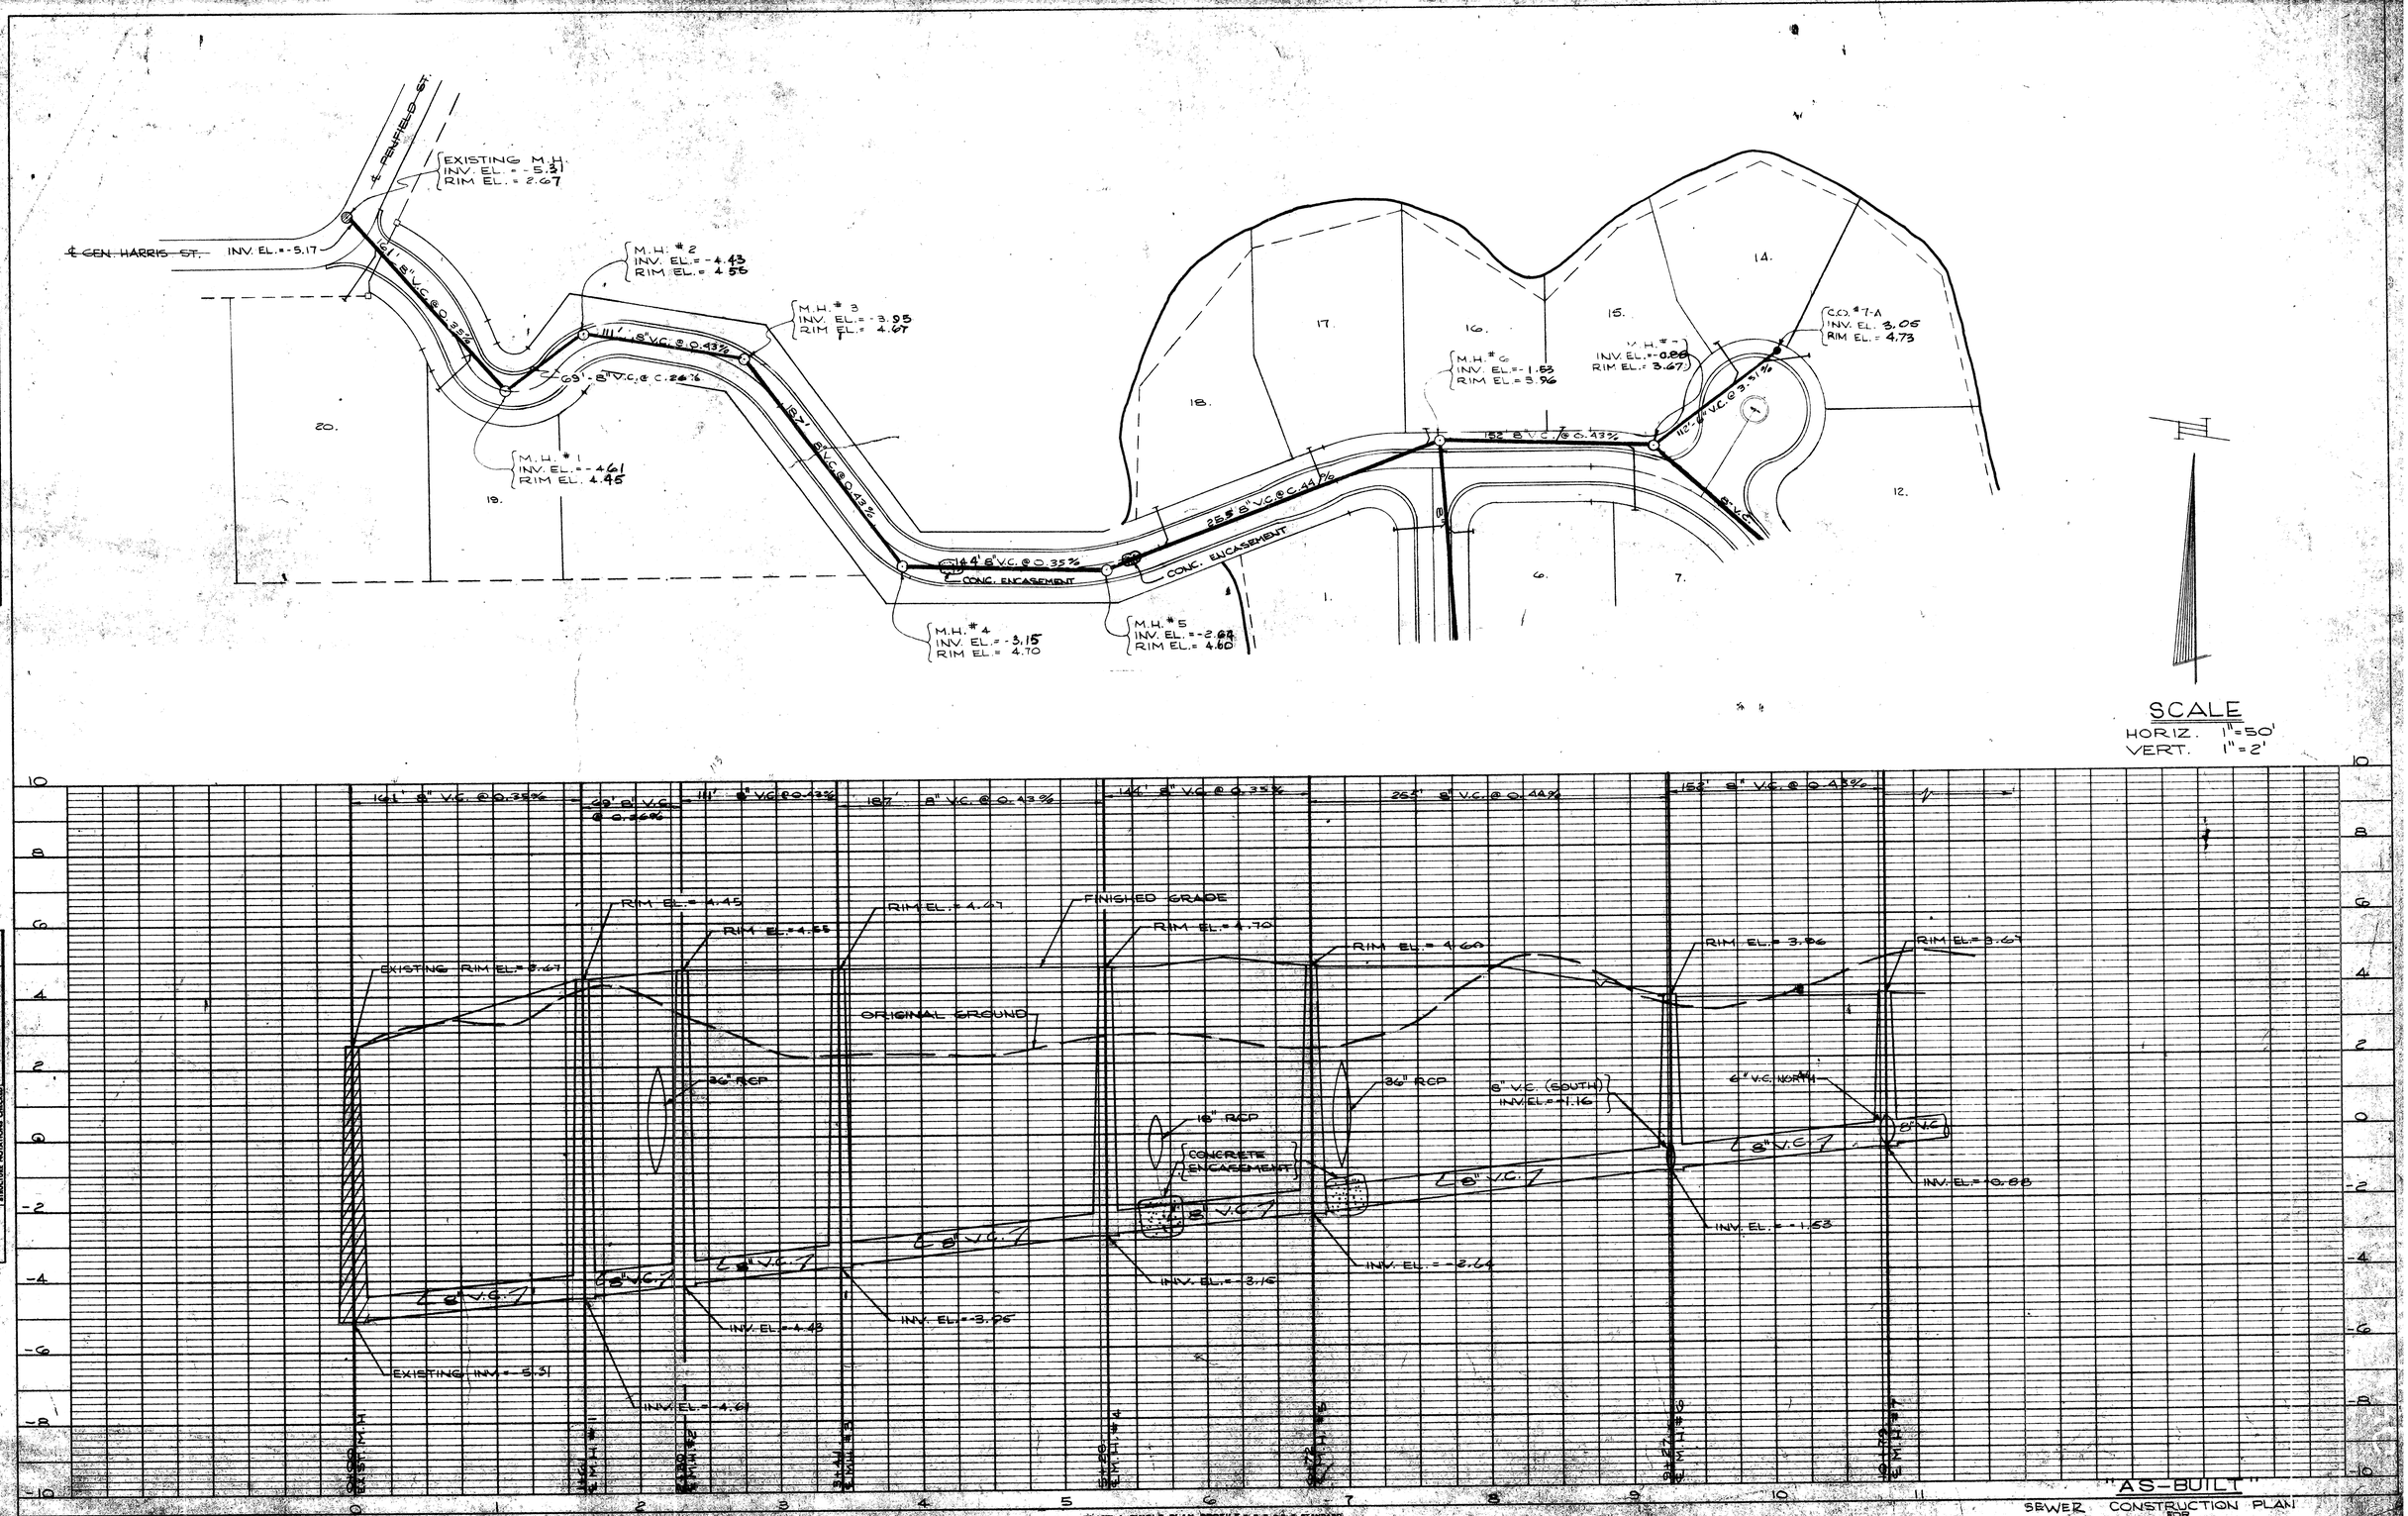
℄ PENFIELD ST.
EXISTING M.H.
INV. EL. = -5.31
RIM EL. = 2.67
℄ GEN. HARRIS ST.
INV. EL. = -5.17
161' 8" V.C. @ 0.35%
M.H. # 2
INV. EL. = -4.43
RIM EL. = 4.55
M.H. # 3
INV. EL. = -3.95
RIM EL. = 4.67
111' 8" V.C. @ 0.43%
69' 8" V.C. @ 0.26%
187' 8" V.C. @ 0.43%
M.H. # 1
INV. EL. = -4.61
RIM EL. 4.45
20.
19.
144' 8" V.C. @ 0.35%
CONC. ENCASEMENT
M.H. # 4
INV. EL. = -3.15
RIM EL. = 4.70
M.H. # 5
INV. EL. = -2.68
RIM EL. = 4.60
262' 8" V.C. @ 0.44%
CONC. ENCASEMENT
18.
17.
16.
15.
14.
M.H. # 6
INV. EL. = -1.53
RIM EL. = 3.96
M.H. # 7
INV. EL. = -0.88
RIM EL. = 3.67
152' 8" V.C. @ 0.43%
116' 8" V.C. @ 3.1%
C.O. # 7-A
INV. EL. 3.05
RIM EL. = 4.73
8" V.C.
12.
1.
6.
7.
SCALE
HORIZ. 1" = 50'
VERT. 1" = 2'
161' 8" V.C. @ 0.35%
69' 8" V.C. @ 0.26%
111' 8" V.C. @ 0.43%
187' 8" V.C. @ 0.43%
144' 8" V.C. @ 0.35%
262' 8" V.C. @ 0.44%
152' 8" V.C. @ 0.43%
RIM EL. = 4.45
RIM EL. = 4.55
RIM EL. = 4.67
FINISHED GRADE
RIM EL. = 4.70
RIM EL. = 4.60
RIM EL. = 3.96
RIM EL. = 3.67
EXISTING RIM EL. = 3.67
ORIGINAL GROUND
36" RCP
18" RCP
36" RCP
CONCRETE ENCASEMENT
8" V.C. (SOUTH)
INV. EL. = -1.16
6" V.C. NORTH
8" V.C.
8" V.C.
8" V.C.
8" V.C.
8" V.C.
8" V.C.
INV. EL. = -10.88
INV. EL. = -1.53
INV. EL. = -3.16
INV. EL. = -2.64
INV. EL. = -4.43
INV. EL. = -3.95
EXISTING INV. = 5.31
INV. EL. = -4.61
EXISTING M.H.
M.H. # 1
M.H. # 2
M.H. # 3
M.H. # 4
M.H. # 5
M.H. # 6
M.H. # 7
PLATE 1—SINGLE PLAN-PROFILE C.F.S.R.R. STANDARD
L. L. BOSWORT COMPANY, INC.
"AS-BUILT"
SEWER CONSTRUCTION PLAN
FOR
HIDEAWAY BAY
(REVISED 1/16-75)
SHEET 1 of 2
PLAN
SURVEYED
PLOTTED
NOTE BOOK
AUGMENT CHECKED
RT. OF WAY CHECKED
No.
BY
MIKE
DATE
PROFILE
SURVEYED
PLOTTED
NOTE BOOK
GRADES CHECKED
S. M.'s NOTED
STRUCTURE NOTATIONS CHECKED
No.
BY
MIKE
DATE