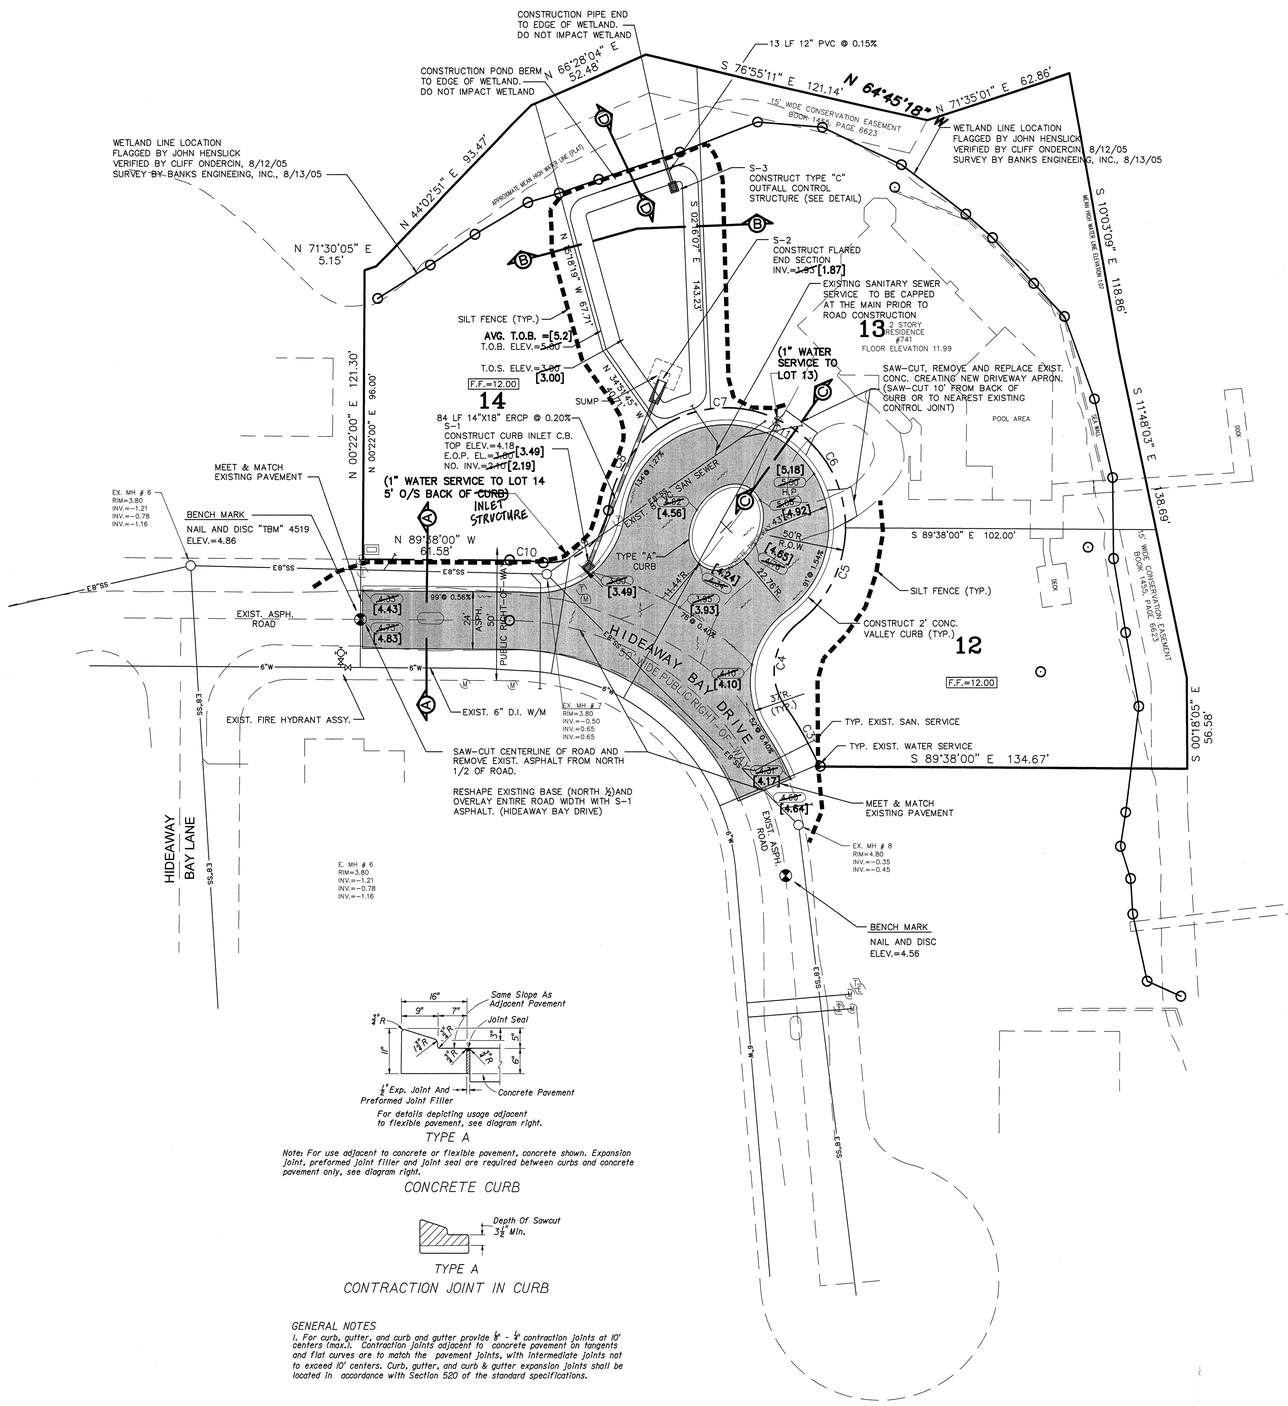

For details depicting usage adjacent to flexible pavement, see diagram right.

TYPE A

Note: For use adjacent to concrete or flexible pavement, concrete shown. Expansion joint, preformed joint filler and joint seal are required between curbs and concrete pavement only, see diagram right.

CONCRETE CURB

TYPE A

CONTRACTION JOINT IN CURB

GENERAL NOTES

1. For curb, gutter, and curb and gutter provide ½" - ¼" contraction joints at 10' centers (max.). Contraction joints adjacent to concrete pavement on tangents and flat curves are to match the pavement joints, with intermediate joints not to exceed 10' centers. Curb, gutter, and curb & gutter expansion joints shall be located in accordance with Section 520 of the standard specifications.

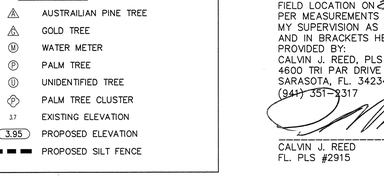

SECTION

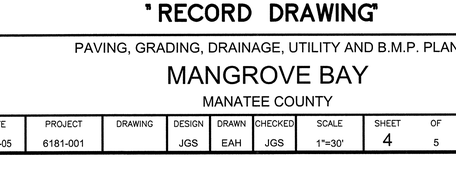

ELEVATION

NOTE: SILT FENCE TO BE PAID FOR UNDER THE CONTRACT UNIT PRICE FOR STAKED SILT FENCE (LF).

TYPE 3 SILT FENCE

LEGEND:

- AUSTRAILIAN PINE TREE
- GOLD TREE
- WATER METER
- PALM TREE
- UNIDENTIFIED TREE
- PALM TREE CLUSTER
- 3.7 EXISTING ELEVATION
- (3.95) PROPOSED ELEVATION
- PROPOSED SILT FENCE

SURVEYOR'S CERTIFICATION:

"RECORD DRAWING" DATA FROM FIELD LOCATION ON 2-15-07 AS PER MEASUREMENTS TAKEN UNDER MY SUPERVISION AS SHOWN BOLD AND IN BRACKETS HEREON, PROVIDED BY:
CALVIN J. REED, PLS
4600 TRI PAR DRIVE
SARASOTA, FL. 34234
(941) 351-2317

CALVIN J. REED
FL. PLS #2915

"RECORD DRAWING"

RECORD DRAWING

RECORD INFORMATION SHOWN **[BRACKETS]** PROVIDED BY BANKS ENGINEERING, INC.

RECORD INFORMATION SHOWN **(IN PARENTHESES)** PROVIDED BY CONTRACTOR UNDER OBSERVATION OF ENGINEER

PREPARED FOR:

TERENCE BLACKMAN
741 HIDEAWAY BAY DRIVE
LONGBOAT KEY, FLORIDA 34228
PH (941) 955-7096

NO.	DATE	REVISION DESCRIPTION	BY
03	05/16/07	REVISED TO INCLUDE RECORD DIMENSIONS, AS PER CJR.	PJB
02	06/07/06	AMENDED LANDSCAPE ISLAND AT CULDESAC, ADD CURB DETAIL	SPM
01	08-24-05	REVISE POND AND OUTFALL FOR NO WETLAND IMPACT, ADD WETLAND LINE	JGS

Banks Engineering, Inc.
Professional Engineers, Planners, & Land Surveyors
SARASOTA ◆ FORT MYERS ◆ NAPLES
1144 TALLEVAST ROAD, SUITE 115
SARASOTA, FLORIDA 34243
PHONE: (941)360-1618 FAX: (941)360-6918
ENGINEERING LICENSE EB-0006469
SURVEY LICENSE LB-0006690

SHANE C. COOPER
PE# 53998
MAY 16 2007
DATE

PAVING, GRADING, DRAINAGE, UTILITY AND B.M.P. PLAN

MANGROVE BAY

MANATEE COUNTY

DATE	PROJECT	DRAWING	DESIGN	DRAWN	CHECKED	SCALE	SHEET	OF	FILE NO. (S-T-R)
1-28-05	6181-001		JGS	EAH	JGS	1"=30'	4	5	23-35S-16E

S:\Jobs\6181\6181-001\Engineering\Record Drawing\PCD\04-6181-001_PCD.dwg, 5/16/2007 12:25:05 PM, Pat Brown