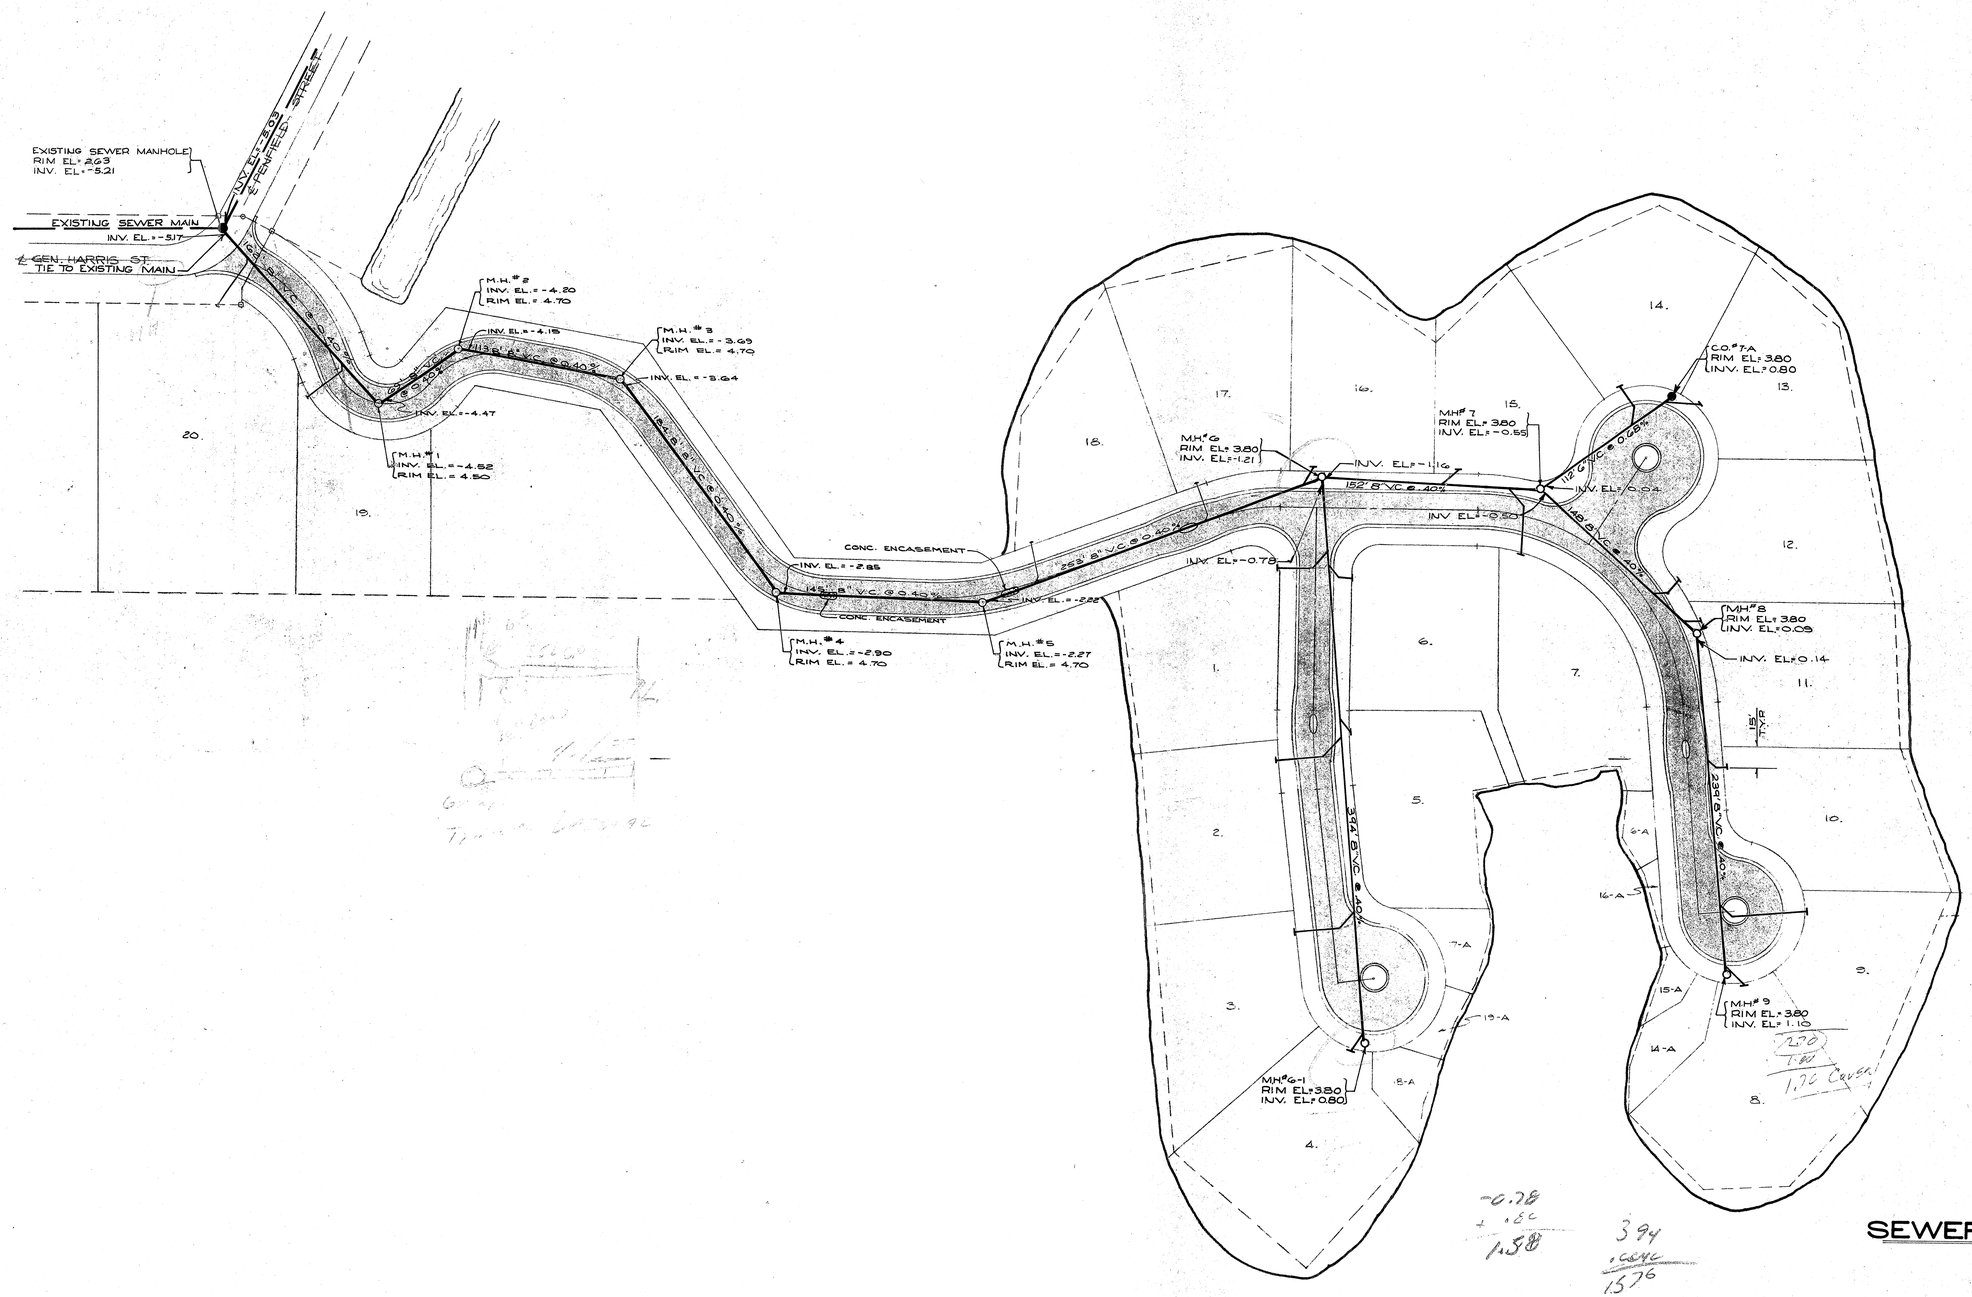

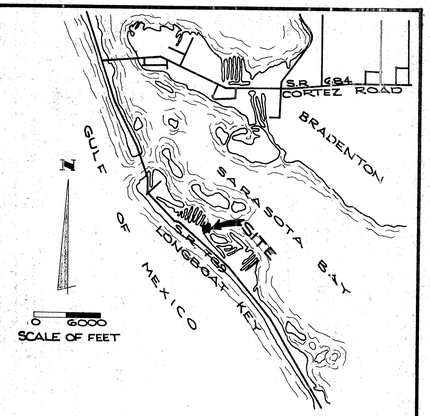

LOCATION MAP

NOTE:
MANHOLE 5 FT. INSIDE R/W LINE
IN LOT AREAS.

SEWER COLLECTION PLAN

FOR

HIDEAWAY BAY SUBDIVISION

IN

SEC. 23, TWP. 35 S., RGE. 16 E.
MANATEE COUNTY, FLORIDA

DESIGNED R.J.L.	DATE 10-6-75
DRAWN R.W.	JOB NO. 123
CHECKED R.J.L. & M.S.D.	SCALE 1"=50'
APPROVED R.J.L.	SHEET 1 OF 4
REVISED	
1.	3.
2.	4.

ROBERTS & ZOLLER, INC.
CONSULTING ENGINEERS
ENGINEERING, SURVEYING, PLANNING
P.O. BOX 12
BRADENTON, FLORIDA 33506

STARPAY PRODUCTS INC. PORT WASHINGTON, N.Y.