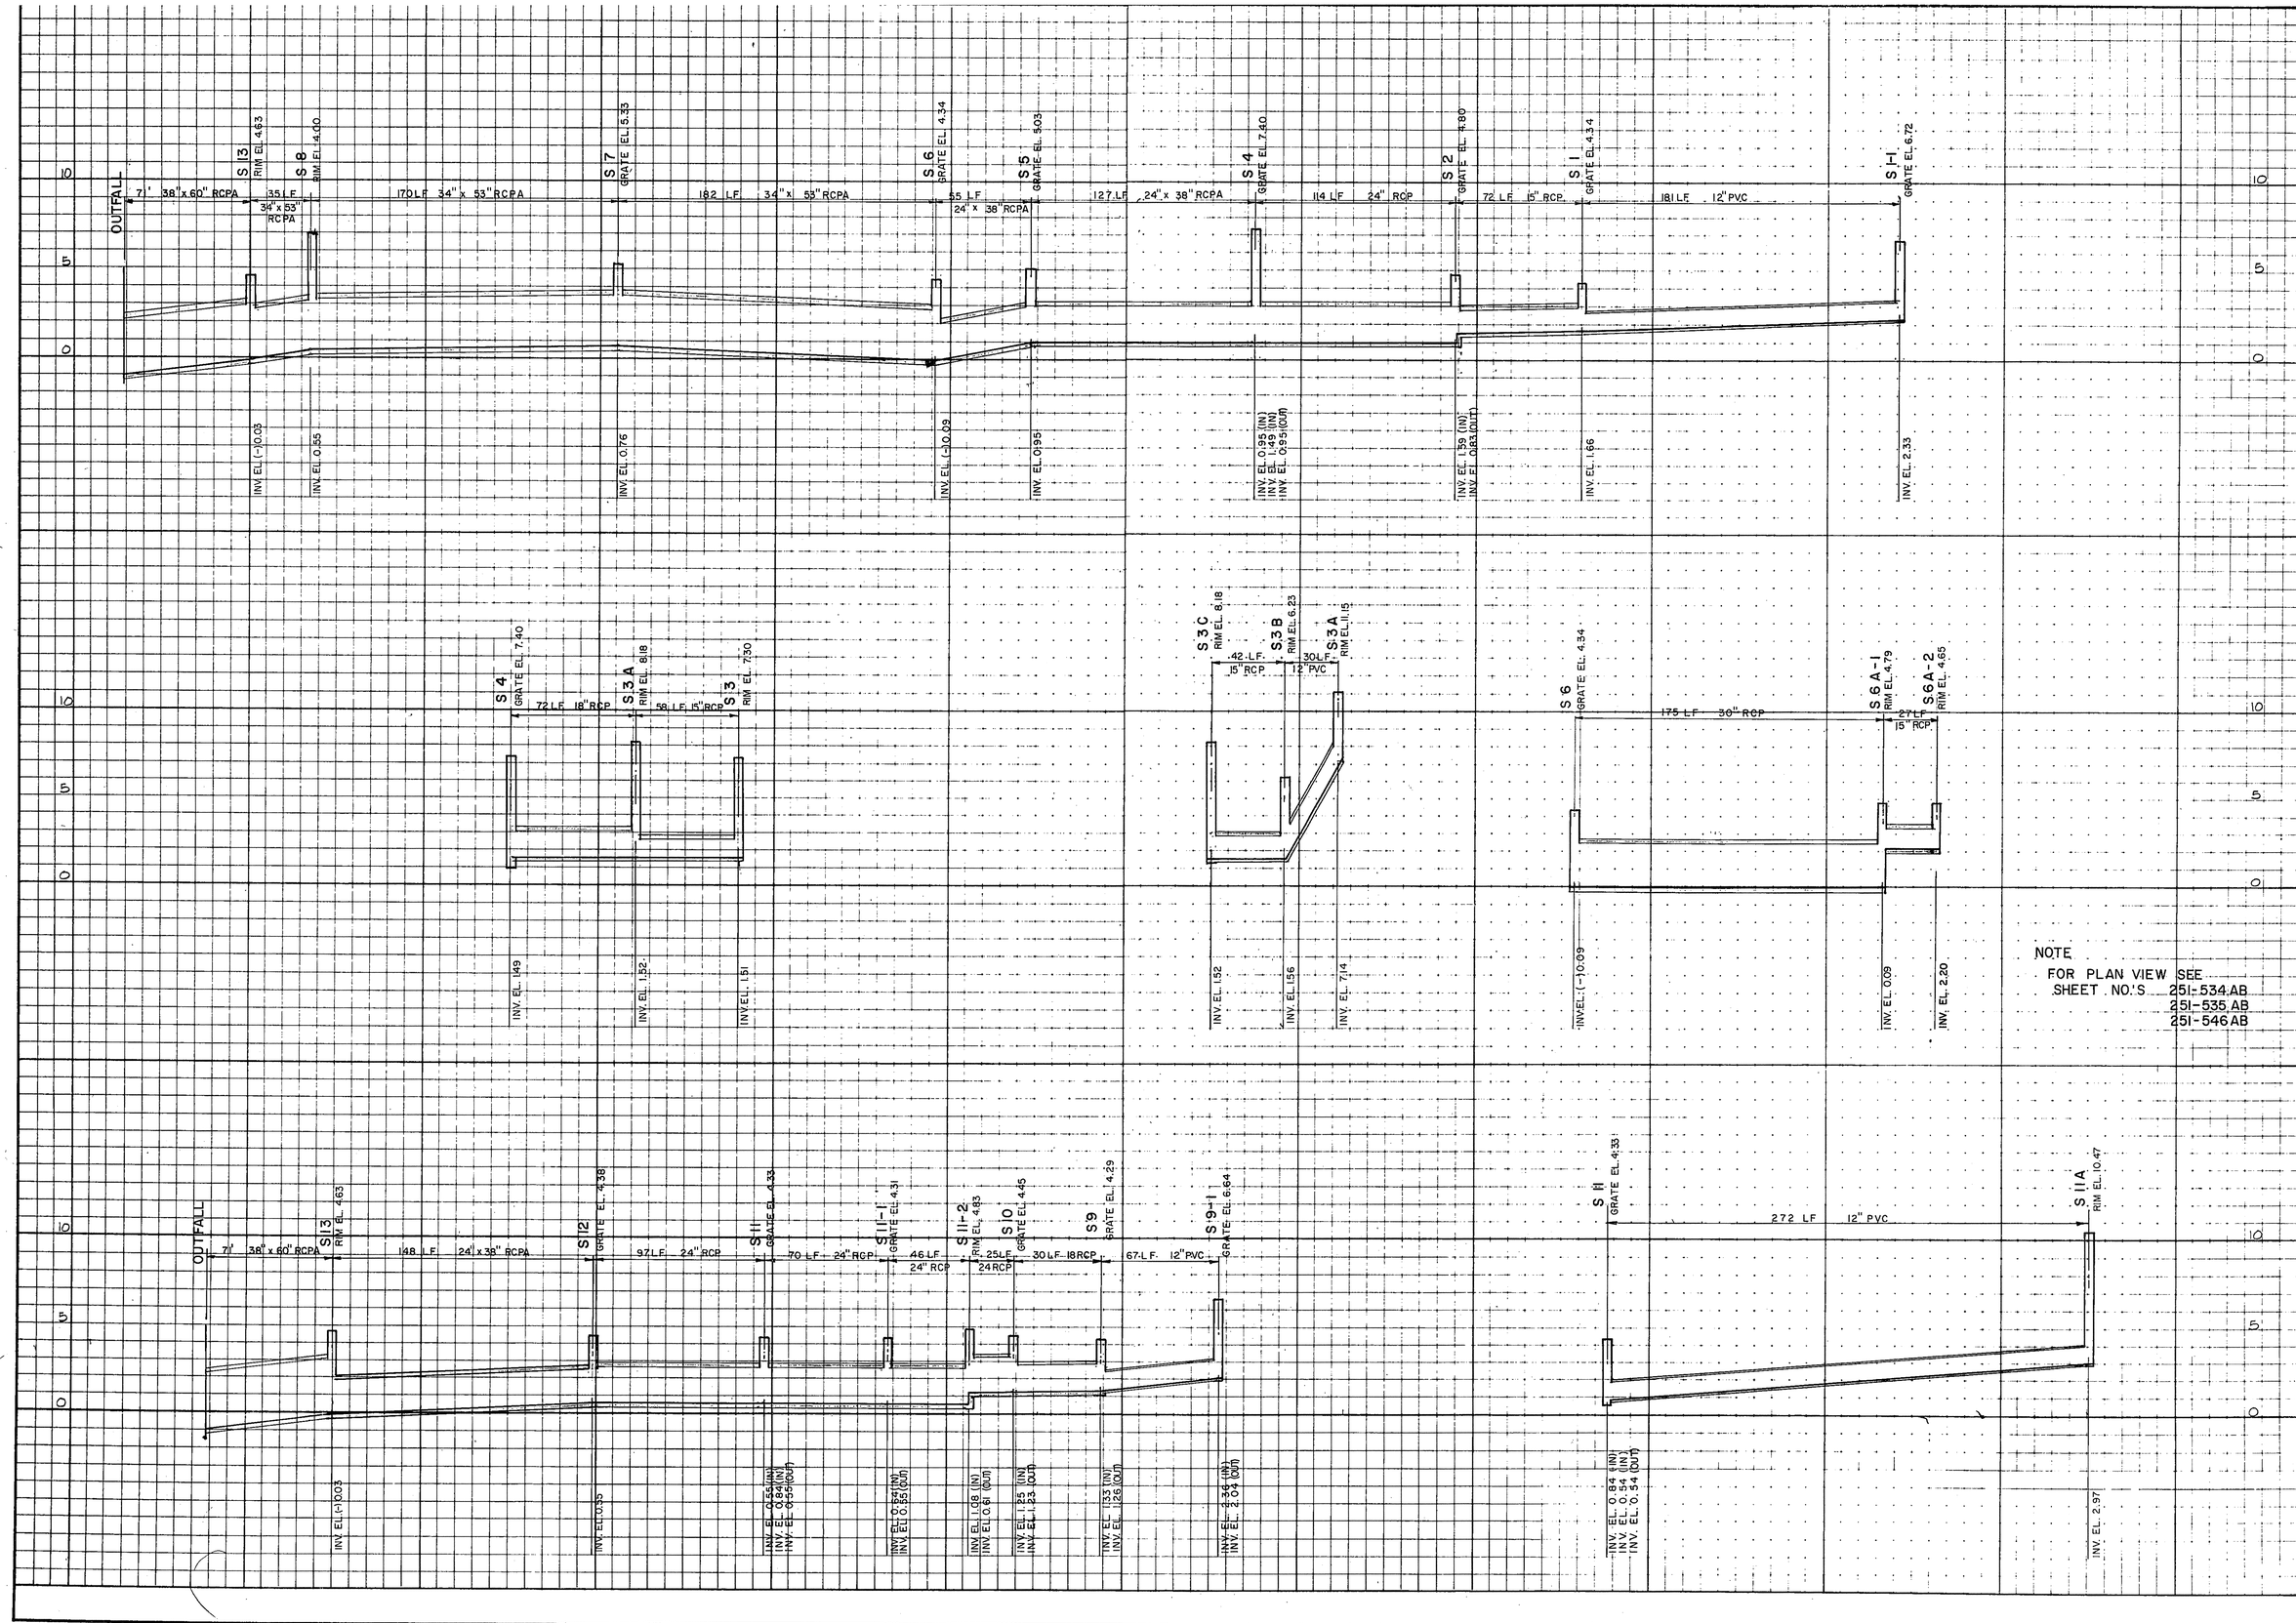

PROJECT ENGINEER	
DESIGNED BY	DATE: 11-17-83
PROJECT NO.	
CHECKED BY	SCALE: HORIZ. 1" = 40' VERT. 1" = 4'
DRAWN BY	

LTR.	DATE	REVISION	BY

TOWN OF LONGBOAT KEY, FLORIDA

ARVIDA CORPORATION

INN ON THE BEACH — AS BUILT

STORM SEWER PROFILE

ENGINEER & LOCATION: BENNETT & BISHOP, INC. — CONSULTING ENGINEERS & SURVEYORS — 4309 BEE RIDGE RD. SARASOTA, FLORIDA

SHEET NUMBER 251 - 509AB

REVISION

T.L.K. FILE NO.