AF 43776

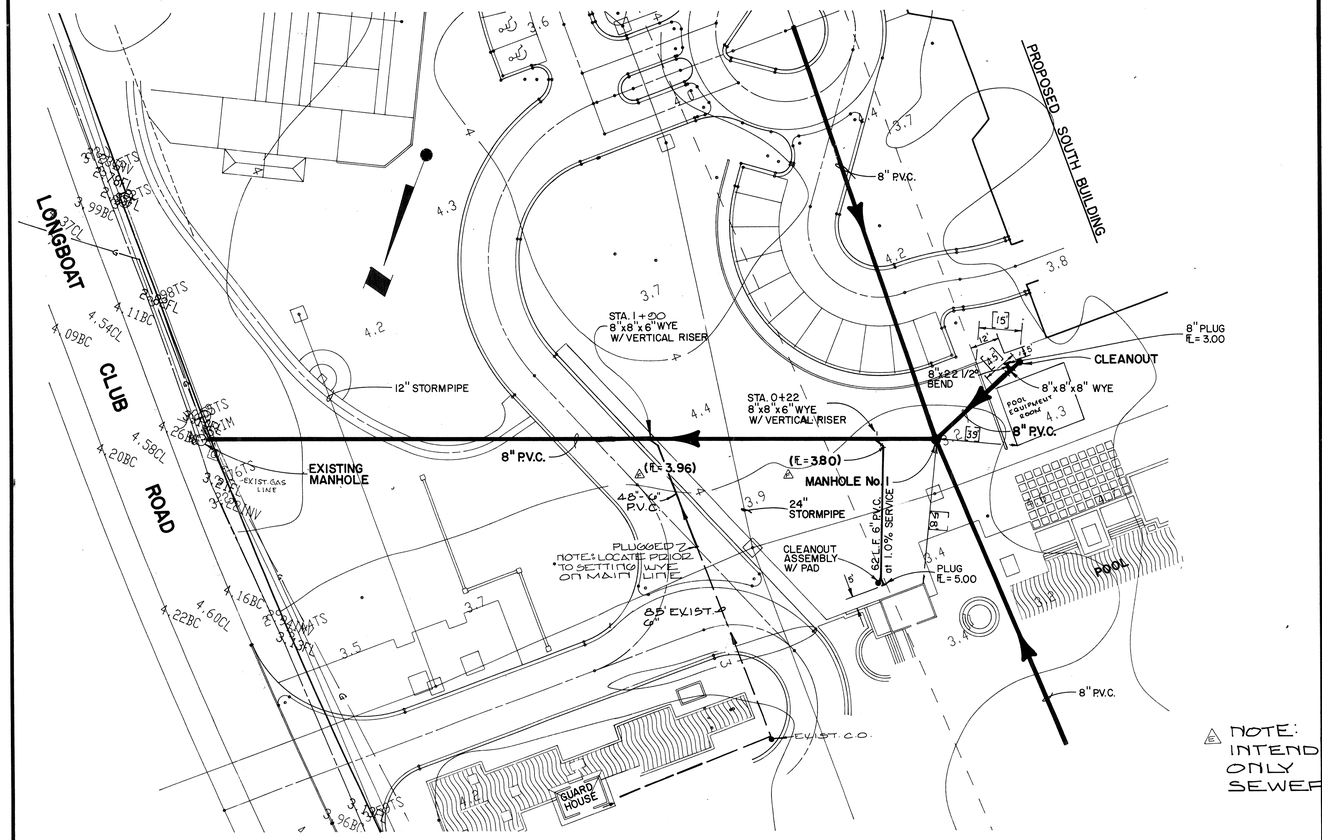

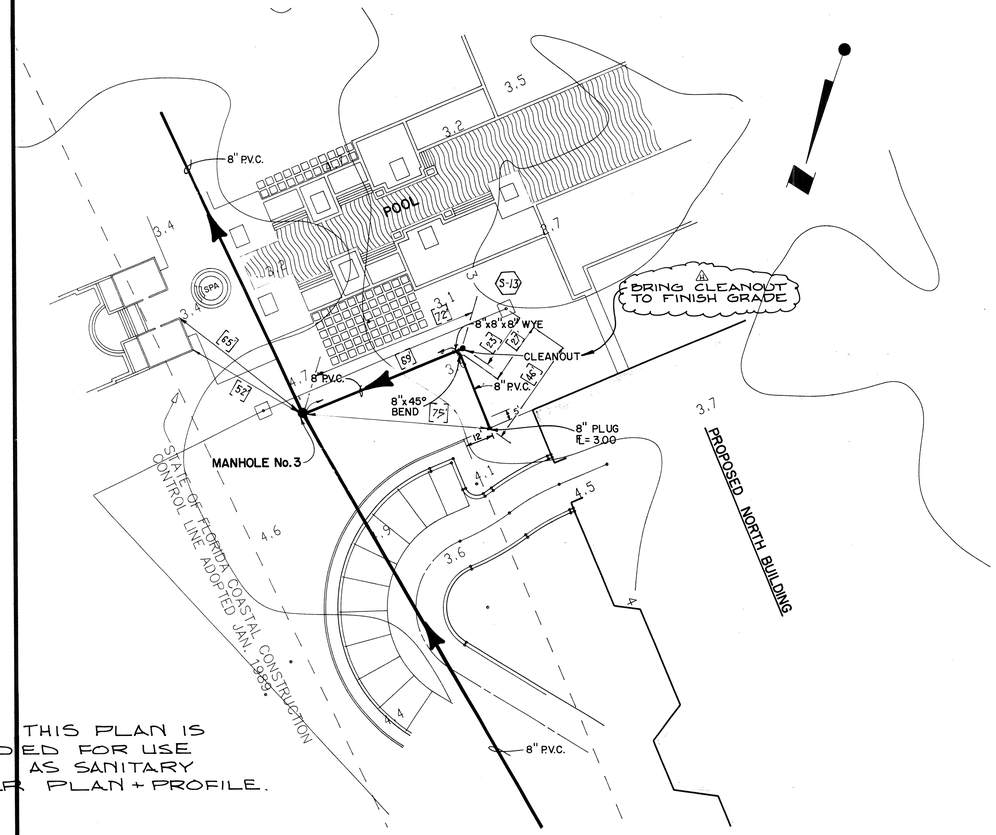

NOTE: THIS PLAN IS INTENDED FOR USE ONLY AS SANITARY SEWER PLAN + PROFILE.

NOTE: DATA IN BRACKETS CONFORM DRAWINGS TO CONSTRUCTION RECORDS BY TRI-D SEPTEMBER 1992

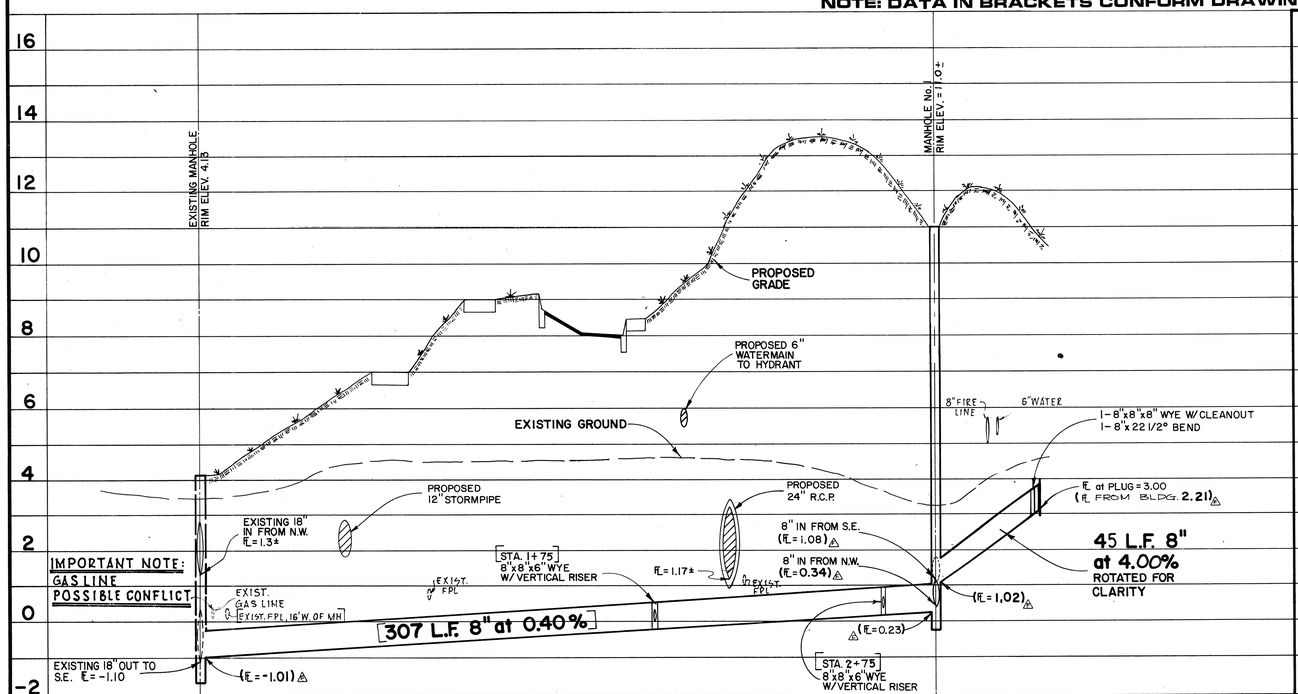

WASTEWATER SERVICE CONSTRUCTION:

SEWER SERVICE LENGTHS SHOWN ARE HORIZONTAL MEASURE. THE CONTRACTOR SHALL INCLUDE VERTICAL RISERS, BENDS, FITTINGS, ETC. TO OBTAIN PROPER ELEVATION OF FLOWLINES (FL) AS SHOWN ON PLANS. IN PRICE BID FOR ITEM REFERRED TO IN THE BID SCHEDULE AS 6" SERVICE PIPE. ALL SERVICES WILL BE MEASURED "AS-BUILT" HORIZONTALLY AND NO ADDITIONAL COMPENSATION WILL BE MADE.

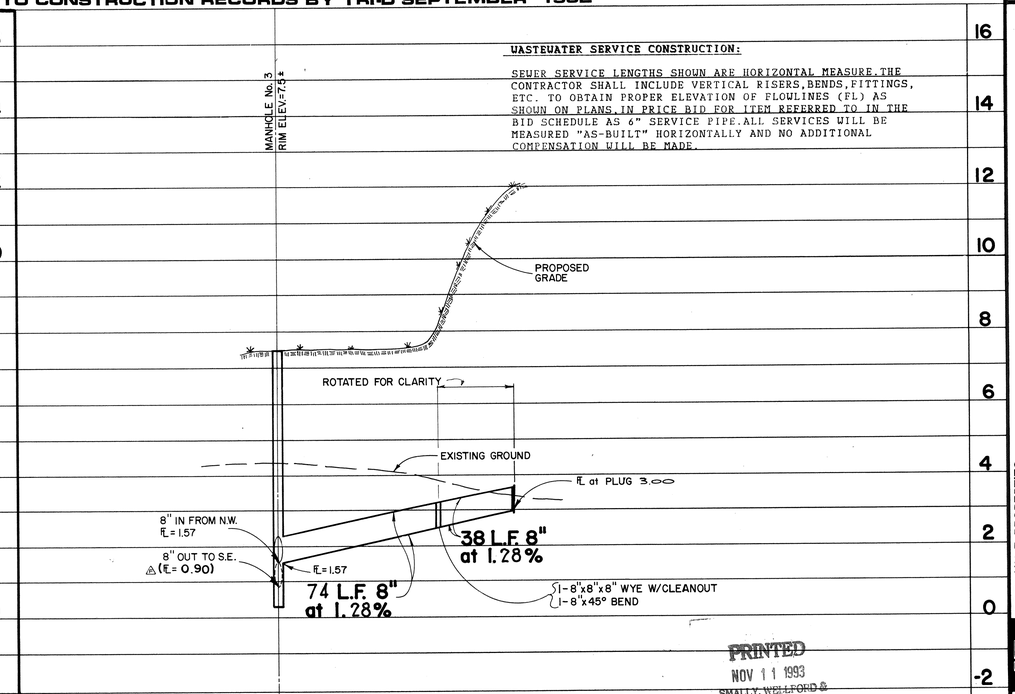

PRINTED
NOV 11 1993
SMALLY, WELLFORD & NALVEN
A DIVISION OF WILSON, MILLER, BARTON & PEEK, INC.

LTR.	DATE	REVISION	BY
"A"	10/5/90	ADDED GAS LINE TO PLAN & PROFILE	W/JEP
"B"	11/15/90	ADDED MANHOLE, REV. FL'S & ADDED MH-1	"CFG/DB"
"C"	3/1/92	REVISE LOCATION OF BY-PASS & ADD WYE RISER FROM STA. 1+39 TO 1+90	"CFG/DB"
"D"	5/1/92	REVISE MANHOLE RIM ELEVATIONS TO CONFORM TO TRI-D	"CFG/DB"
"E"	9-92	CONFORM DRAWINGS TO CONSTRUCTION RECORDS	CFG/JEP
"F"	11-92	ADD SWING TEE TO MH. ELEV. 1.93	CFG/JEP

"H" 10-16-93 ADD NOTE RE: CLEANOUT

DESIGNED BY: J.M.B.
DATE: 7/90
SCALE: HOR. 1"=30' VER. 1"=2'
DRAWN BY: R.B.K.
CHECKED BY:
PROJECT NO. 2591
MILLARD J. YODER FL. CERT. # 33765

SARASOTA, FLA. 33582
133 SOUTH McINTOSH RD.
CONSULTING ENGINEERS & SURVEYORS

FOR: YALE PROPERTIES

L'AMBIANCE SANITARY SEWER PLAN & PROFILE

SMALLY, WELLFORD & NALVEN, Inc.

DRAWING NUMBER 14
REVISION "H"

INDEX NO. G-2591-019