AF 43776

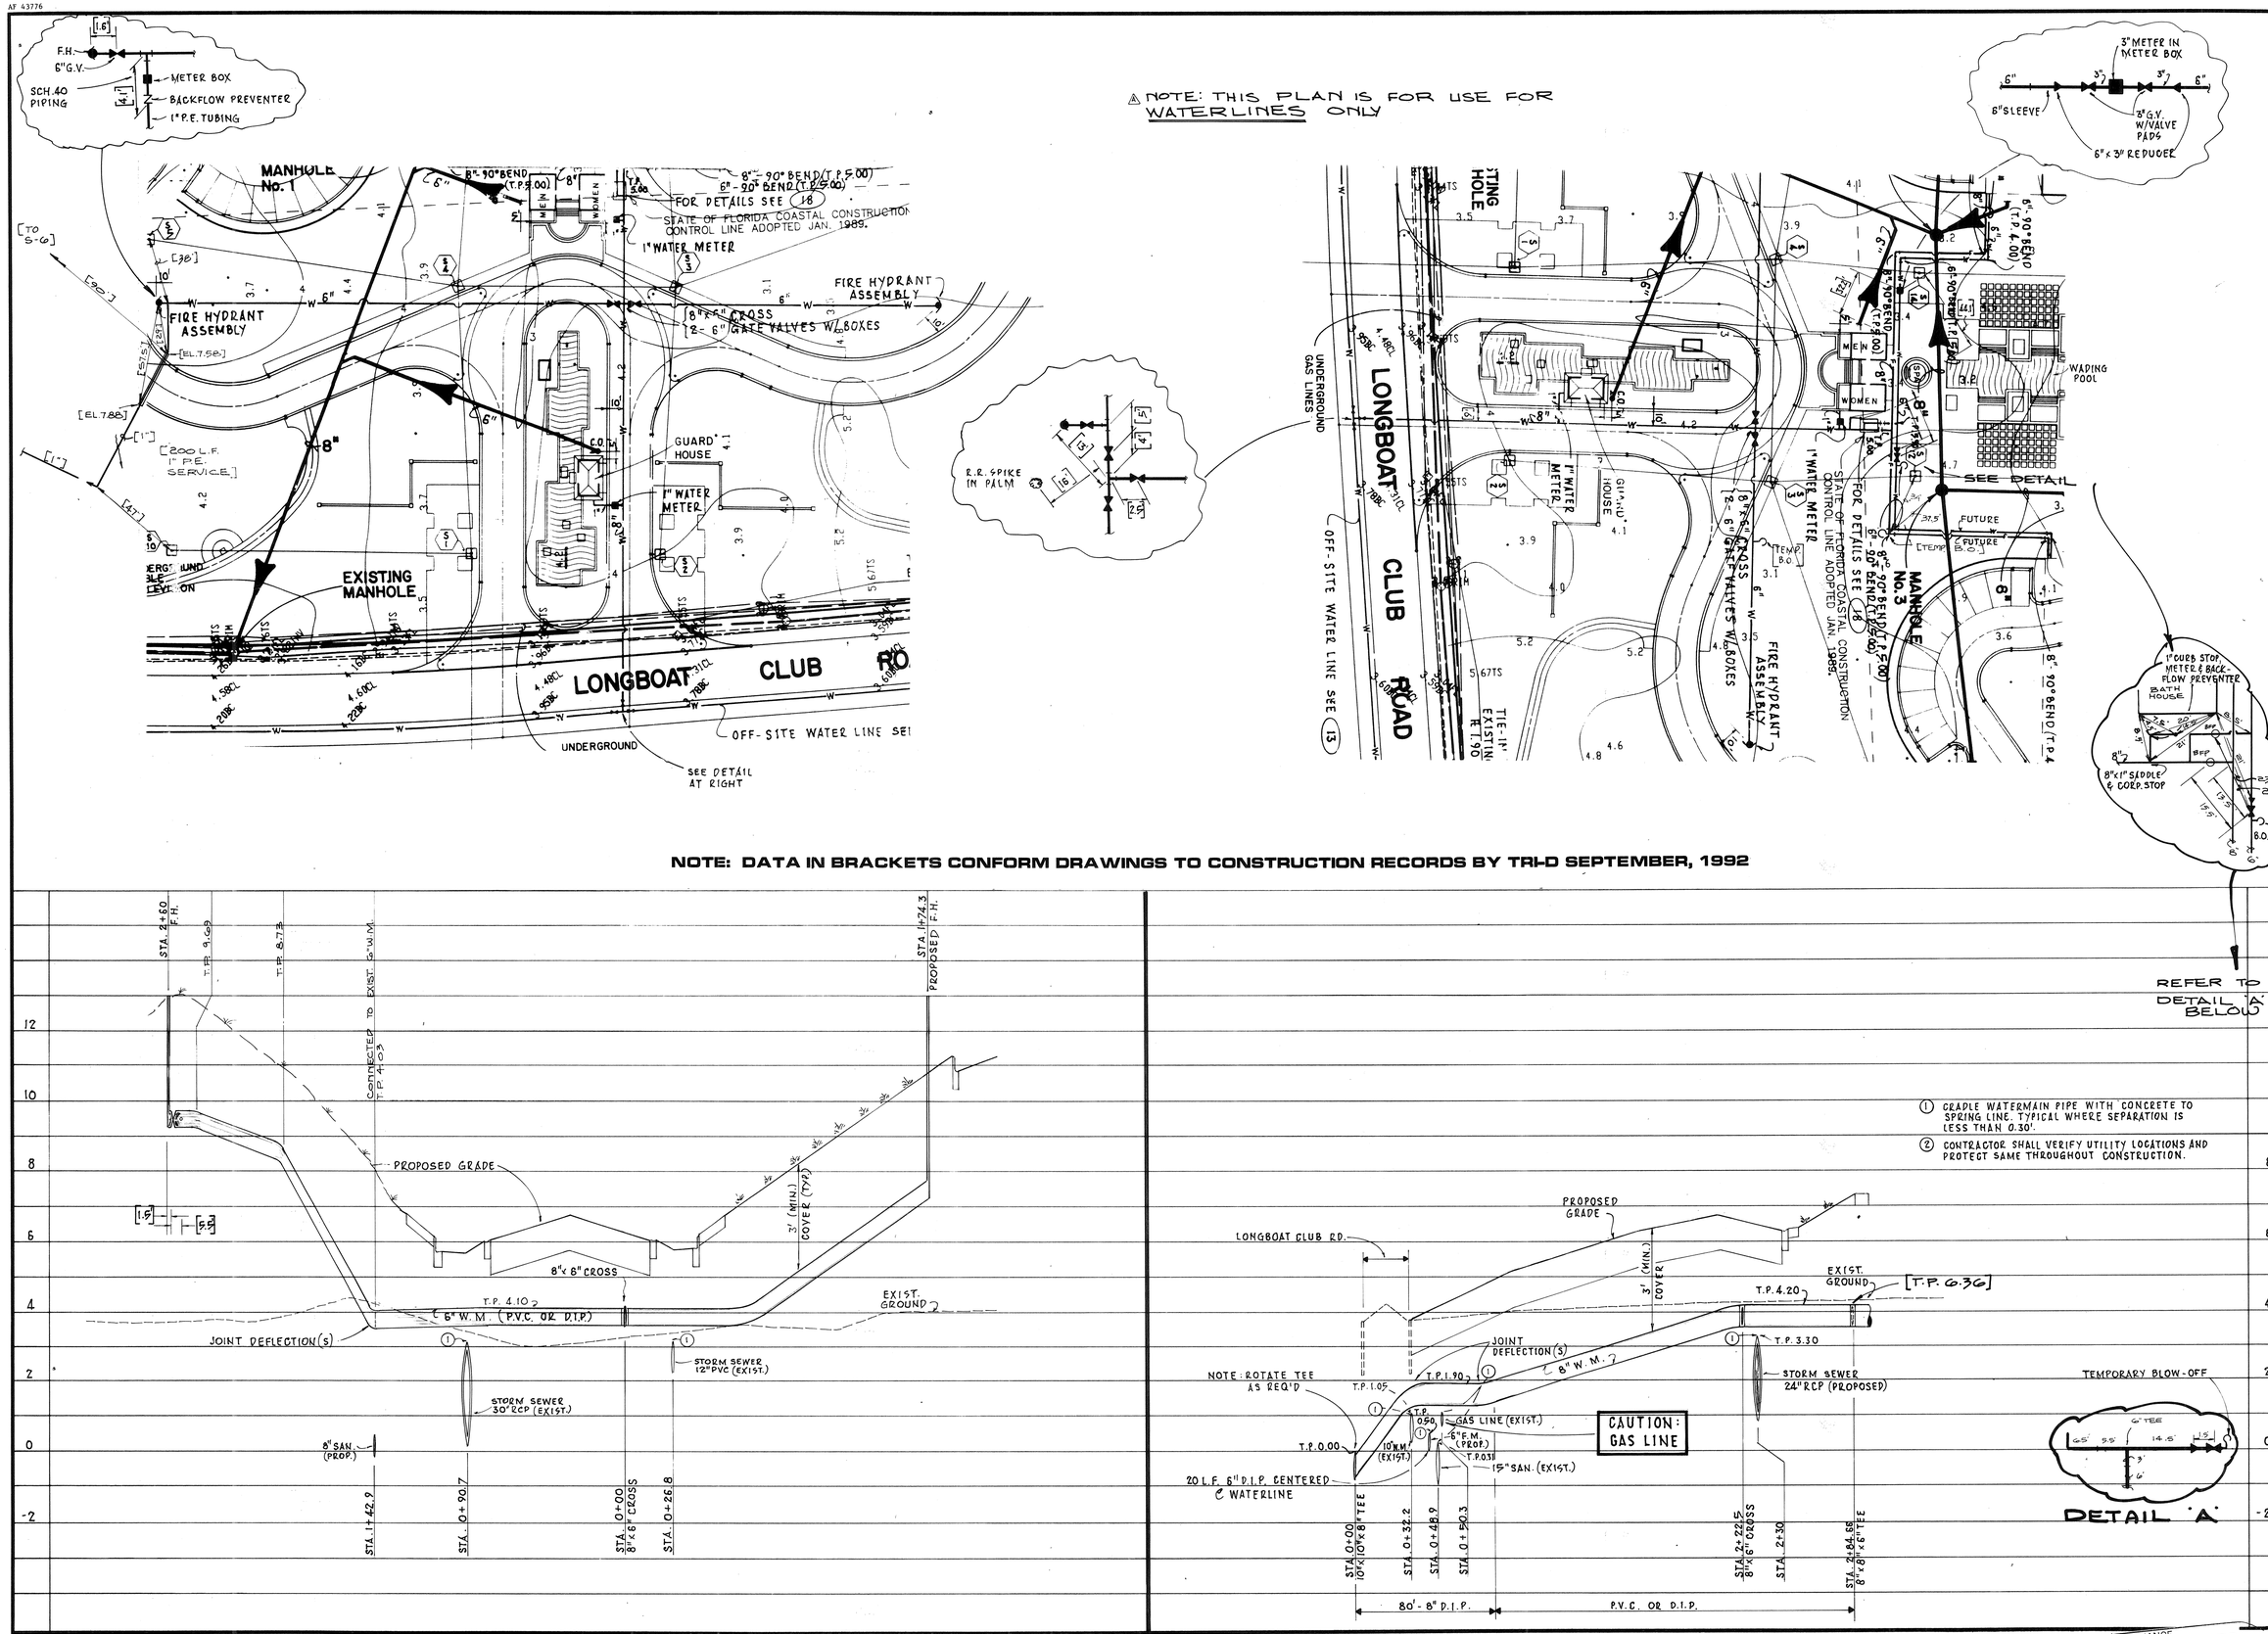

NOTE: DATA IN BRACKETS CONFORM DRAWINGS TO CONSTRUCTION RECORDS BY TRI-D SEPTEMBER, 1992

LTR.	DATE	REVISION	BY
A	7-7-92	ADD WATER LINE TO SITE	NOVAKOVIC
B	11/4/92	ADD RECORD DWG. INFO.	GRE/EP

DESIGNED BY	M.J.Y.
DATE:	DEC., 1990
SCALE:	HOR. 1"=40' VERT. 1"=2'
CHECKED BY	MILLARD J. YODER, P.E.
PROJECT NO.	2591
DRAWN BY	E.P.
FL. CERT. NO.	SARASOTA, FLA. 33582

133 SOUTH McINTOSH RD.

CONSULTING ENGINEERS & SURVEYORS

SMALLY, WELLFORD & NALVEN, Inc.

L'AMBIANCE

WATERLINE PLAN & PROFILE

FOR: YALE PROPERTIES

DRAWING NUMBER 19

REVISION "C"

INDEX NO. G-2591-031

L'AMBIANCE