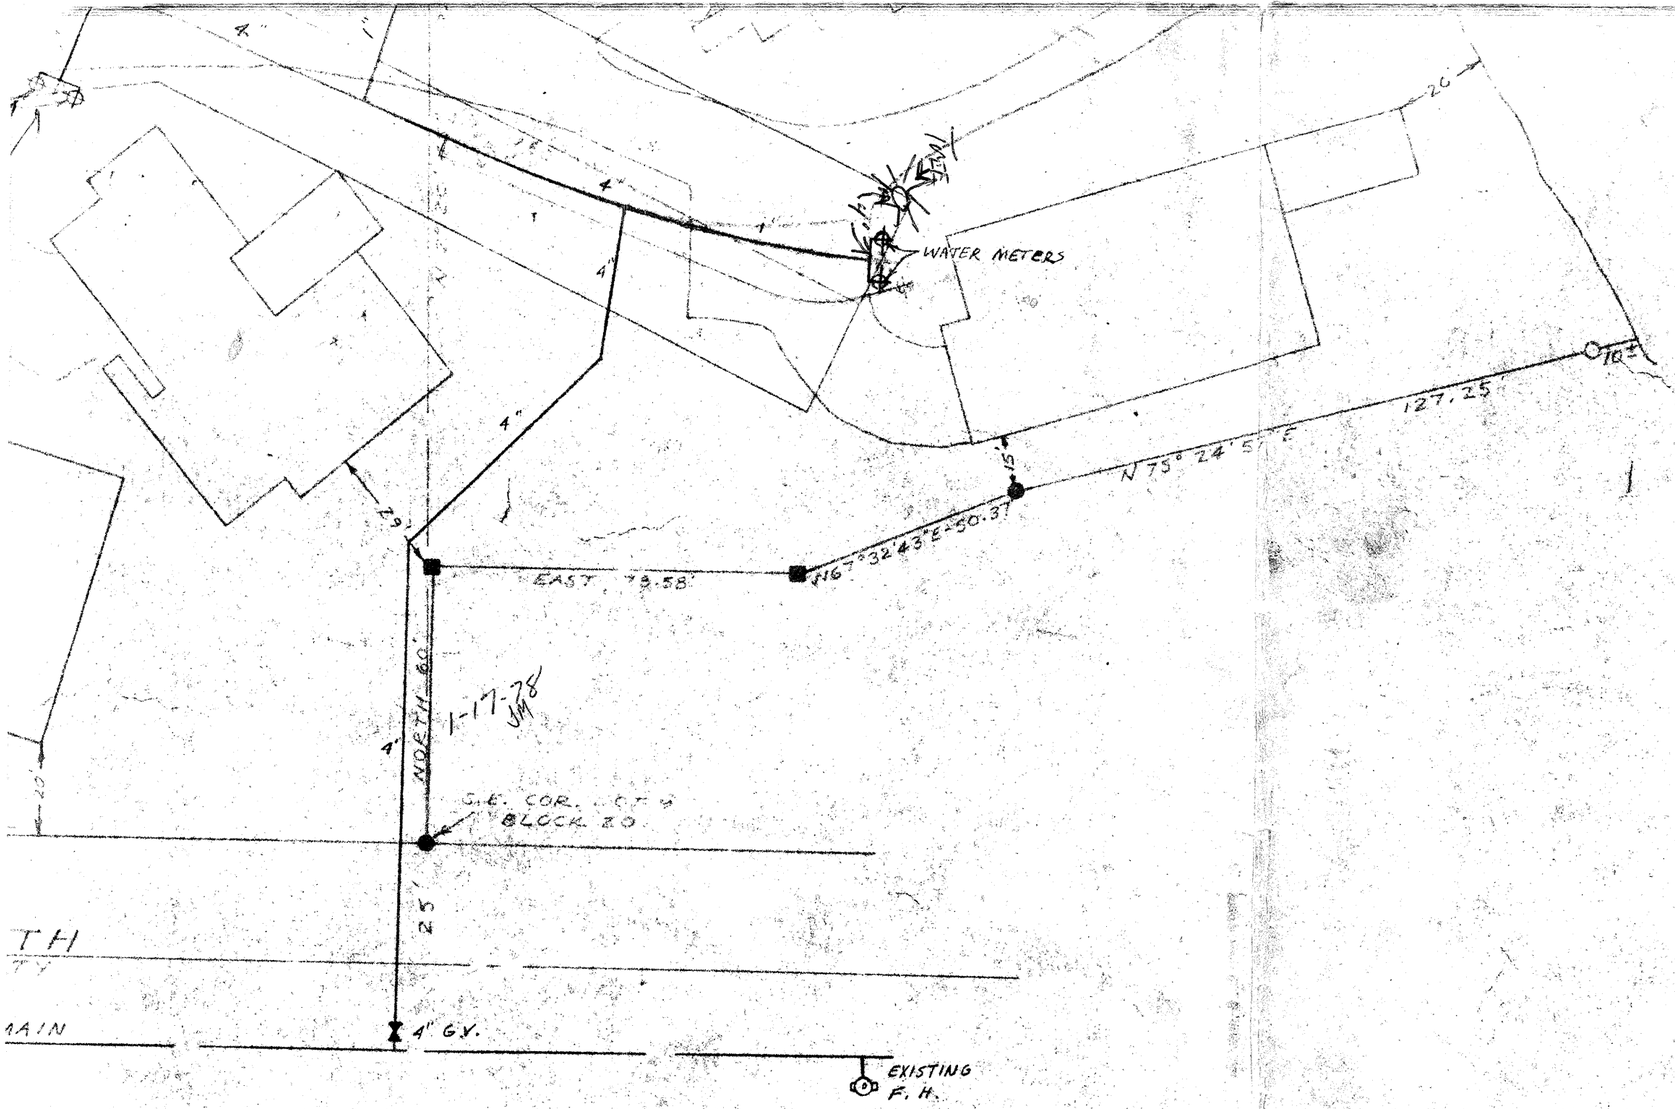

BILL OF MATERIALS	
DESCRIPTION	QTY.
6" CLASS 150 PVC	260'
4" CLASS 150 PVC	815'
1" SCH. 40 PVC SERVICE LINE	110'
6" GATE VALVE	1
4" GATE VALVE	2
MUELLER A-419 F.H.	1

NOTE:
MIN. 36" COVER ON MAINS

RECEIVED
DEC 5 1977
TOWN OF
LONGBOAT KEY

REVISED 6-22-77 WWSW.
REVISED 6-[illegible]-77 [illegible]
REVISED 5-[illegible]-77-WWSW

WATER

LAND'S END

LONGBOAT KEY, FLORIDA

TRIAD TECH., INC.
6027 17TH STREET EAST
BRADENTON, FLA. 33507
PHONE: 756-6311

DATE	SCALE	DRAWN BY
5-3-77	1" = 30'	WWSW

APPROVED James R. [illegible]
FLORIDA REGISTERED ENGINEER NO. [illegible]

SHEET 1 OF 1

STANPAT PRODUCTS — PORT WASHINGTON, N.Y.