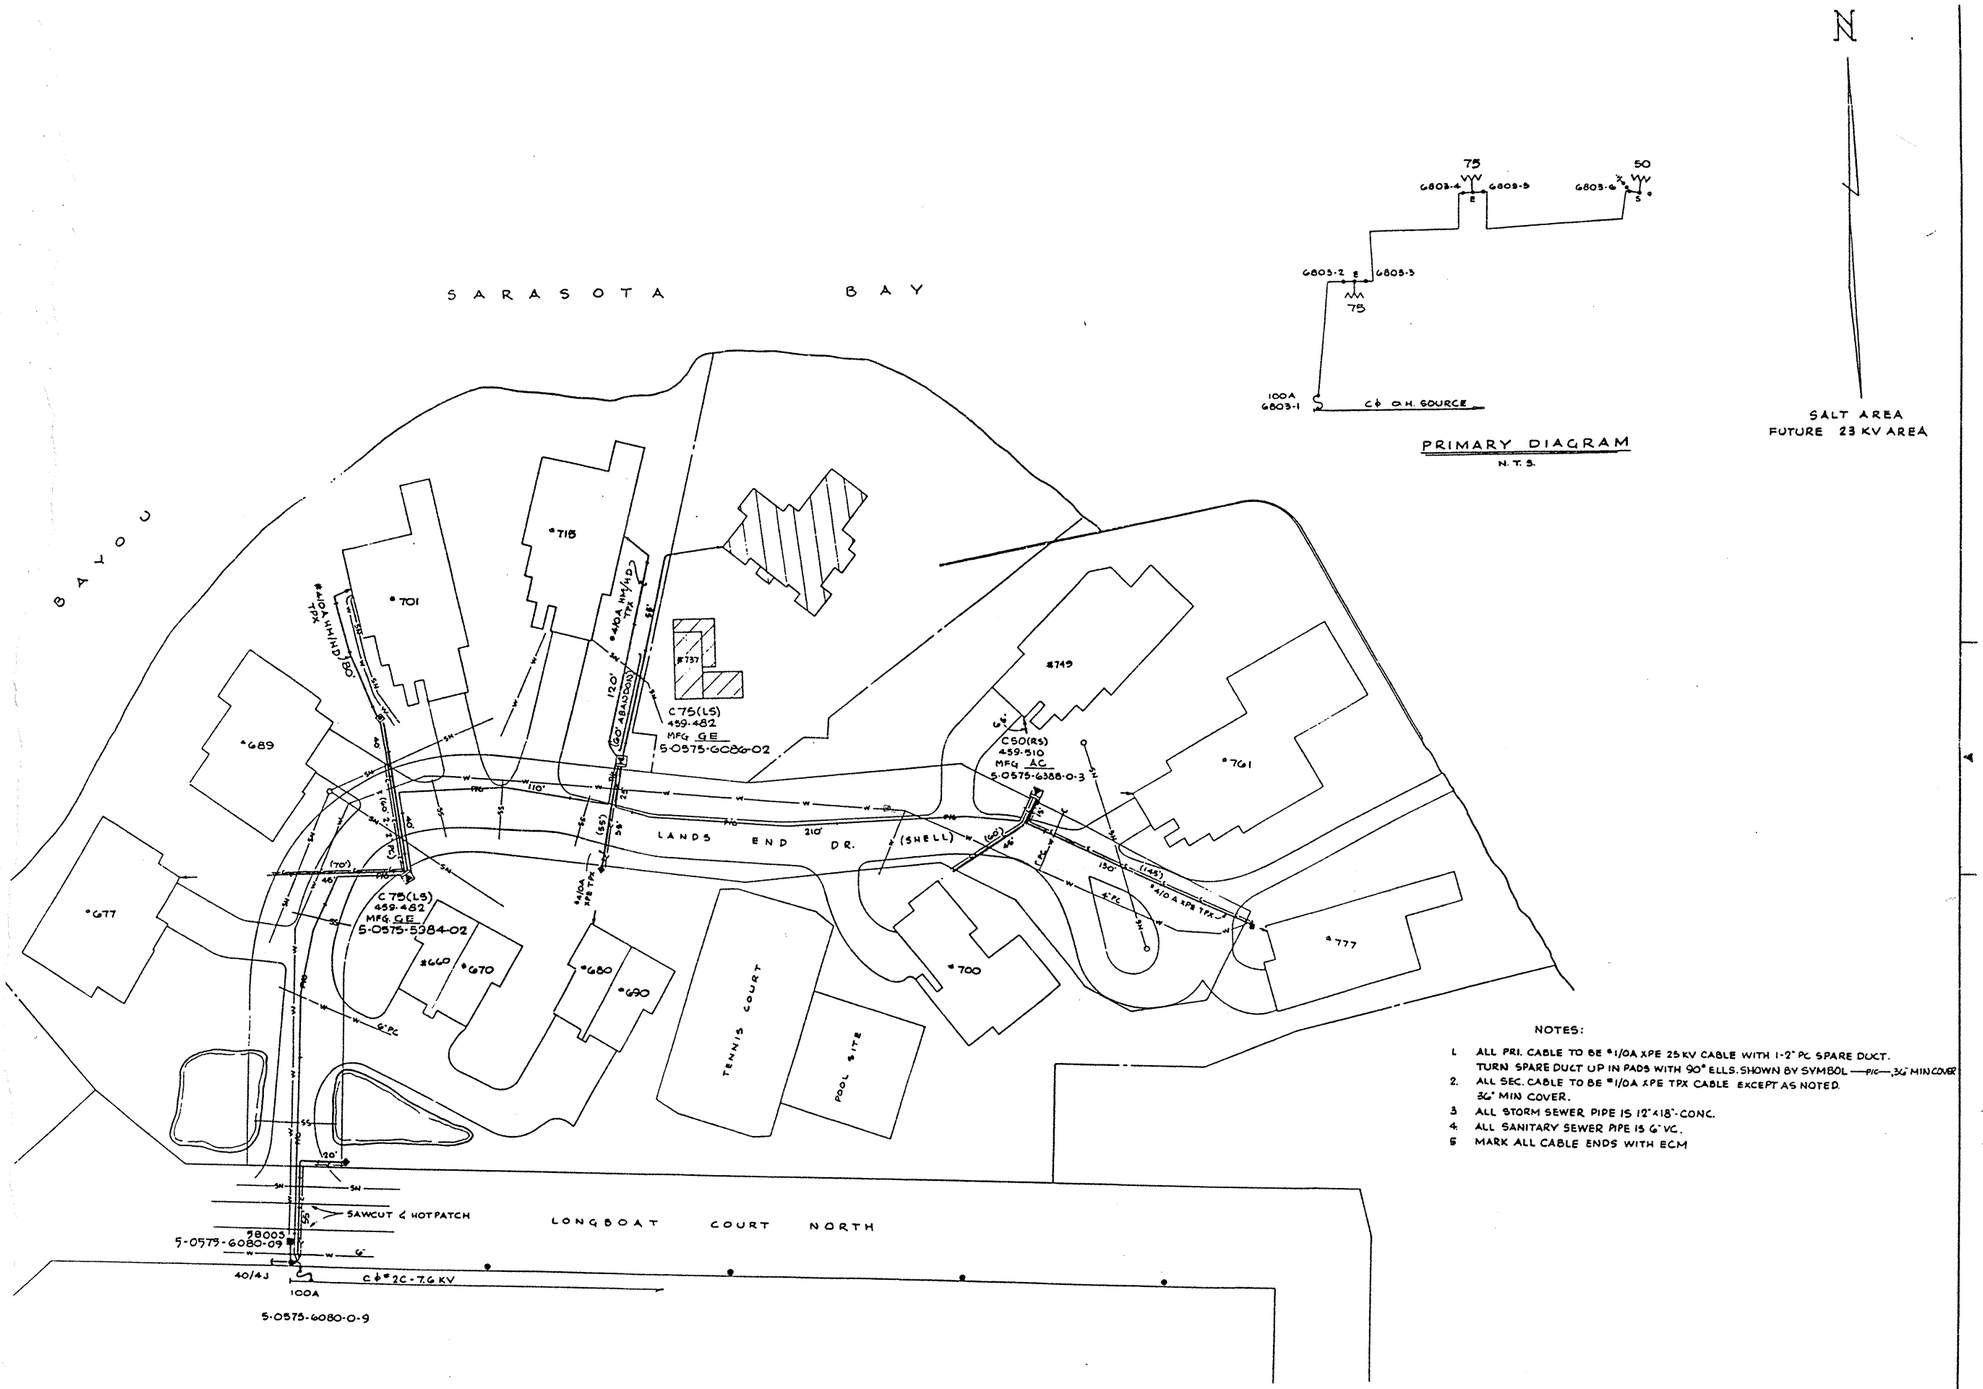

NOTES:

1. ALL PRI. CABLE TO BE #1/0A XPE 25 KV CABLE WITH 1-2" PC. SPARE DUCT. TURN SPARE DUCT UP IN PADS WITH 90° ELLS. SHOWN BY SYMBOL —PIC—, 36" MIN COVER
2. ALL SEC. CABLE TO BE #1/0A XPE TPX CABLE EXCEPT AS NOTED. 36" MIN COVER.
3. ALL STORM SEWER PIPE IS 12"x18"-CONC.
4. ALL SANITARY SEWER PIPE IS 6" VC.
5. MARK ALL CABLE ENDS WITH ECM

AUTH	NO.	DATE	REVISION	BY	CH	COR	APP
AS BUILT 5-0718-0-5060	1	10-6-78 / 10-4-78	CHG OUT 2 TX'S & RUN 2 SVC'S.				

AUTH	NO.	DATE	REVISION	TAB. PT.	BY	CH	COR	APP
AS BUILT 761-2-560	2	12-13-83	INSTALL ST LT. @ 5-0575-6080-09					
AS BUILT 5-0575-0-560	-	9-26-91	SERVICE TO LANDS END.	1060				

DATE

SCALE 0 30 60 90

FPL FLORIDA POWER & LIGHT COMPANY

DR. | ER NO.
CH | COR
APPROVED

SARASOTA
LANDS END-LONGBOAT COURT NORTH & SARASOTA BAY-LONGBOAT KEY

SHEET 1 OF 1

13112-R 316

REV NO.