


PLAN
SCALE 1" = 20'

PROFILE
SCALE: HORZ. 1" = 20'
VERT. 1" = 4'

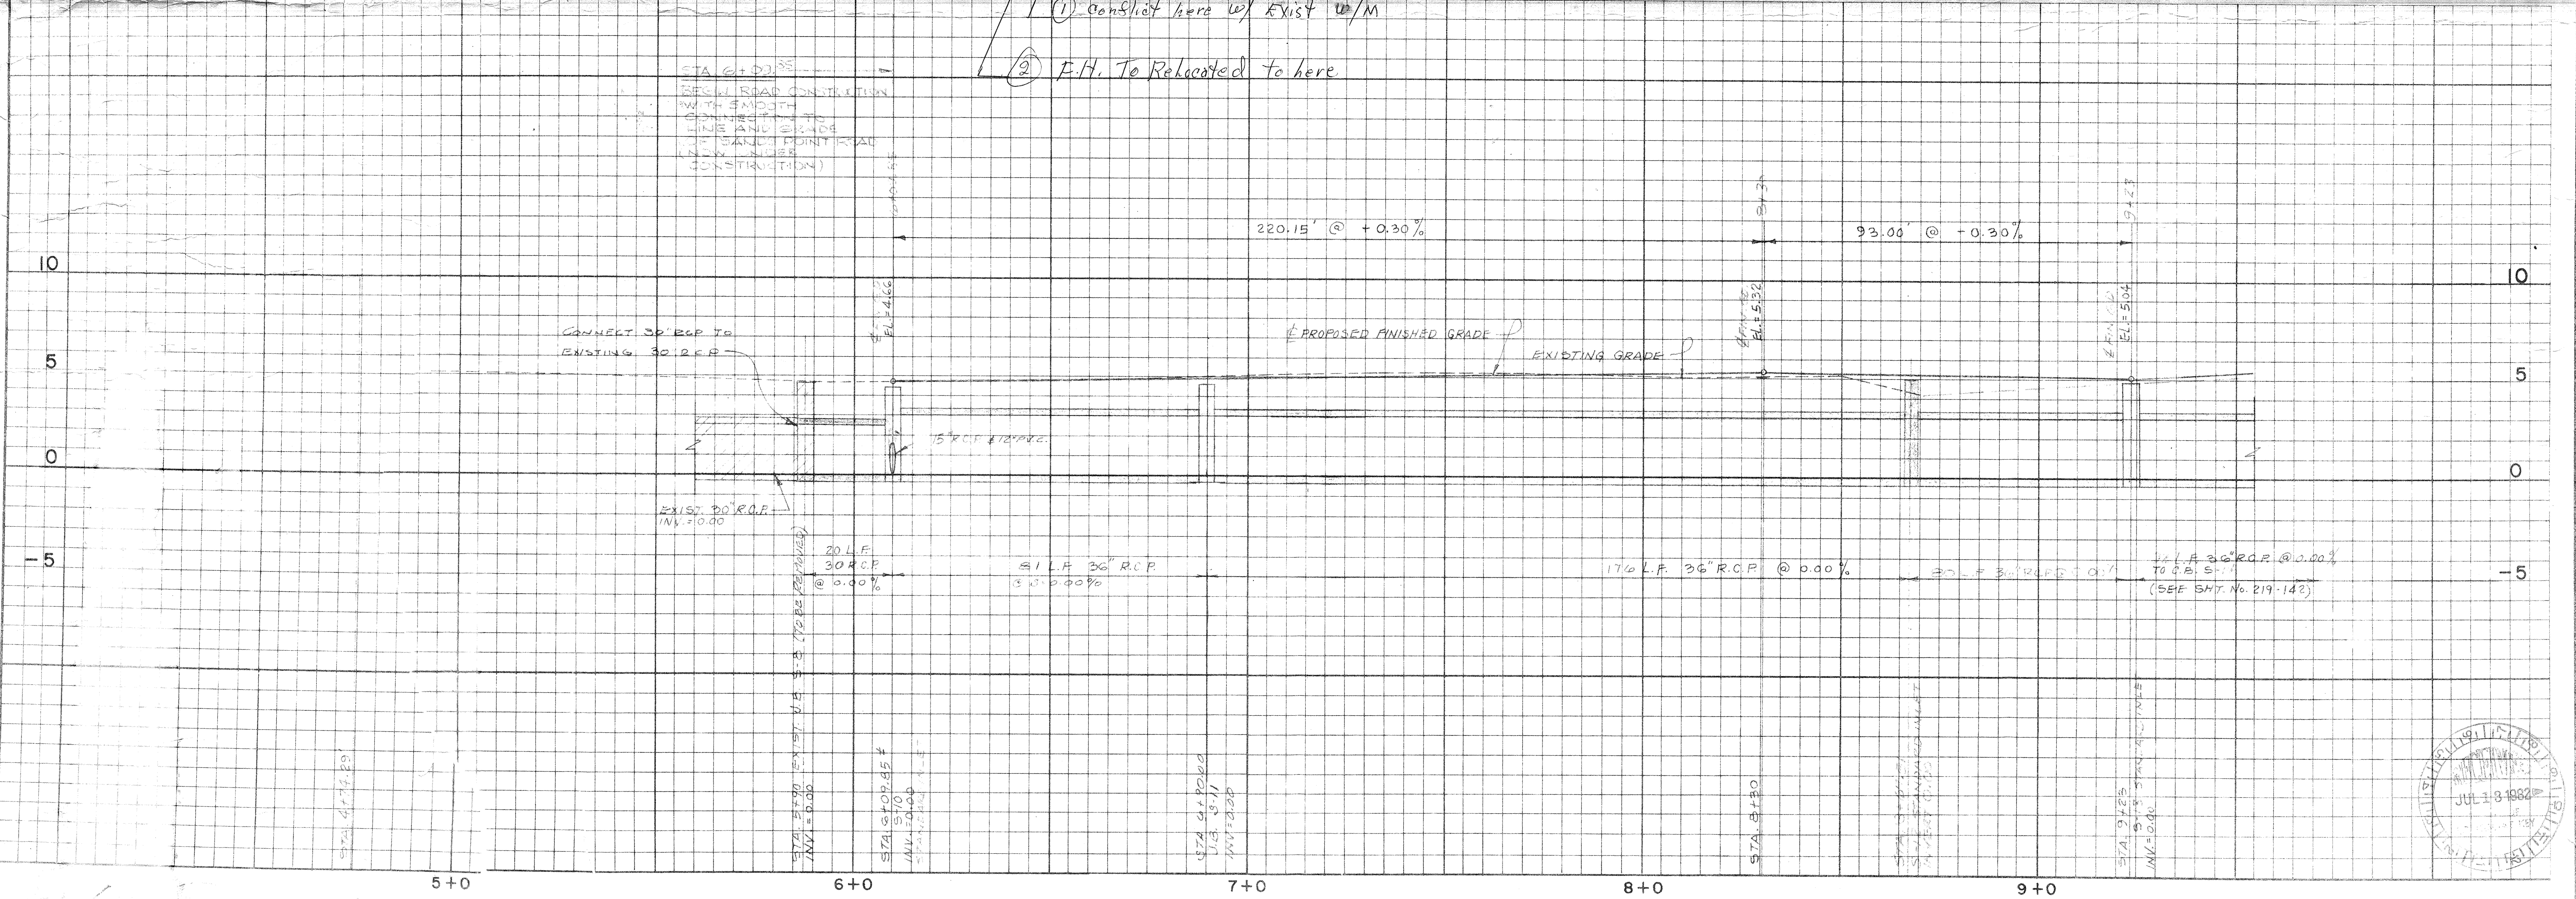

① Conflict here w/ EXIST W/M
② F.H. To Relocated to here

LAGOON

NOTE:
ADDITIONAL TIE BACKS TO BE
INSTALLED PRIOR TO CONSTRUCTION
OF PAVING LOT DESIGN TO BE
FURNISHED BY ENGINEER
PRIOR TO CONSTRUCTION.

BENNETT & BISHOP
CONSULTING ENGINEERS & SURVEYORS
SARASOTA, FLORIDA

DATE	SCALE	AS SHOWN	BY	DESCRIPTION
3-26-82				

DATE	SCALE	AS SHOWN	BY	DESCRIPTION

ARVIDA CORPORATION
LIGHTHOUSE POINT
SANDS FOOT ROAD - PLAN & PROFILE

