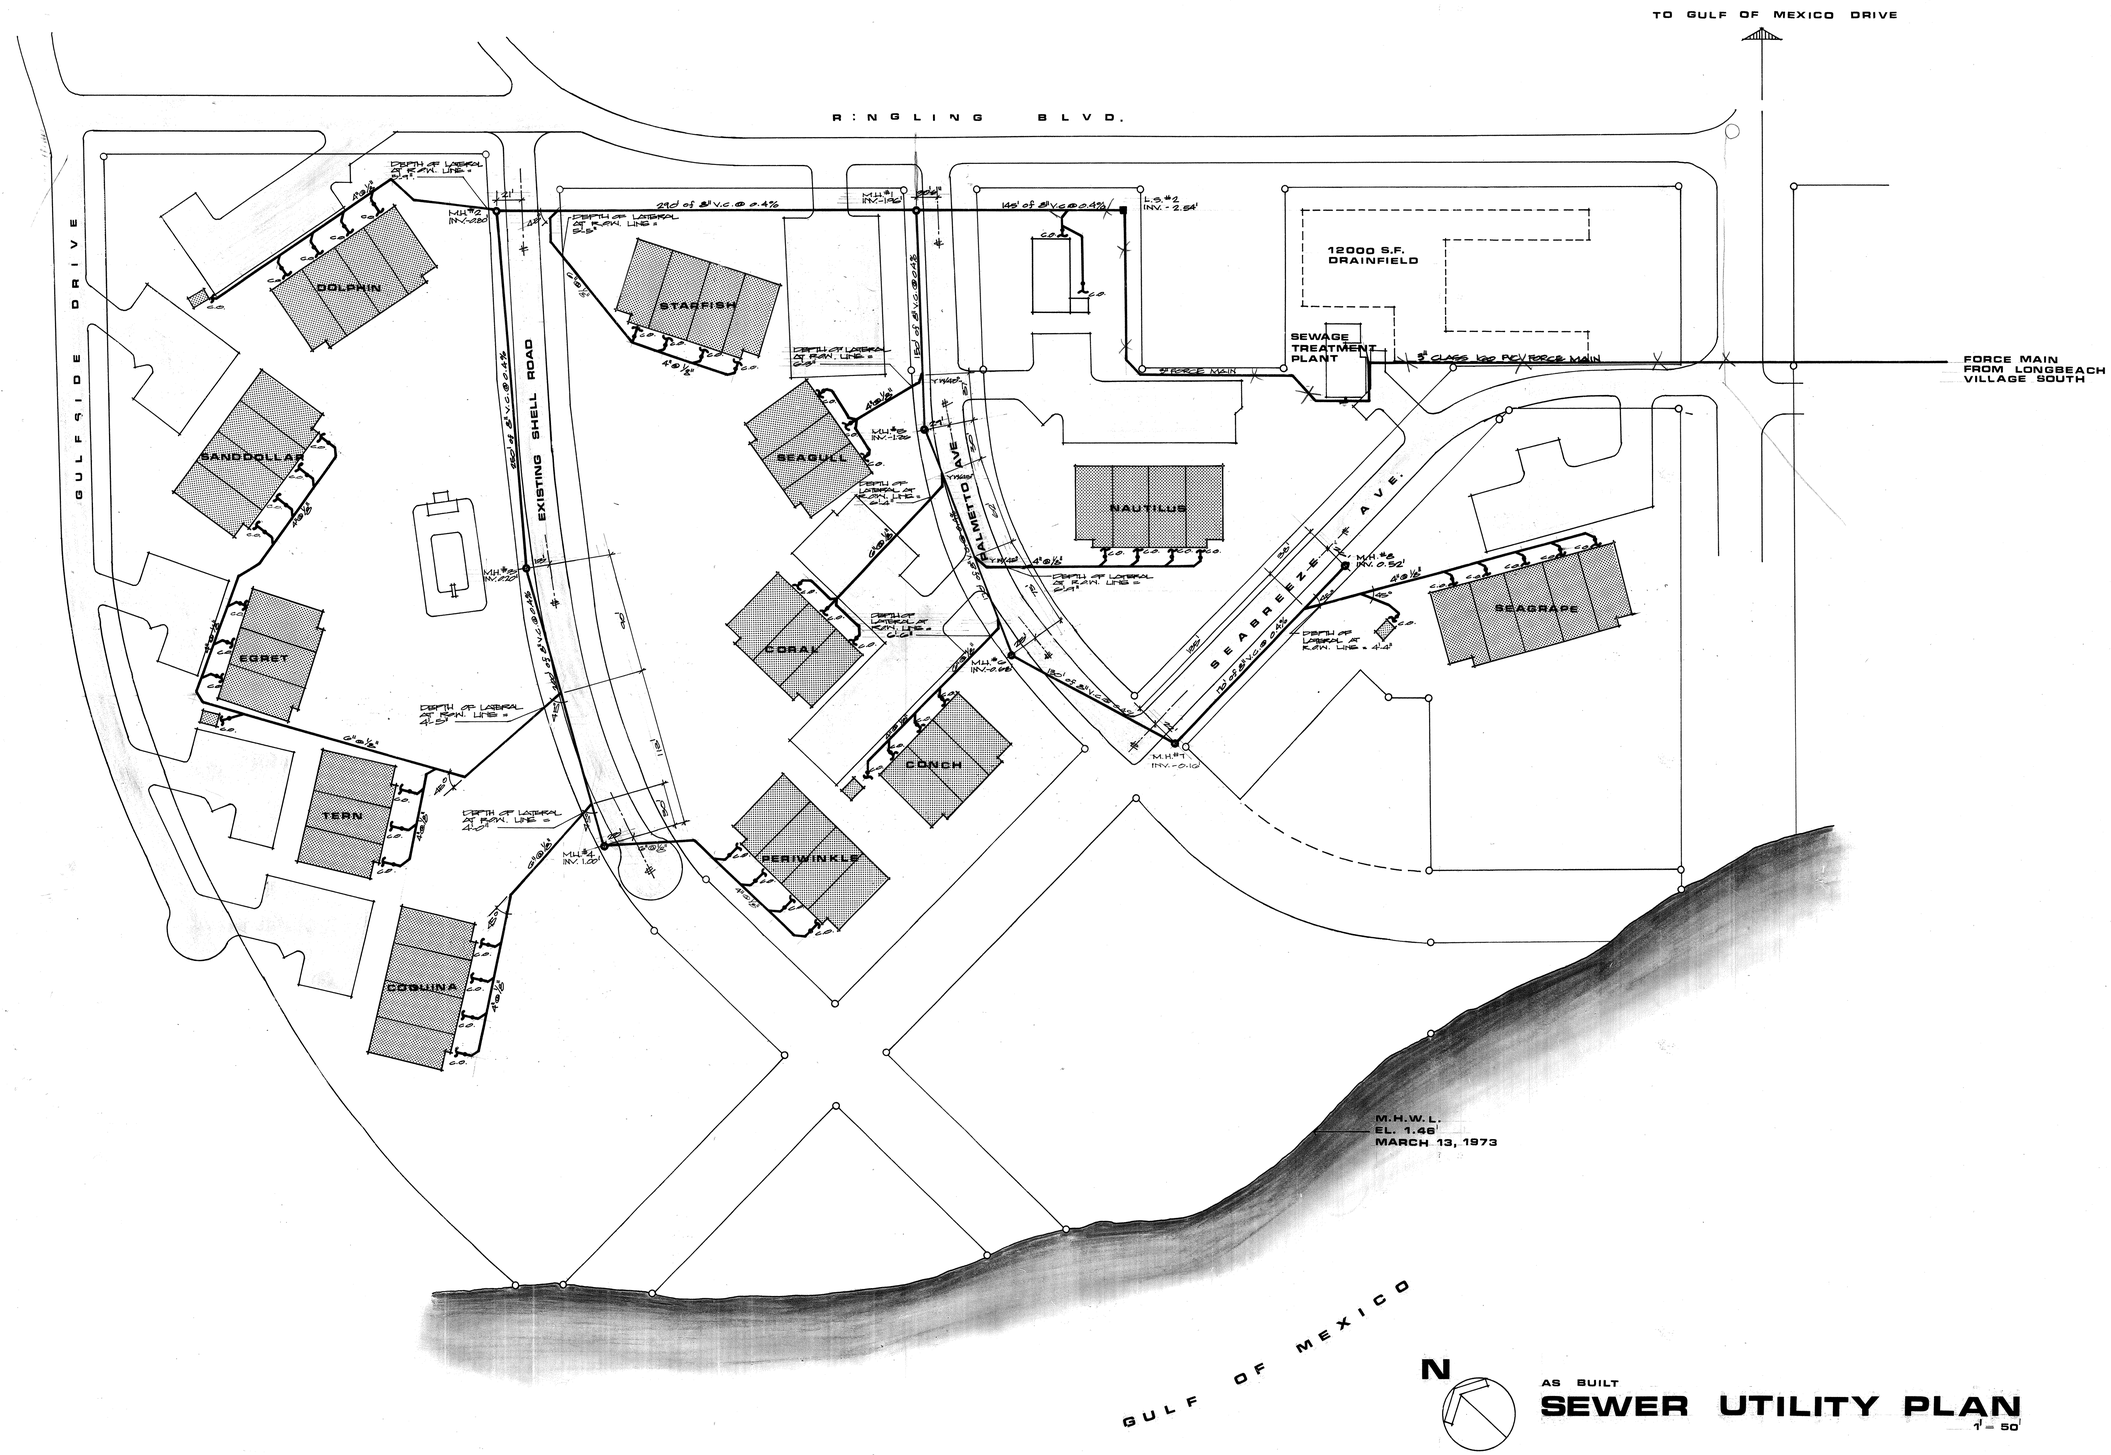

AS BUILT

SEWER UTILITY PLAN

1" = 50'

PROJECT ENGINEER	James R. Kennedy #6500
DESIGNED BY	D.A.H.
PROJECT NO.	53 - A18
DATE:	9 - 18 - 74
CHECKED BY	G.A.H.
SCALE:	1"=50'
DRAWN BY	M.Mc

BY	REVISION	LTR.	DATE

TOWN OF LONGBOAT KEY, FLORIDA

LONGBEACH VILLAGE NORTH

GULF OF MEXICO DRIVE
LONGBOAT KEY, FLORIDA

ENGINEER & LOCATION: JAMES R. KENNEDY TRIAD TECH., INC. 6111 - 15th STREET EAST BRADENTON, FLORIDA 33507

SHEET NUMBER 1

REVISION

T.L.K. FILE NO.