


M.H.W.L.  
EL. 1.45'  
MARCH 13, 1973

GULF OF MEXICO

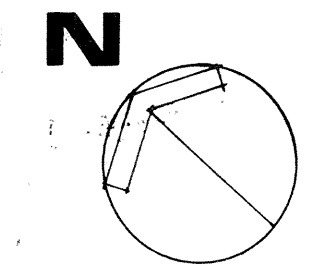

AS BUILT  
**WATER UTILITY PLAN**

1" = 50'

SHEET NUMBER <b>4-A</b>	REVISION	DESIGNED BY PROJECT ENGINEER	DATE: 9-18-74	BY	REVISION	DATE	L.T.R.	DATE	TOWN OF LONGBOAT KEY, FLORIDA
		CHECKED BY PROJECT NO. 63-AIB	D.A.H.						
		DRAWN BY M.M.C.	G.A.H.					ENGINEER JAMES R. KENNEDY TRIAD TECH., INC.	
		SCALE: 1" = 50'						LONGBEACH VILLAGE NORTH	
		DRAWN BY M.M.C.						GULF OF MEXICO DRIVE	
		CHECKED BY G.A.H.						LONGBOAT KEY, FLORIDA	
		DESIGNED BY D.A.H.						LOCATION	
		PROJECT NO. 63-AIB						611 - 15th STREET	
