


TYPE ASSESSMENT TO TOWN OF LONGBOAT KEY (SEE UTILITIES)

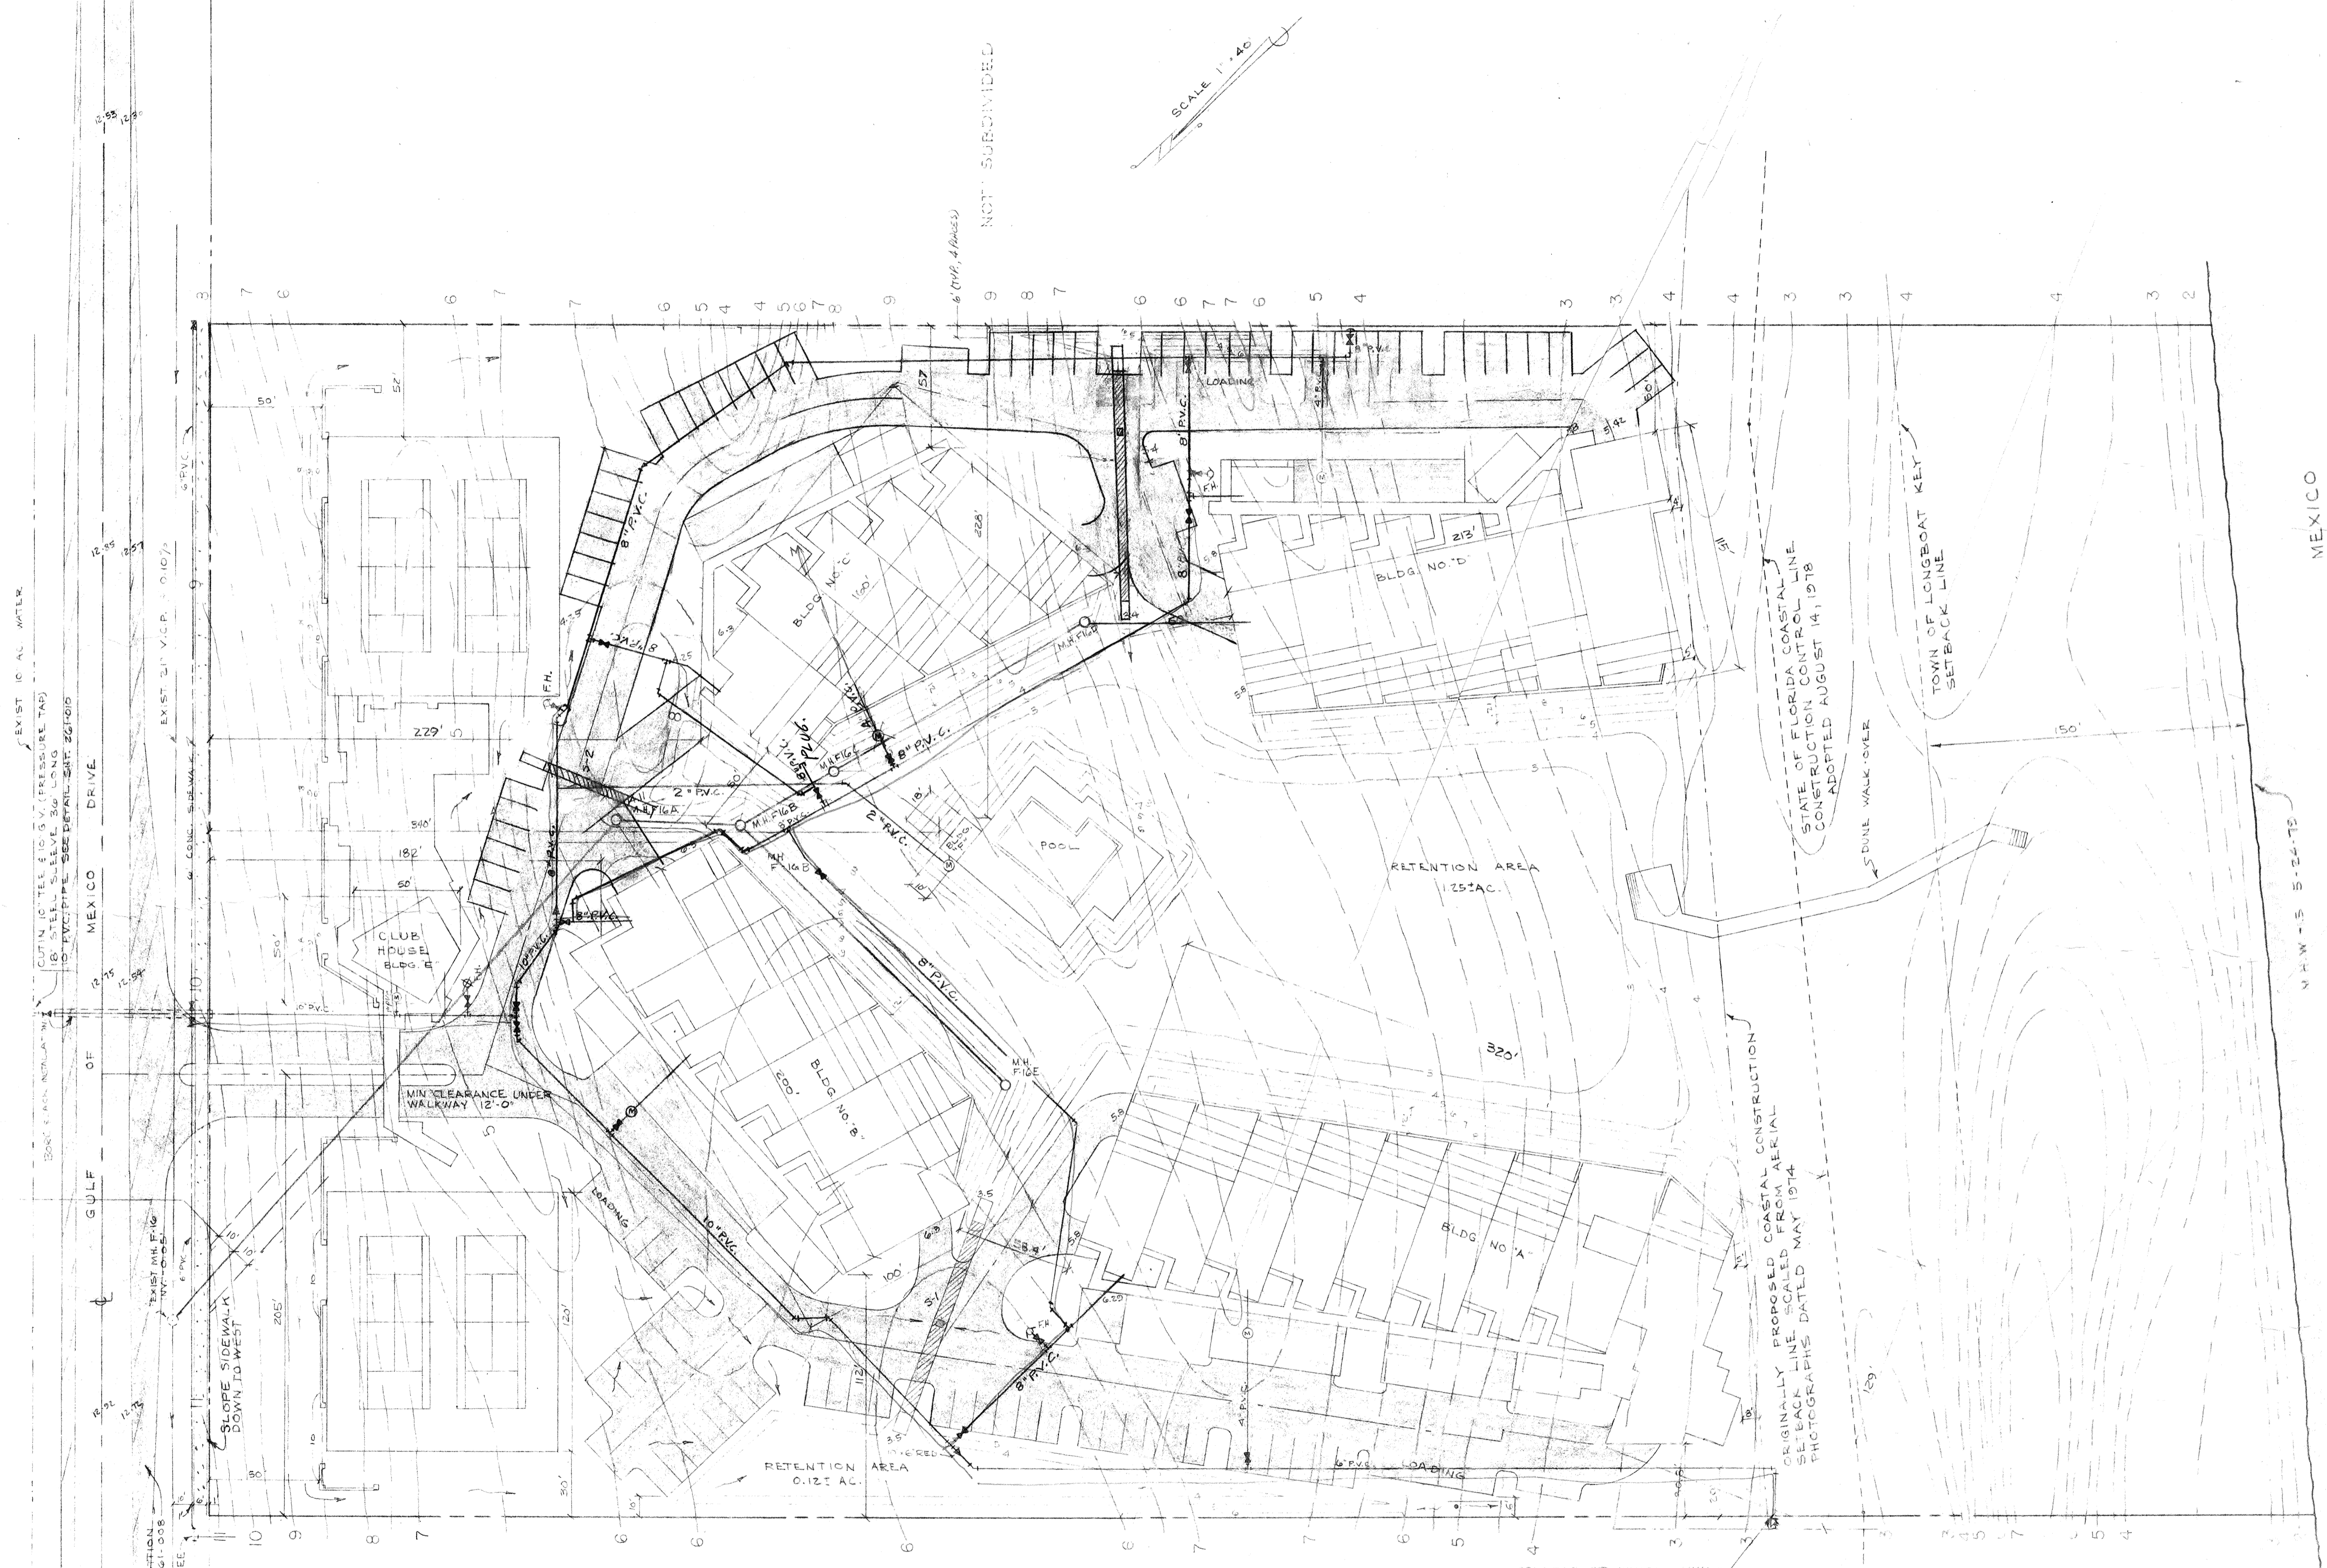

Plans approved on condition that construction or installation comply with all Local, State and National codes as adopted by and applicable to the Town of Longboat Key, FL, whether or not compliance is shown or noted on plans or specifications.

APPROVED BY
FIRE INSPECTOR
LONGBOAT KEY, FL.

Date: 7/25/61
Signed: [Signature]
Title: [Signature]

DATE: 7/25/61
SIGNED: [Signature]

C.D. 17, 18, 19, 20

MEXICO

N.W. 5 SECT. 5

OF



BENNETT & BISHOP

THE PLAYERS CLUB

DETAIL SITE PLAN

261-003