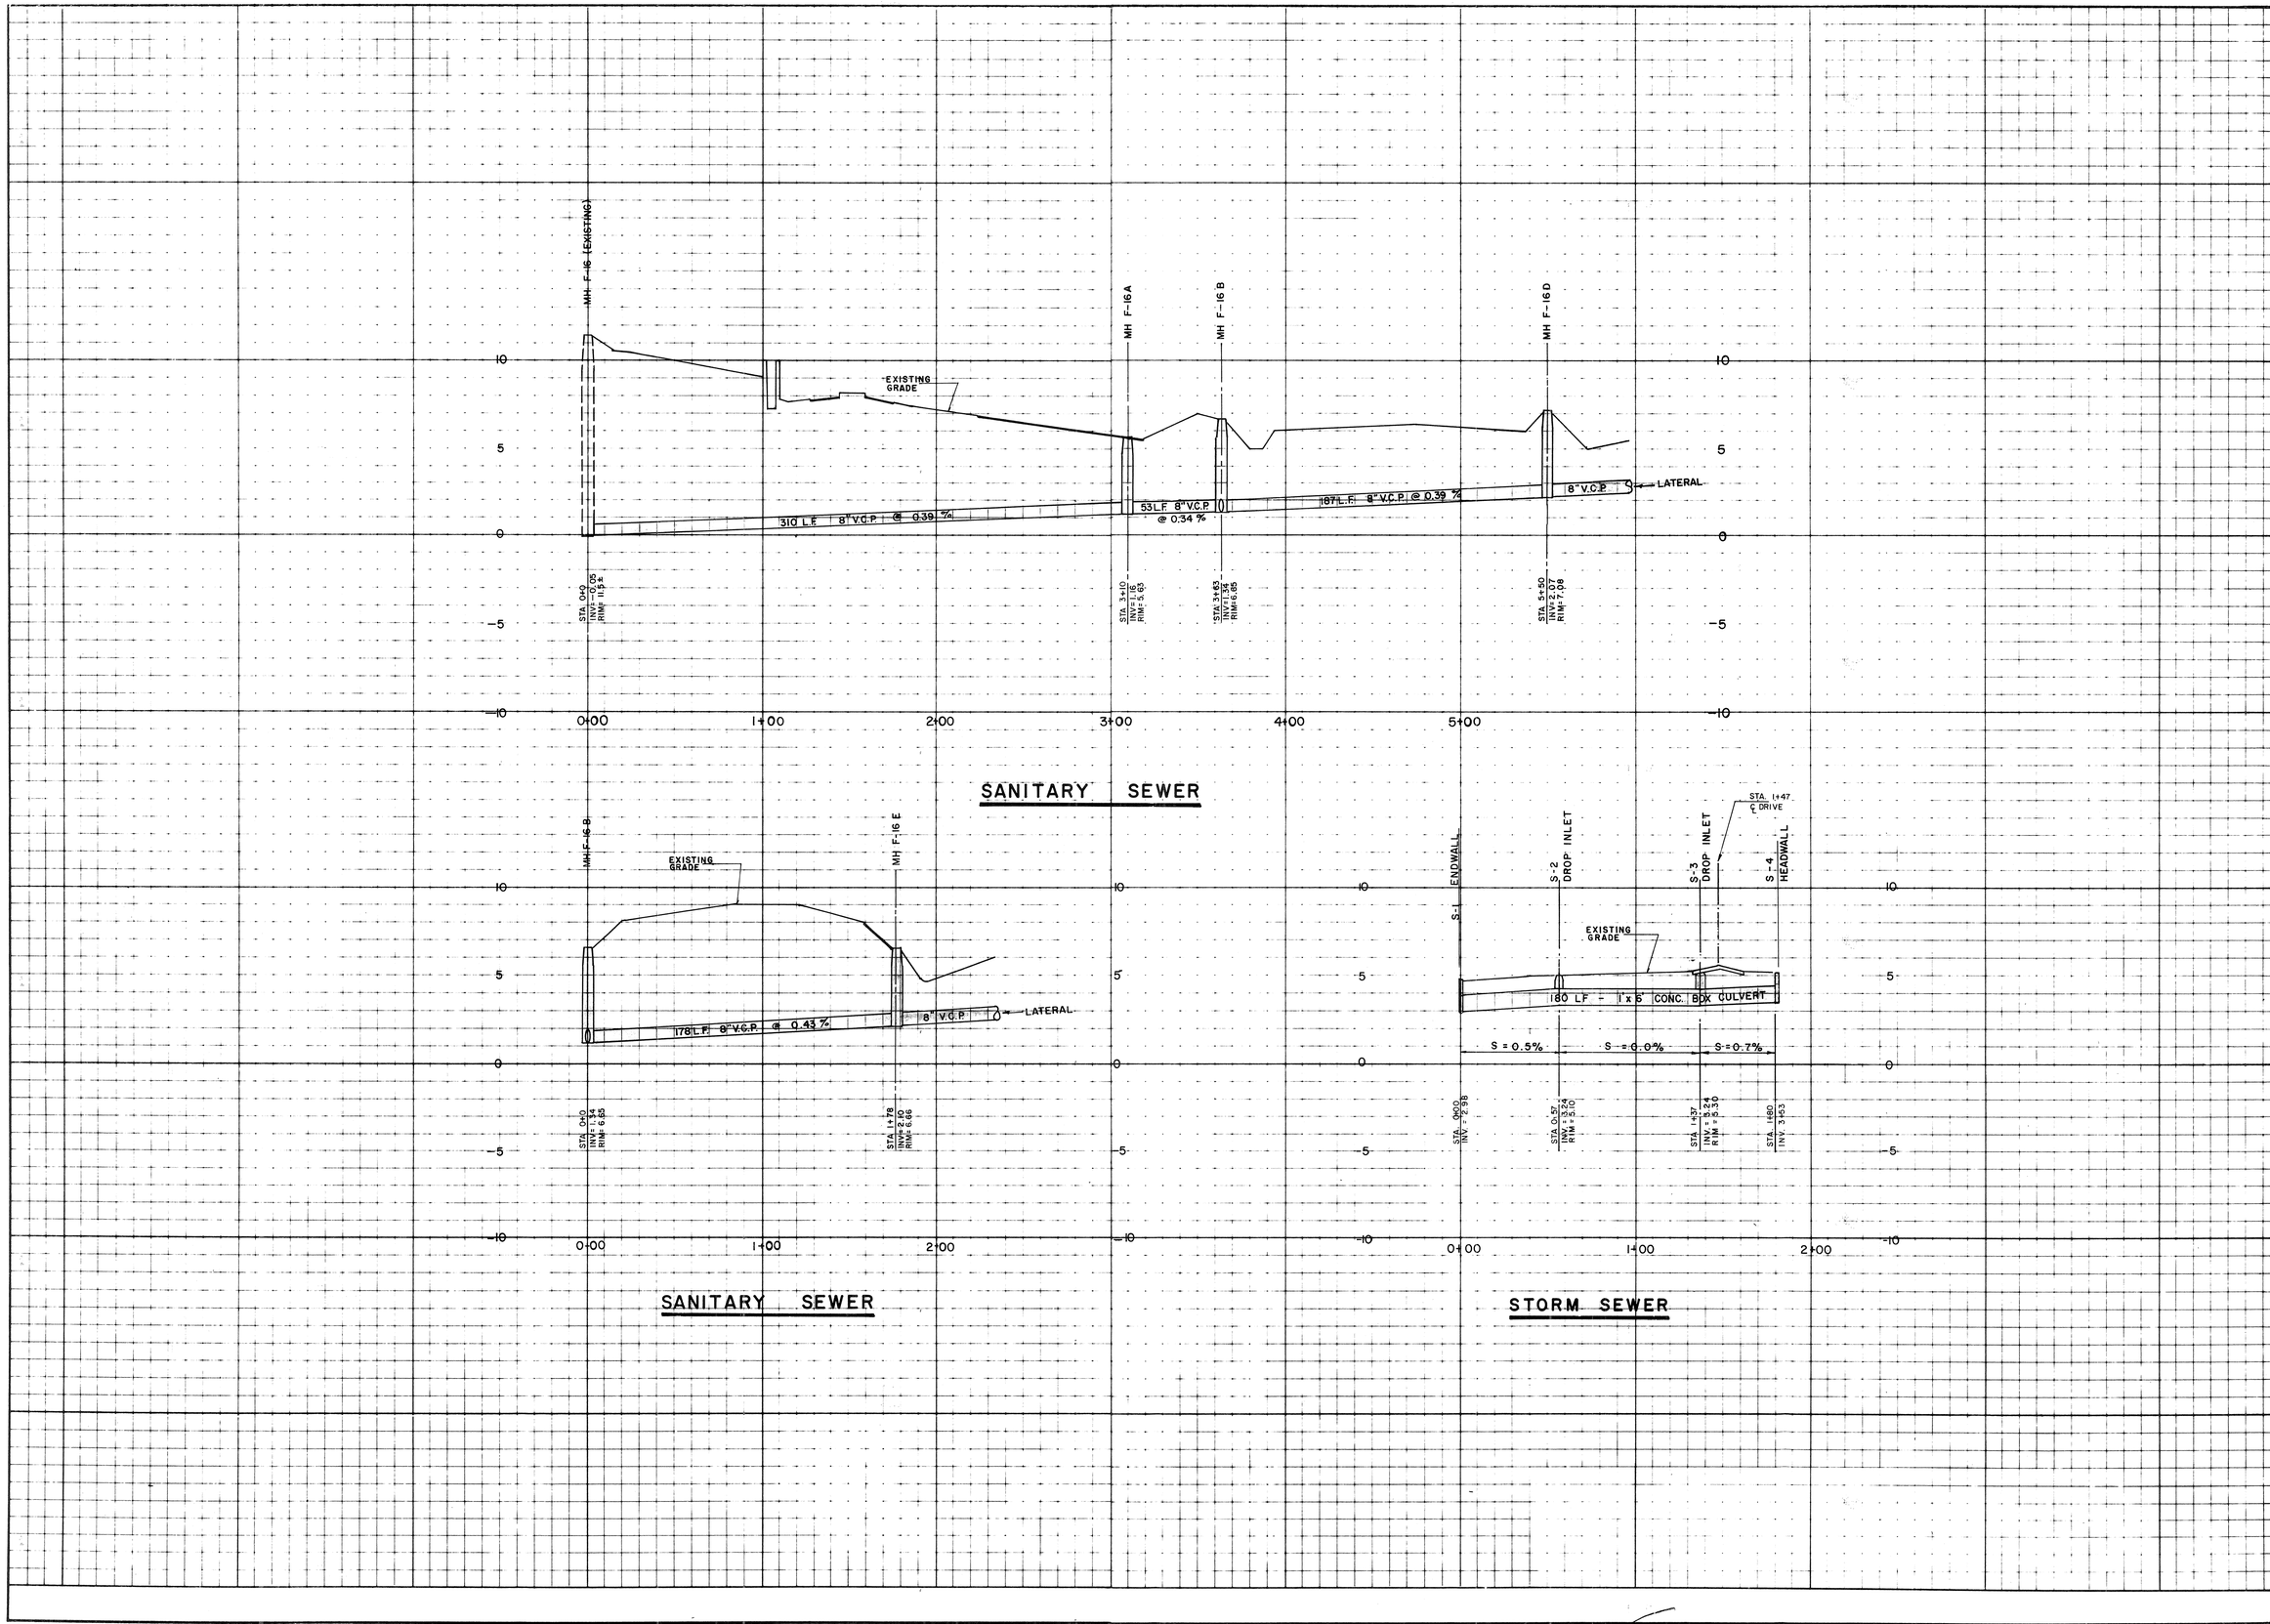

PROJECT ENGINEER

DESIGNED BY

DATE APRIL, 1983

CHECKED BY

PROJECT NO. 261

SCALE VERT 1"=4' HORIZ 1"=40'

DRAWN BY U DALLAS

LTR.	DATE	REVISION	BY

TOWN OF LONGBOAT KEY, FLORIDA

THE PLAYERS CLUB

AS BUILTS

SEWAGE COLLECTION AND STORM SEWER PROFILES

ENGINEER & LOCATION: BENNETT & BISHOP, INC. CONSULTING ENGINEERS & SURVEYORS 4509 BEE RIDGE RD., SARASOTA, FLORIDA

SHEET NUMBER 261-020 AB

REVISION

T.L.K. FILE NO.

PLAYERS CLUB