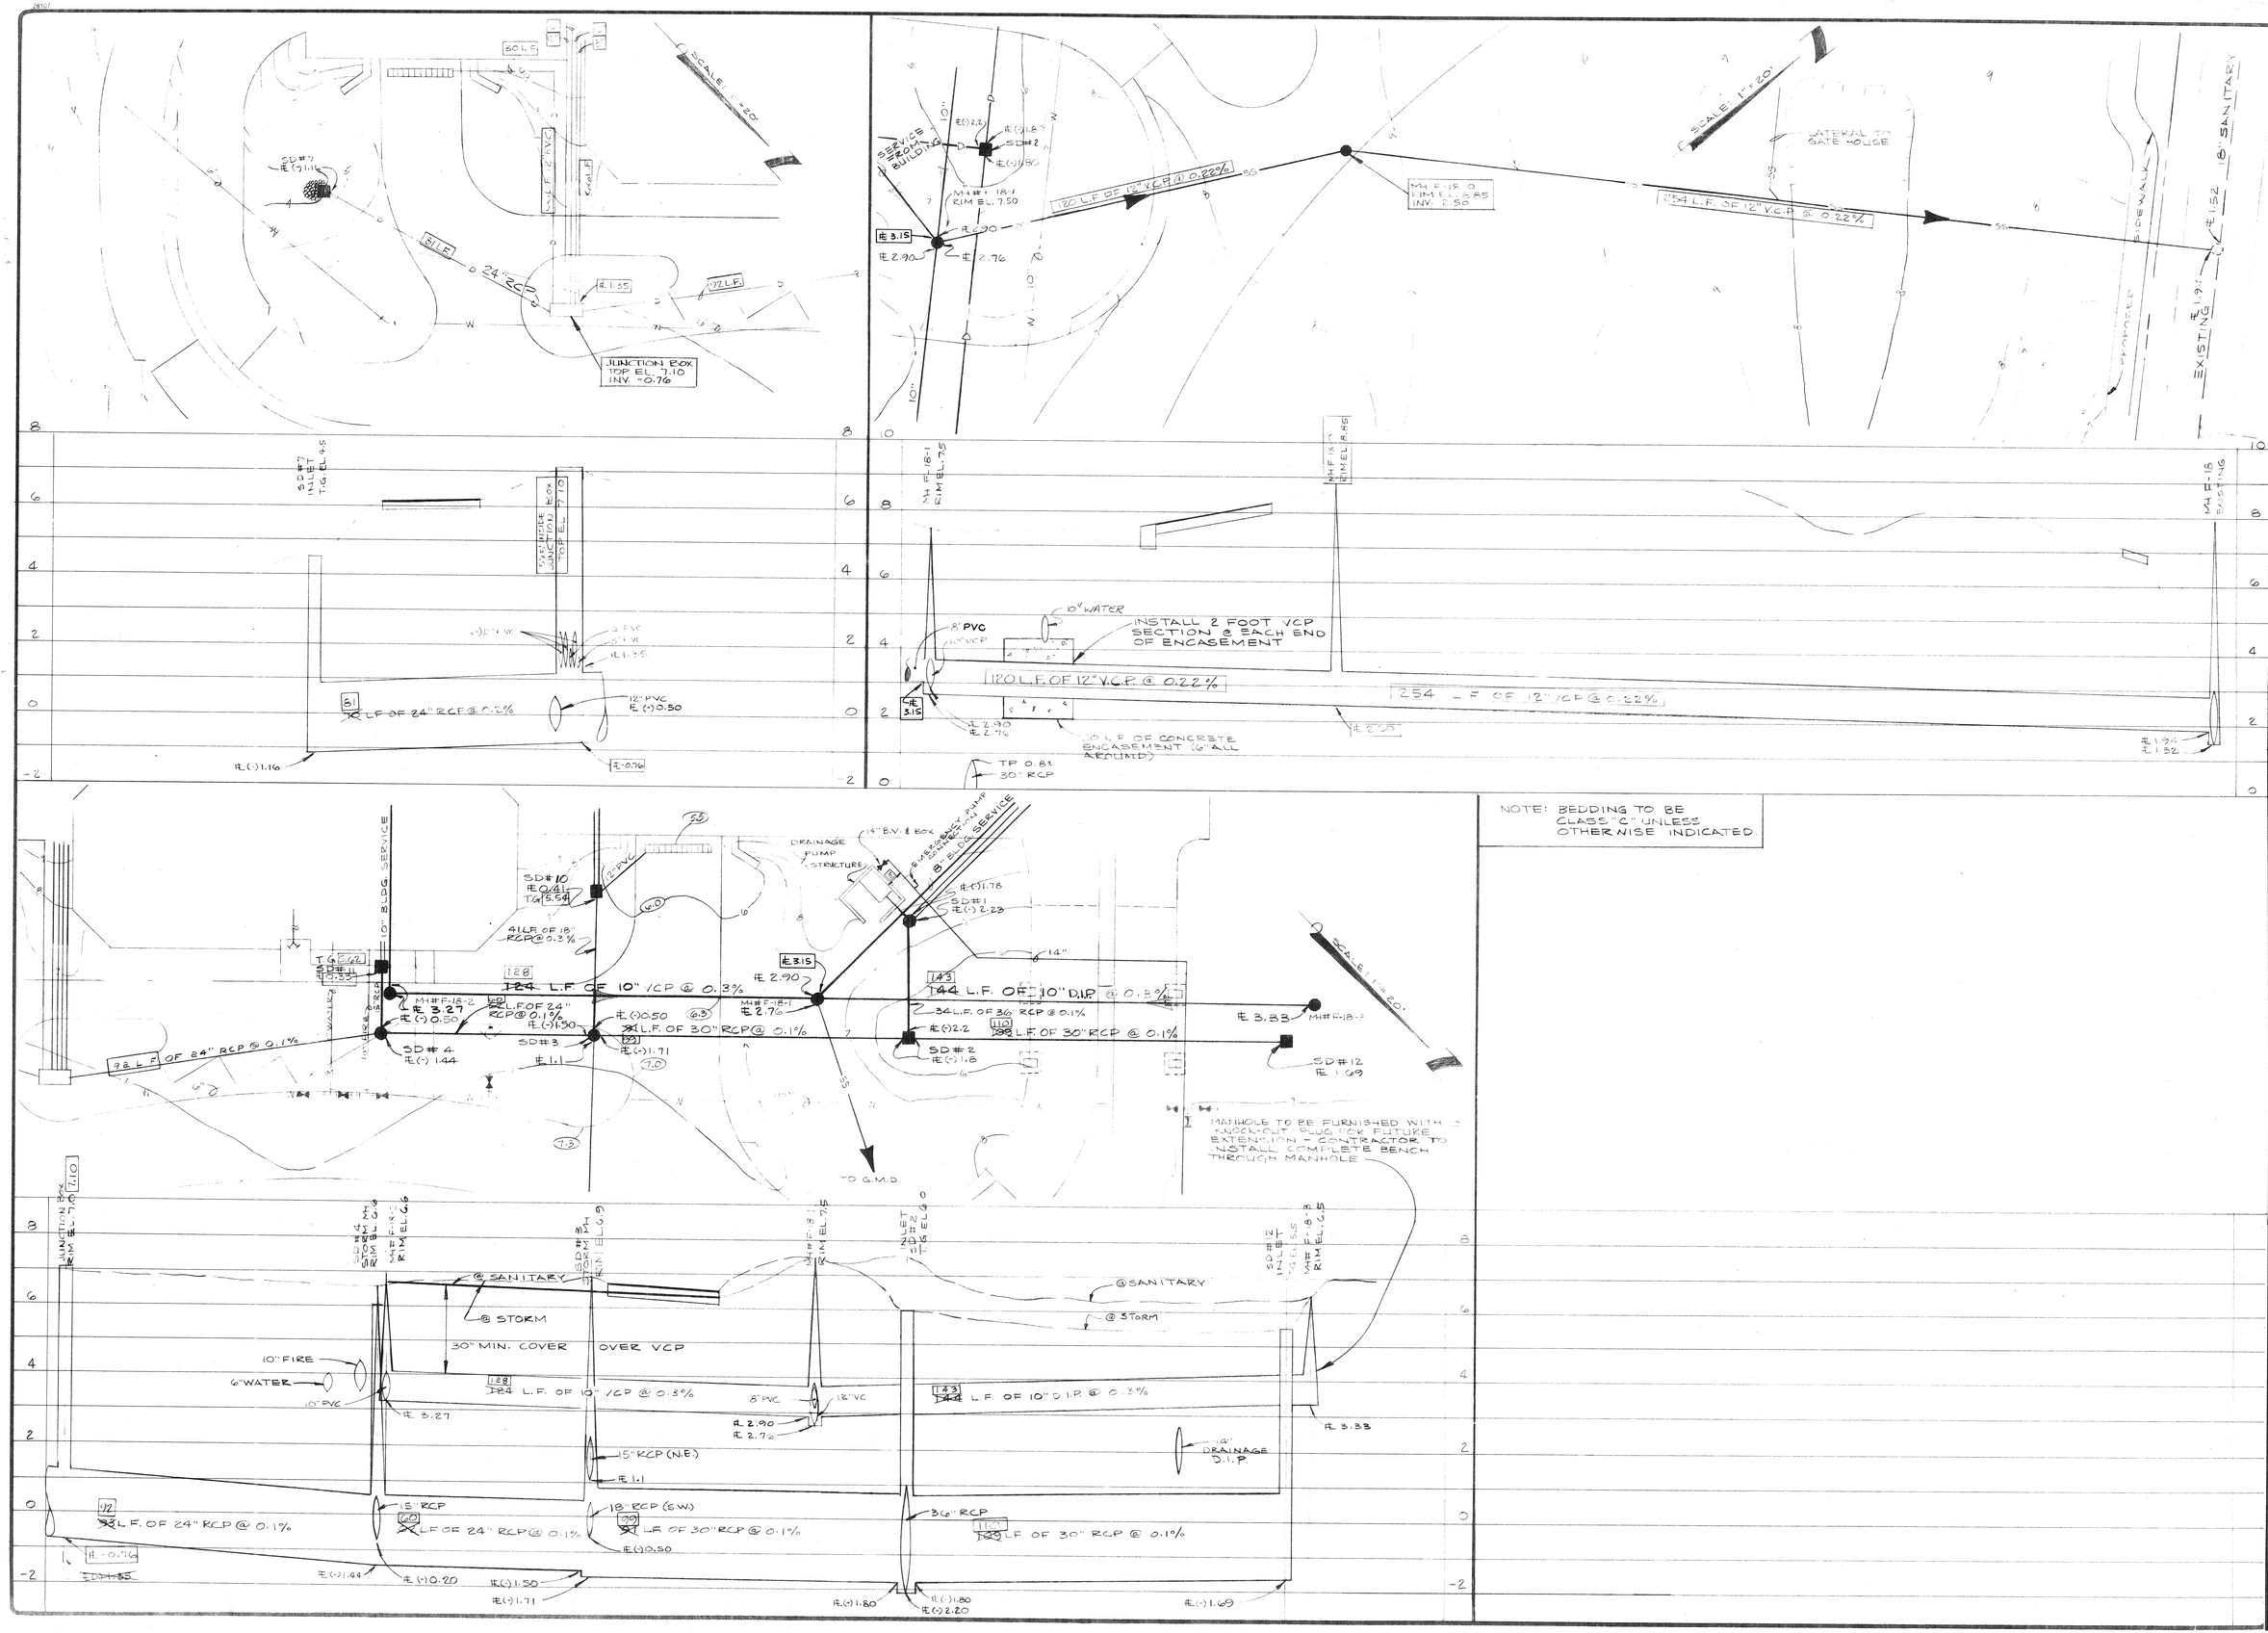

NOTE: BEDDING TO BE CLASS "C" UNLESS OTHERWISE INDICATED

PROJECT ENGINEER	LAWRENCE D. LIPPERT, P.E. FLA. CERT. NO. 23985
DESIGNED BY	LDL
PROJECT NO.	380
DATE:	11-1-85
CHECKED BY	LDL
SCALE: HOR. 1" = 20' VER. 1" = 2'	
DRAWN BY	ALP

BY	REVISION	DATE	LTR.

TOWN OF LONGBOAT KEY, FLORIDA

PARKSHORE DEVELOPMENT CO., INC.

PROMENADE I - AS BUILT

WATER DISTRIBUTION - SEWER COLLECTION - DRAINAGE

ENGINEER & LOCATION: HOUGHTON, GOLLNICK & LIPPERT, INC. — CONSULTING ENGINEERS — 3905 SOUTH SHADE AVENUE, SARASOTA, FL 33581

SHEET NUMBER: CP 380-3

REVISION

T.L.K. FILE NO.

Copyright - 1982 Schwab & Twitty Architects, Inc. All Rights Reserved