AF 22998

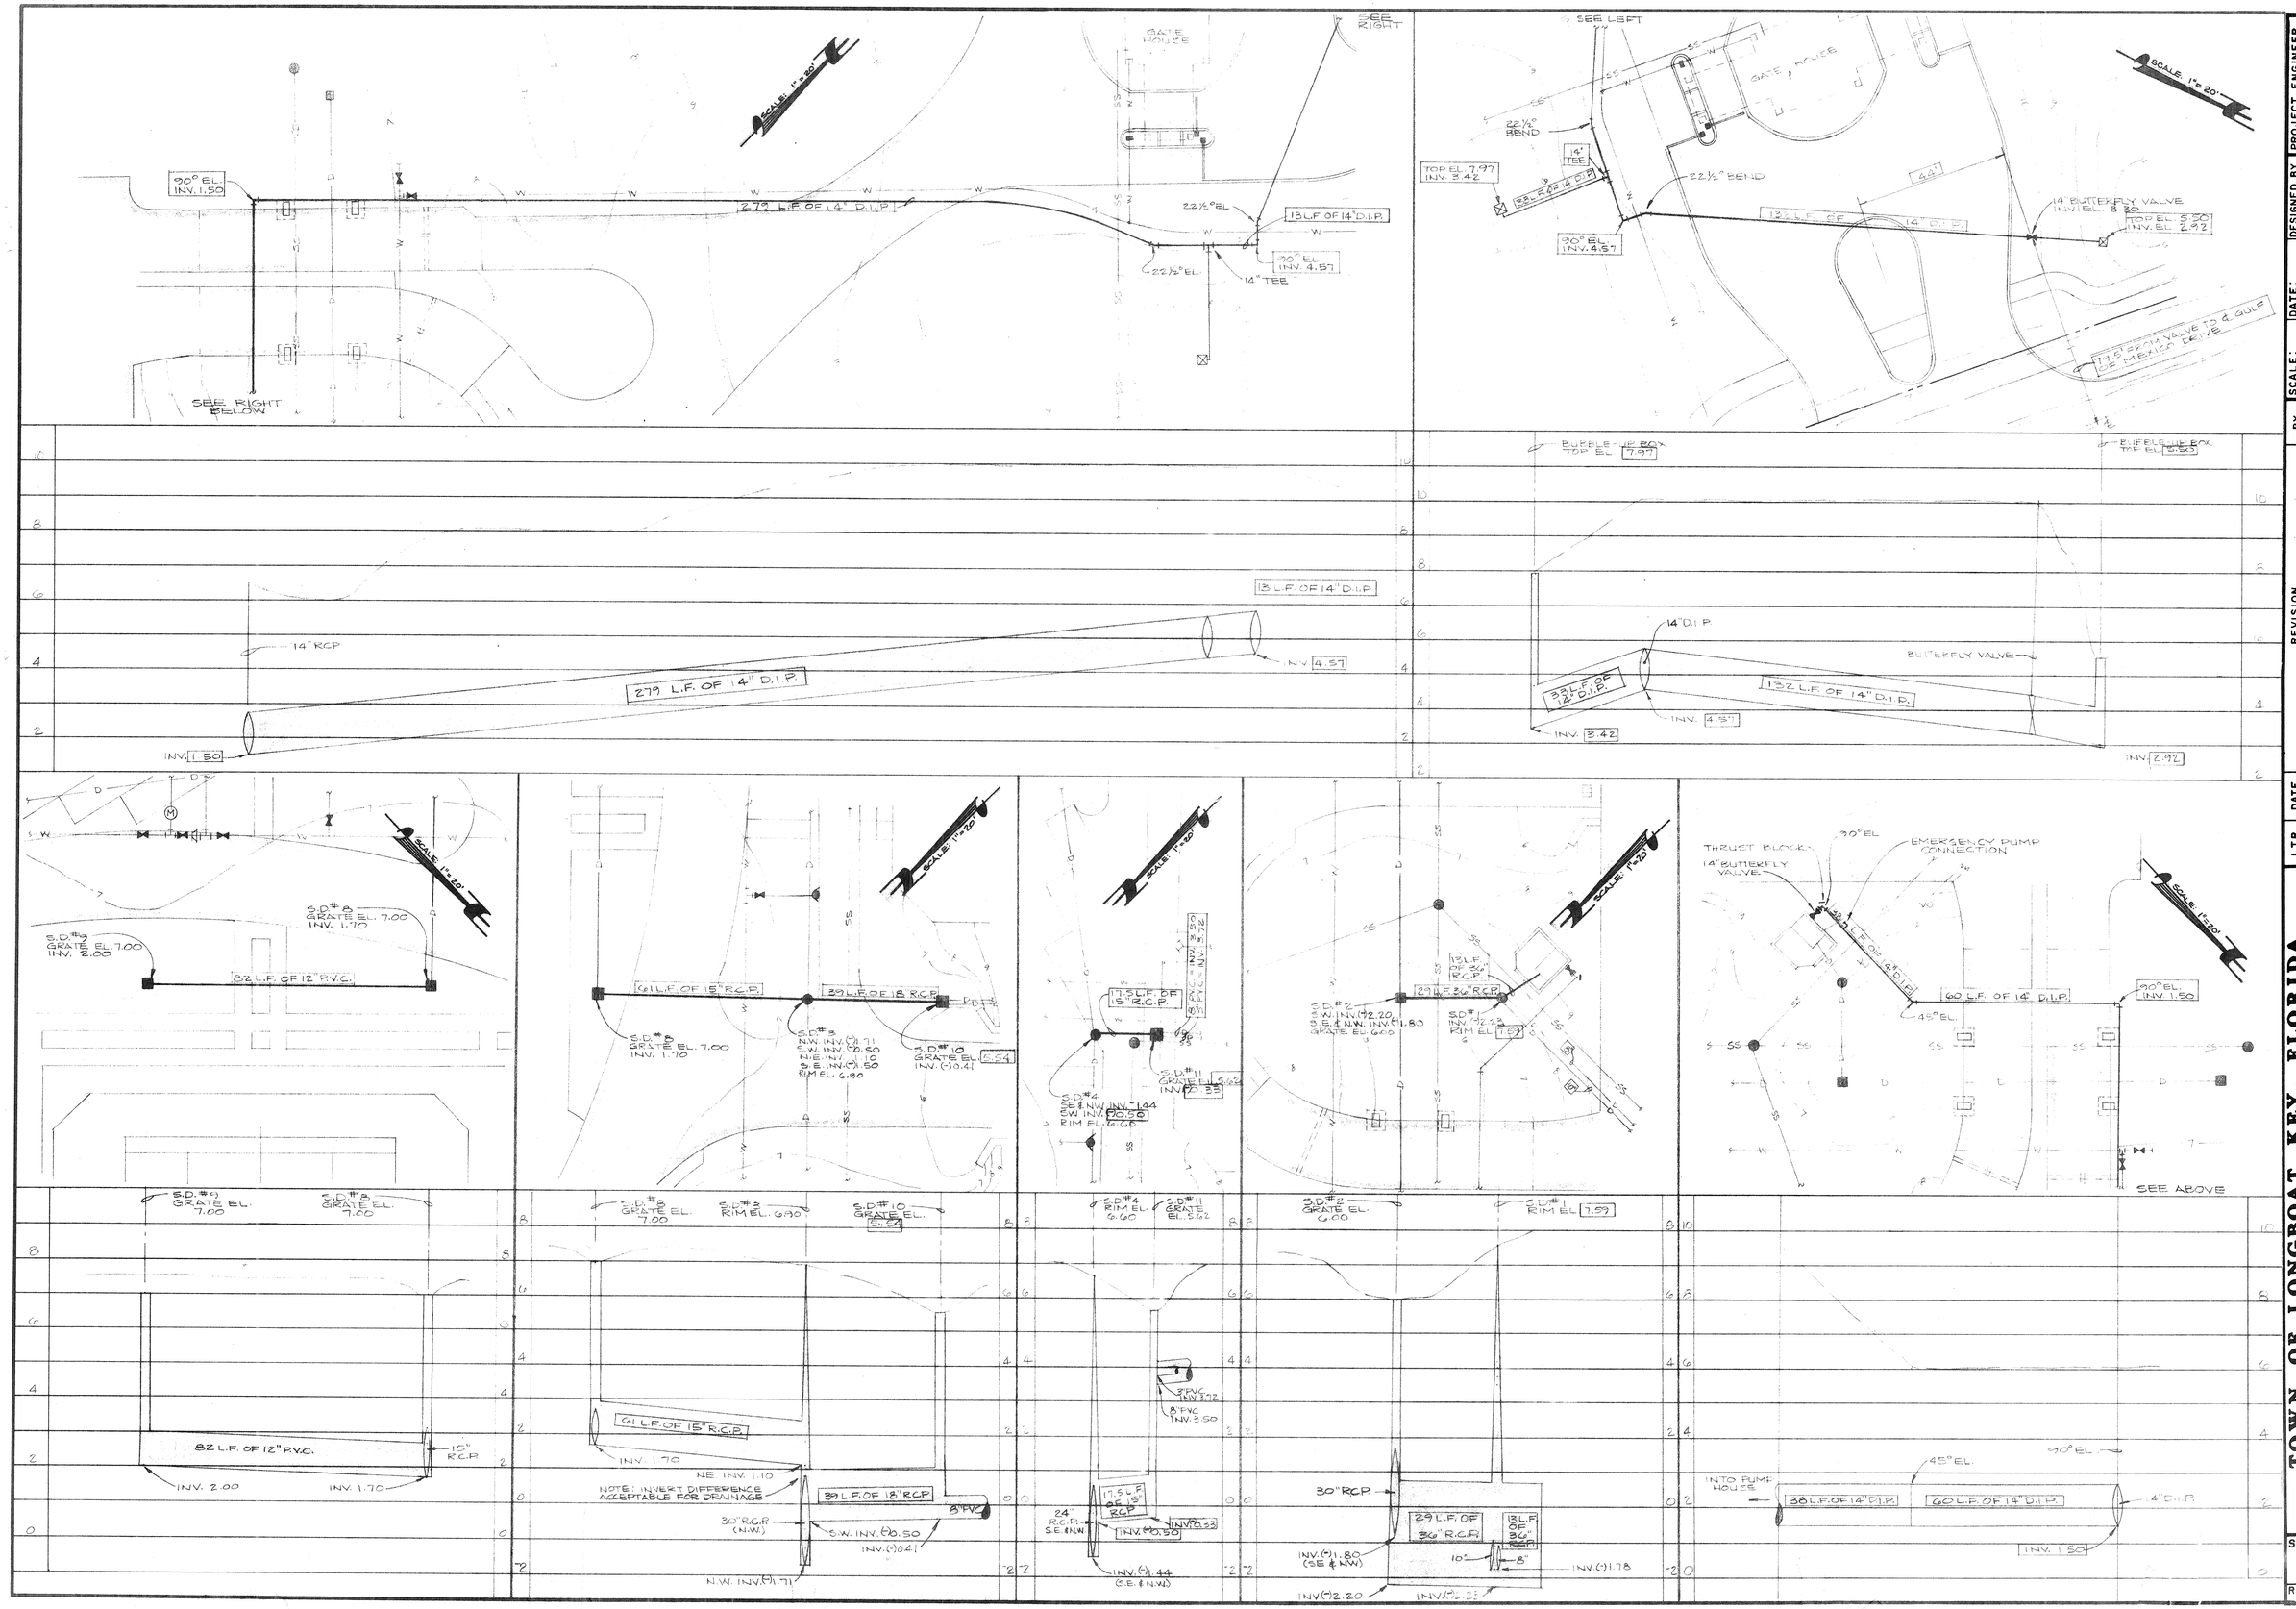

PROJECT ENGINEER	DESIGNED BY	DATE:	SCALE: HOR. 1" 20' VER. 1" 2'	BY
LAWRENCE D. LIPPERT, P.E. FLA. CERT. NO. 20805	LDL	11-1-85	DRAWN BY ALP	REVISION
	PROJECT NO. 380	CHECKED BY LDL		

LTR.	DATE	REVISION

TOWN OF LONGBOAT KEY, FLORIDA

PARKSHORE DEVELOPMENT CO., INC.

PROMENADE I – AS BUILT

WATER DISTRIBUTION – SEWER COLLECTION – DRAINAGE

ENGINEER & ARCHITECT: HOUGHTON, GOLLNICK & LIPPERT, INC. – CONSULTING ENGINEERS – 3905 SOUTH SHADE AVENUE, SARASOTA, FL 33581

SHEET NUMBER CP 380-3A

REVISION

T.L.K. FILE NO.