AF 22998

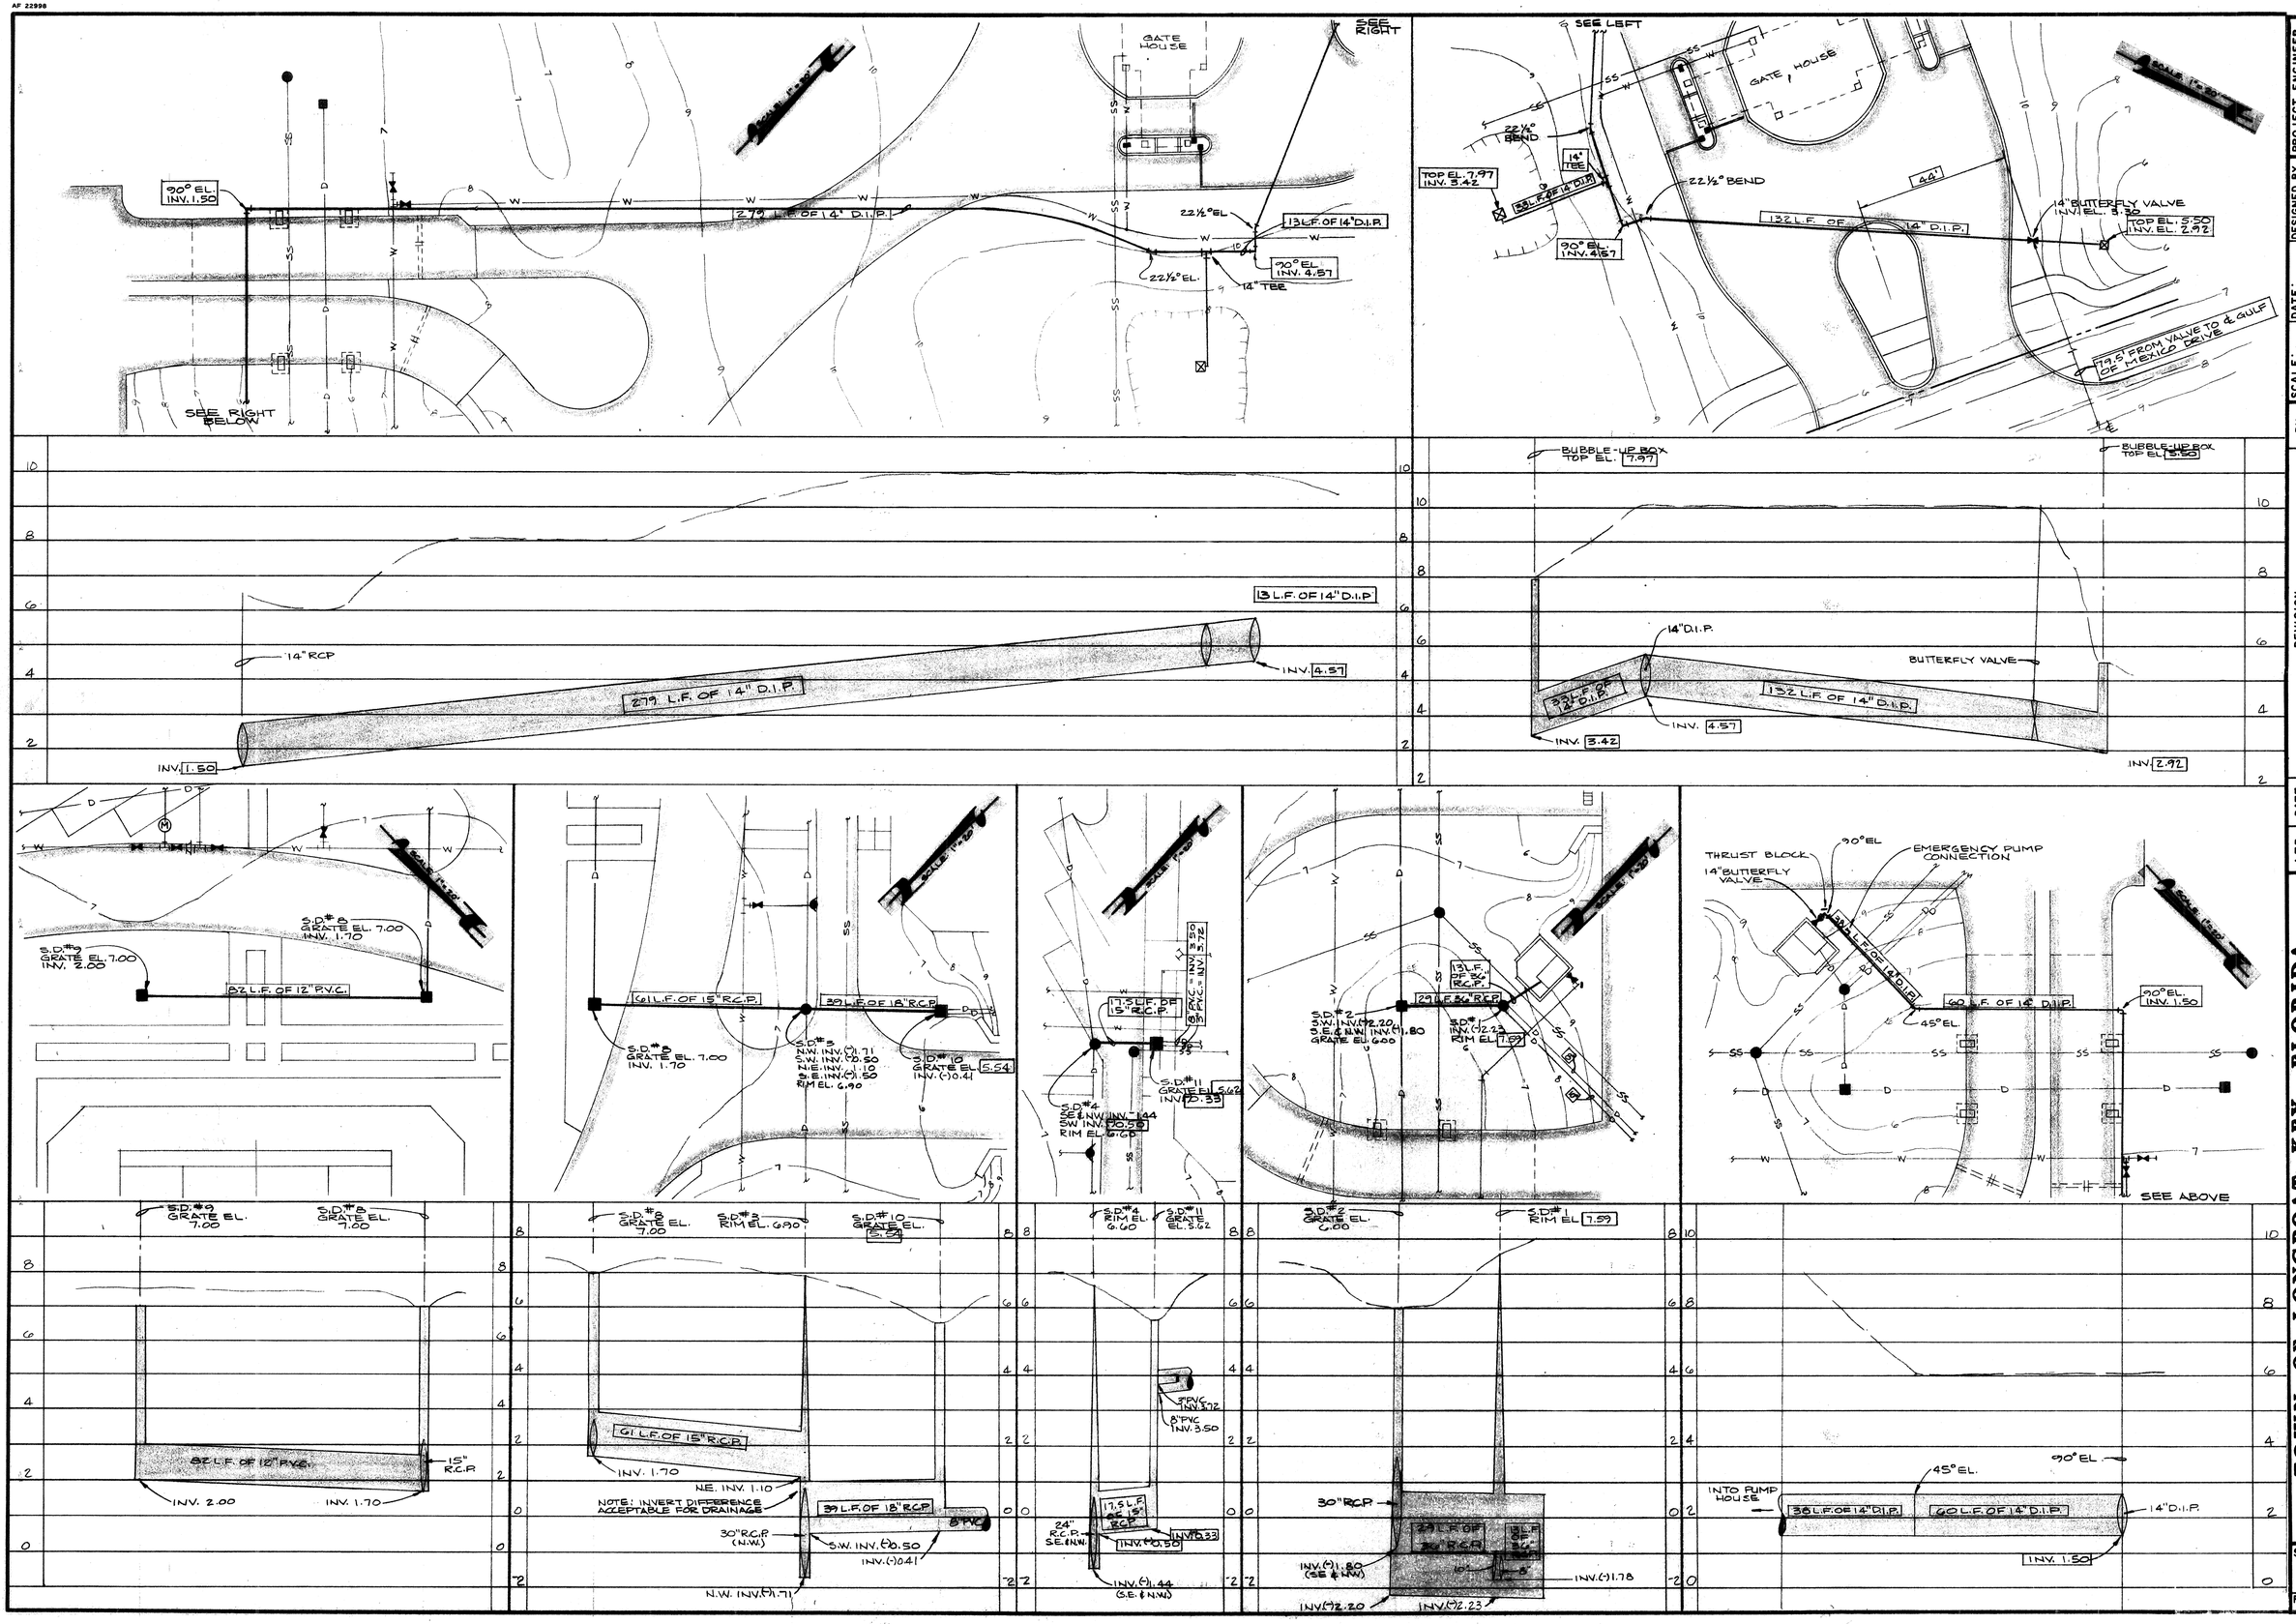

PROJECT ENGINEER

LAWRENCE D. LIPPERT, P.E.
FLA. CERT. NO. 23983

DESIGNED BY LDL | PROJECT NO. 380

DATE: 11-1-85 | CHECKED BY LDL

SCALE: HOR. 1" = 20' VER. 1" = 2' | DRAWN BY ALP

LTR.	DATE	REVISION	BY

TOWN OF LONGBOAT KEY, FLORIDA

PARKSHORE DEVELOPMENT CO., INC.
PROMENADE I - AS BUILT
WATER DISTRIBUTION - SEWER COLLECTION - DRAINAGE

ENGINEER & LOCATION: HOUGHTON, GOLLNICK & LIPPERT, INC. — CONSULTING ENGINEERS — 3905 SOUTH SHADE AVENUE, SARASOTA, FL 33581

SHEET NUMBER CP 380-3A

REVISION

T.L.K. FILE NO.