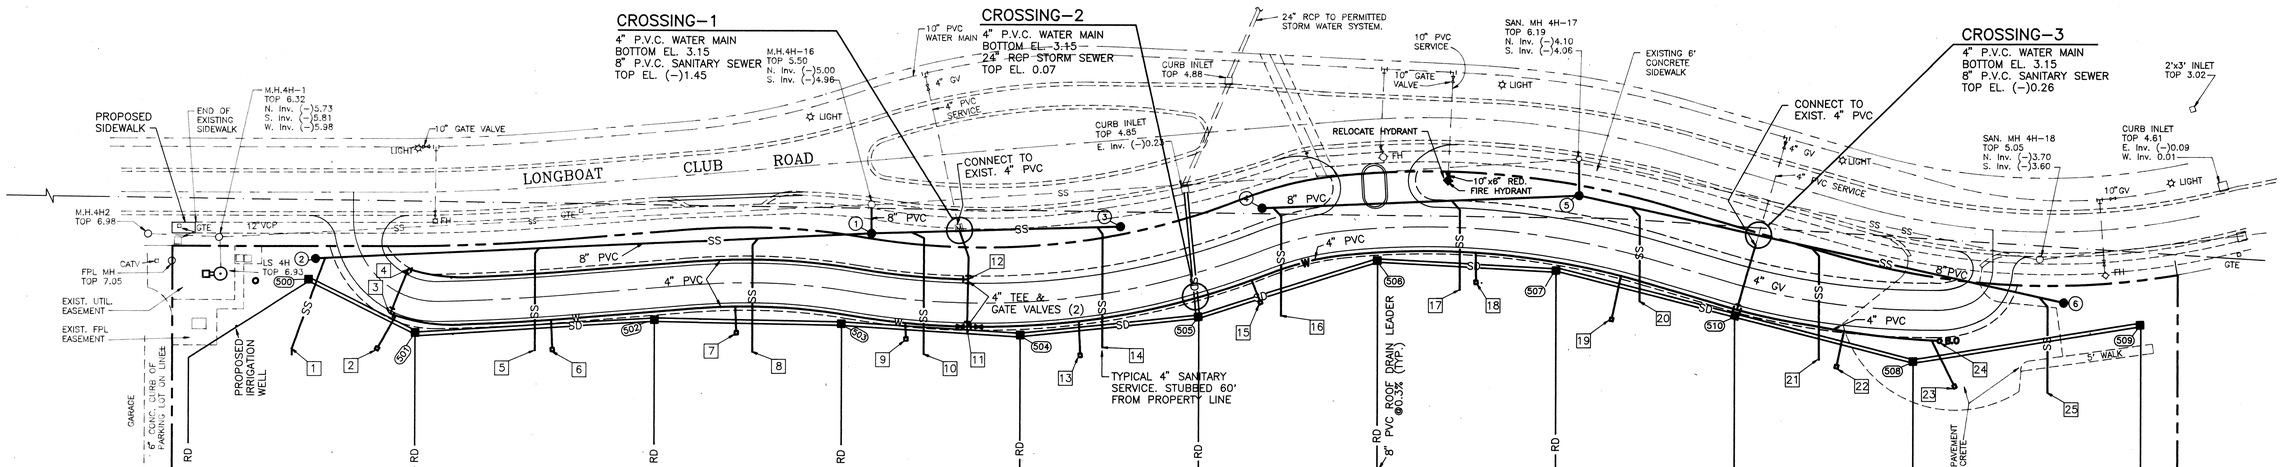

STRUCTURE	MONUMENTS				DESCRIPTION
1	500		501	41.3' / 69.8'	SANITARY SEWER SERVICE
2	500		501	53.8' / 21.5'	WATER SERVICE
3	500		501	49.3' / 17.9'	4"- 90°
4	500		501	56.0' / 35.2'	4"- 90°
5	501		502	68.0' / 70.2'	SANITARY SEWER SERVICE

STRUCTURE	MONUMENTS				DESCRIPTION
6	501		502	77.4' / 59.2'	WATER SERVICE
7	502		503	46.1' / 59.4'	WATER SERVICE
8	502		503	56.5' / 52.7'	SANITARY SEWER SERVICE
9	503		504	37.2' / 64.2'	WATER SERVICE
10	503		504	51.6' / 50.2'	SANITARY SEWER SERVICE

STRUCTURE	MONUMENTS				DESCRIPTION
11	503		504	58.8' / 41.2'	4"-90°
12	503		504	75.1' / 42.4'	4"-90°
13	504		505	47.0' / 56.0'	WATER SERVICE
14	504		505	60.7' / 42.5'	SANITARY SEWER SERVICE
15	505		506	35.8' / 69.2'	WATER SERVICE

STRUCTURE	MONUMENTS				DESCRIPTION
16	505		506	47.0' / 58.5'	SANITARY SEWER SERVICE
17	506		507	49.6' / 54.5'	SANITARY SEWER SERVICE
18	506		507	56.5' / 45.2'	WATER SERVICE
19	507		508	41.9' / 69.4'	WATER SERVICE
20	507		508	50.1' / 53.2'	SANITARY SEWER SERVICE

STRUCTURE	MONUMENTS				DESCRIPTION
21	510		508	54.8' / 51.1'	SANITARY SEWER SERVICE
22	510		508	63.4' / 42.8'	WATER SERVICE
23	508		MH#6	27.6' / 76.4'	WATER SERVICE
24	508		MH#6	16.5' / 75.9'	BLOW OFF
25	508		MH#6	74.5' / 28.6'	SANITARY SEWER SERVICE

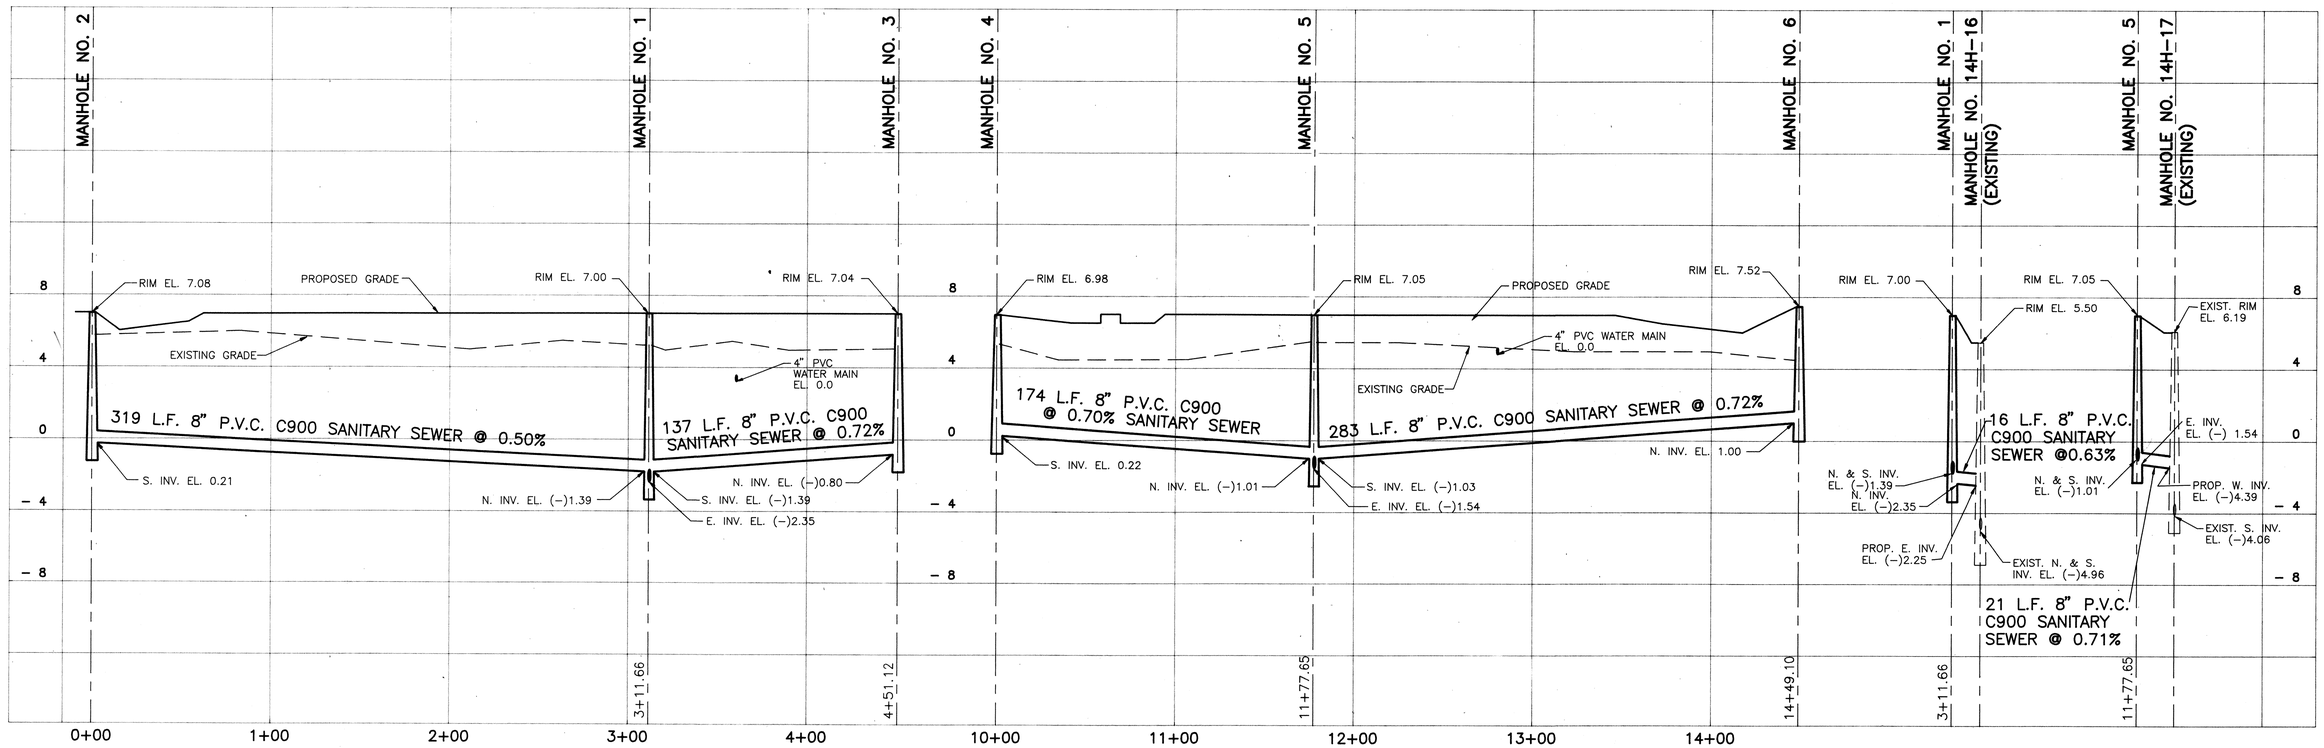

OWNER	PROJECT NAME
REGENT COURT REGENT COURT GROUP/BOWYER DEVELOPMENT CORP. LONGBOAT KEY, FLORIDA SARASOTA COUNTY	REGENT COURT LONGBOAT KEY, FLORIDA PLAN & PROFILE

NORTH	SHEET
	5

REVISIONS

NO.	DATE	DESCRIPTION	BY
3	03/26/93	REV RECORD DRAWING INFORMATION	DBH
2	03/21/93	ADDED RECORD DRAWING INFORMATION	DBH
1	11/11/92	RELOCATE FIRE HYDRANT	DBH

MINDER & RHODES ENGINEERING CORPORATION
Engineers – Planners – Surveyors
3900 CLARK ROAD
SARASOTA, FL. 34233
(813) 922-7846

Designed WBH	Checked	Approved
Drawn DBH	Scale 1"=40' HORZ. 1"=4' VERT.	Date 07/23/92

APPROVED
P.E. No. 33160
Date 3/26/93
Prj. No. S1098
CAD DWG. S1098P1

REGENT COURT

03/26/93