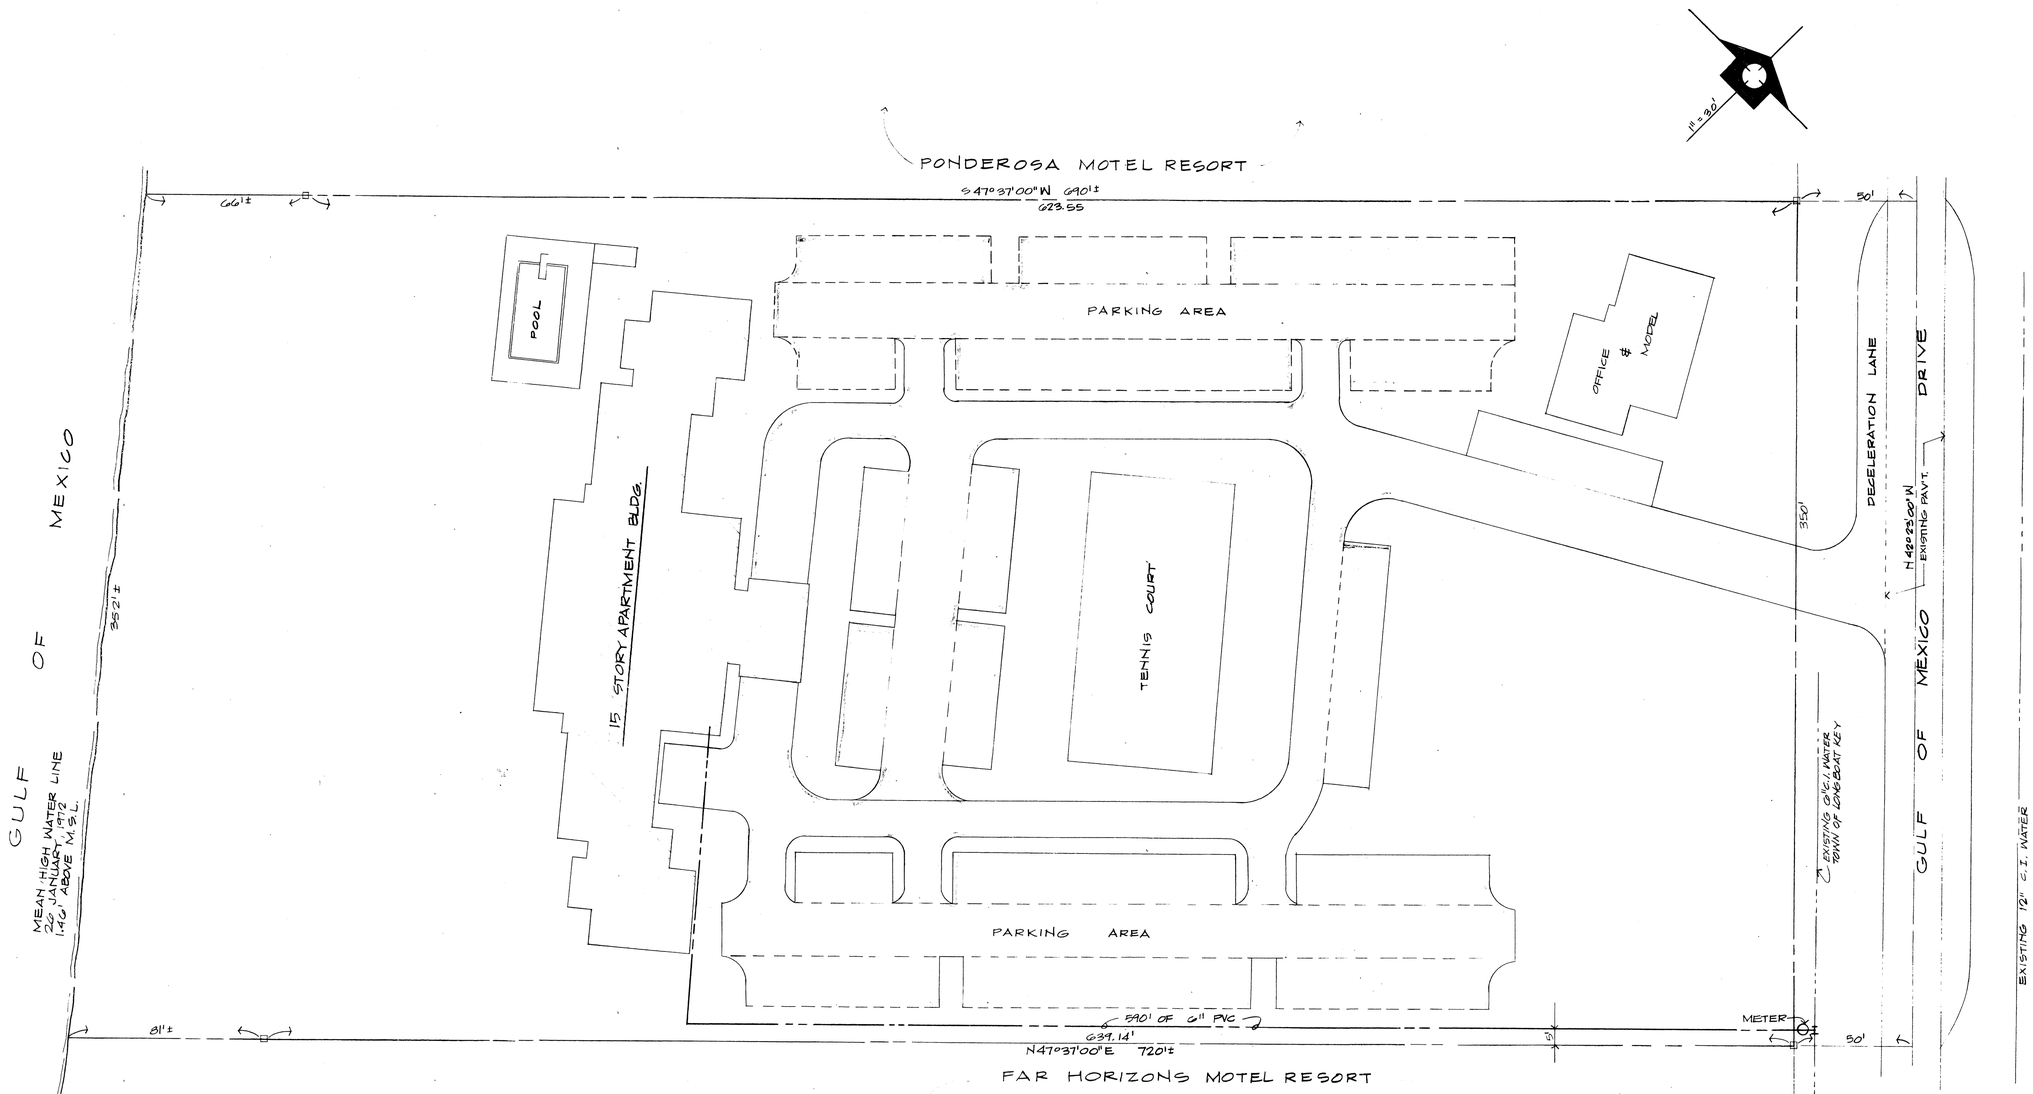

SITE PLAN

SHOWING "AS BUILT" WATER DISTRIBUTION SYSTEM

LTR.	DATE	REVISION	BY

SCALE: | DATE: | DESIGNED BY | PROJECT ENGINEER

DRAWN BY | CHECKED BY | PROJECT NO.

TOWN OF LONGBOAT KEY, FLORIDA

SEAGATE CLUB

GULF OF MEXICO DRIVE

SARASOTA, FLORIDA

ENGINEER & LOCATION

SHEET NUMBER 57-A

REVISION

T.L.K. FILE NO. G-1217-108

SEA GATE