


SEE SH'T. D-207

SEE SH'T. D-207

Foy Drainage Details
See Sheet D-207


For Drainage Details
See Sheet D-208

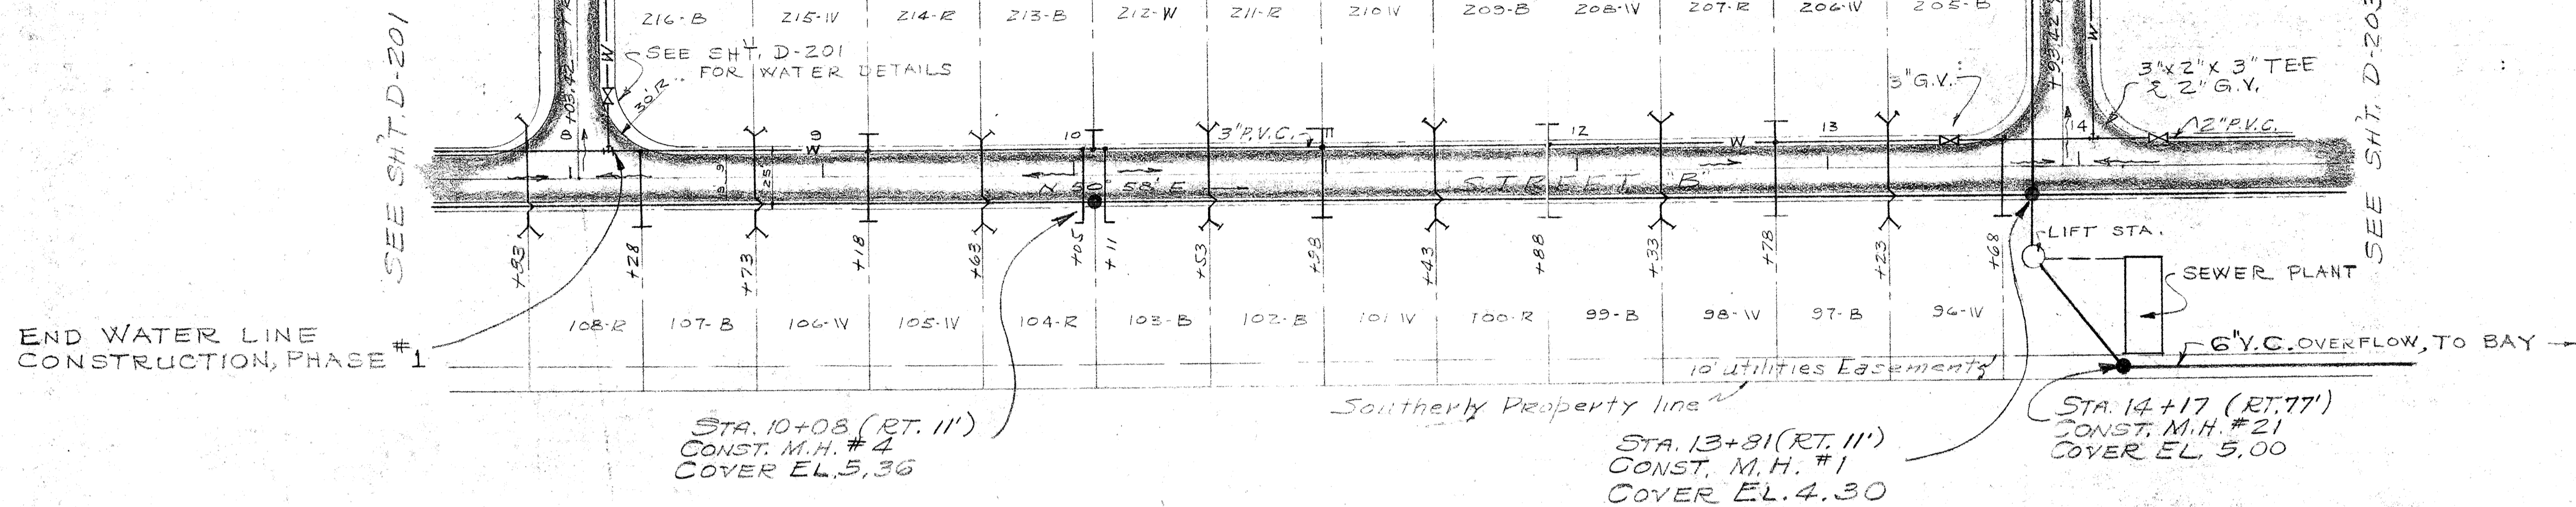

STA. 10+08 (RT. 11')
CONST. M.H. #4
COVER EL. 5.36

STA. 13+81 (RT. 11')
CONST. M.H. #1
COVER EL. 4.30

CONST. M.H. #21
COVER EL. 5.00

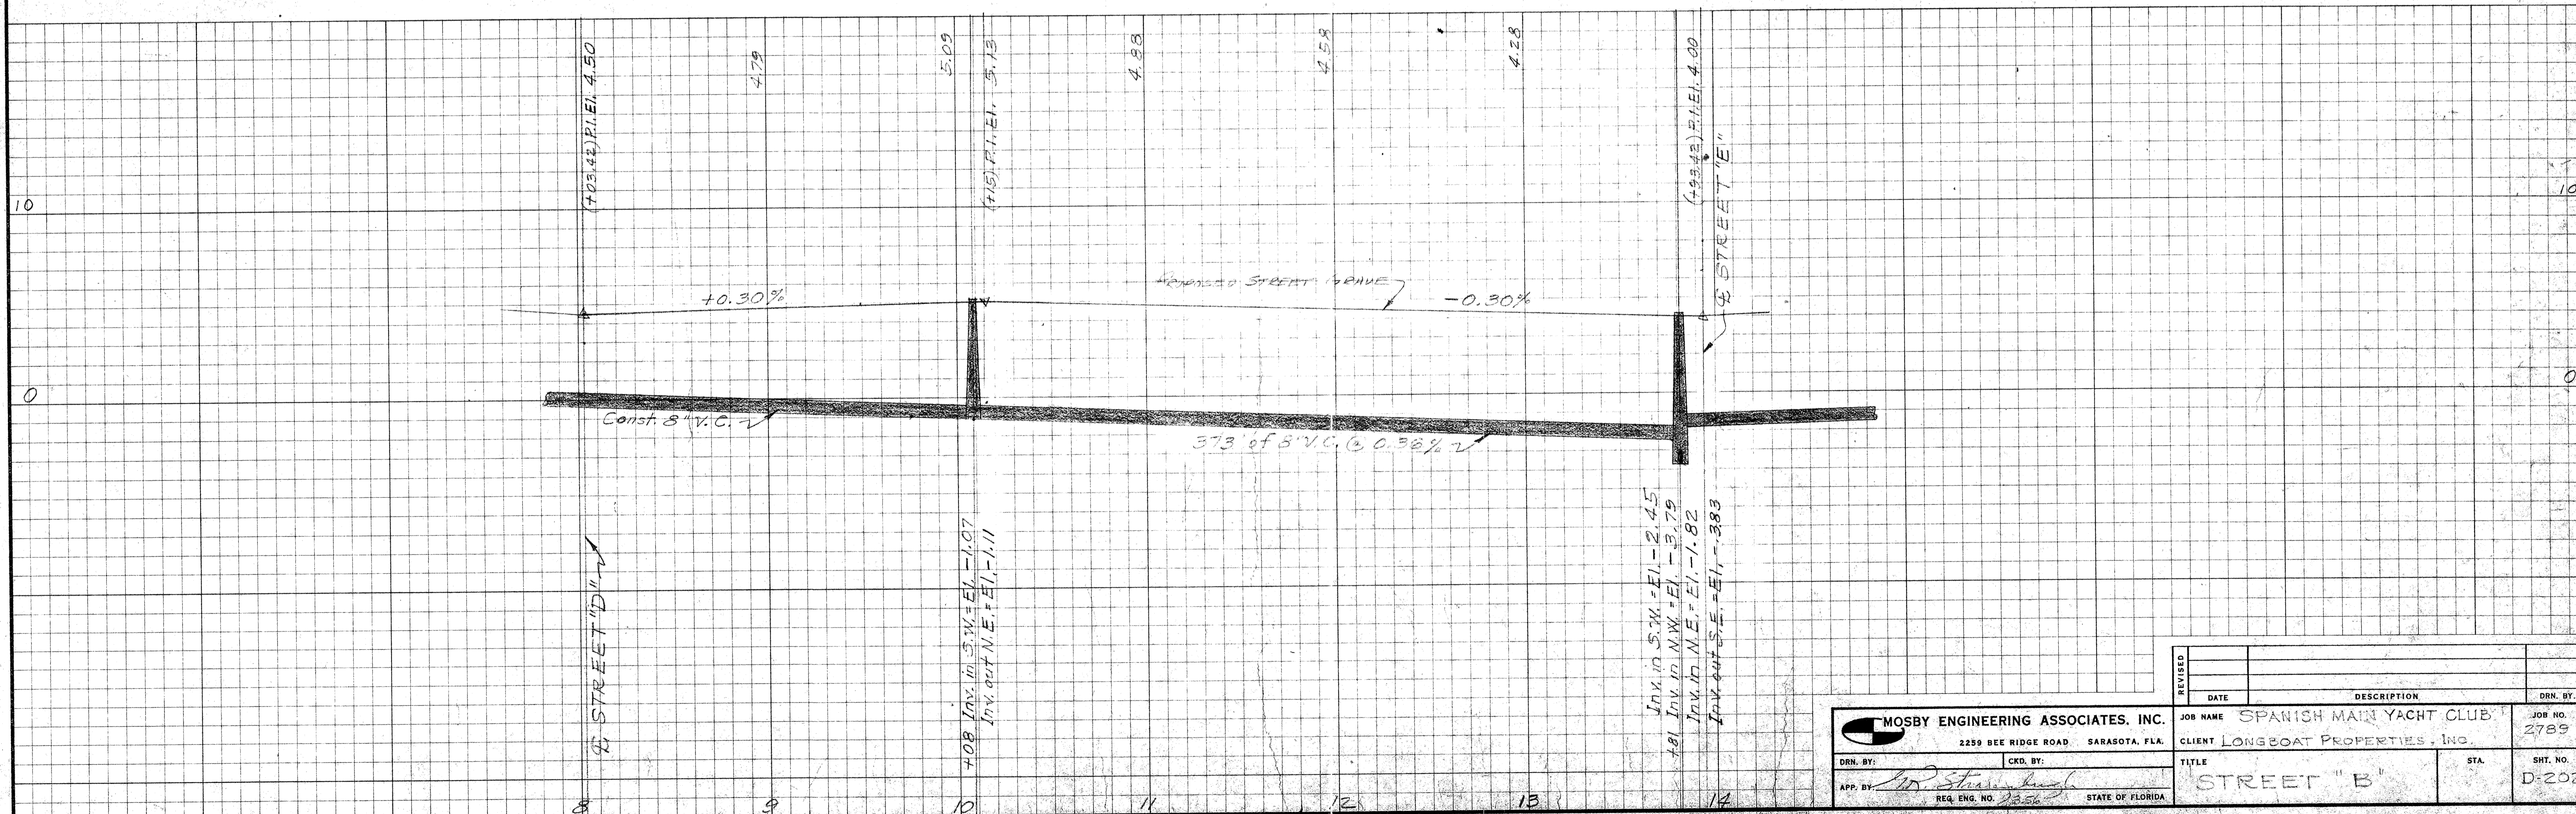

MOSBY ENGINEERING ASSOCIATES, INC. 2259 BEE RIDGE ROAD SARASOTA, FLA. DRN. BY: <i>[Signature]</i> CKD. BY: <i>[Signature]</i> APP. BY: <i>[Signature]</i> REG. ENG. NO. 2356 STATE OF FLORIDA		JOB NAME SPANISH MAIN YACHT CLUB CLIENT LONGBOAT PROPERTIES, INC. TITLE STREET "B" STA. D-202	JOB NO. 2789 SHT. NO. D-202
---	--	---	--------------------------------