

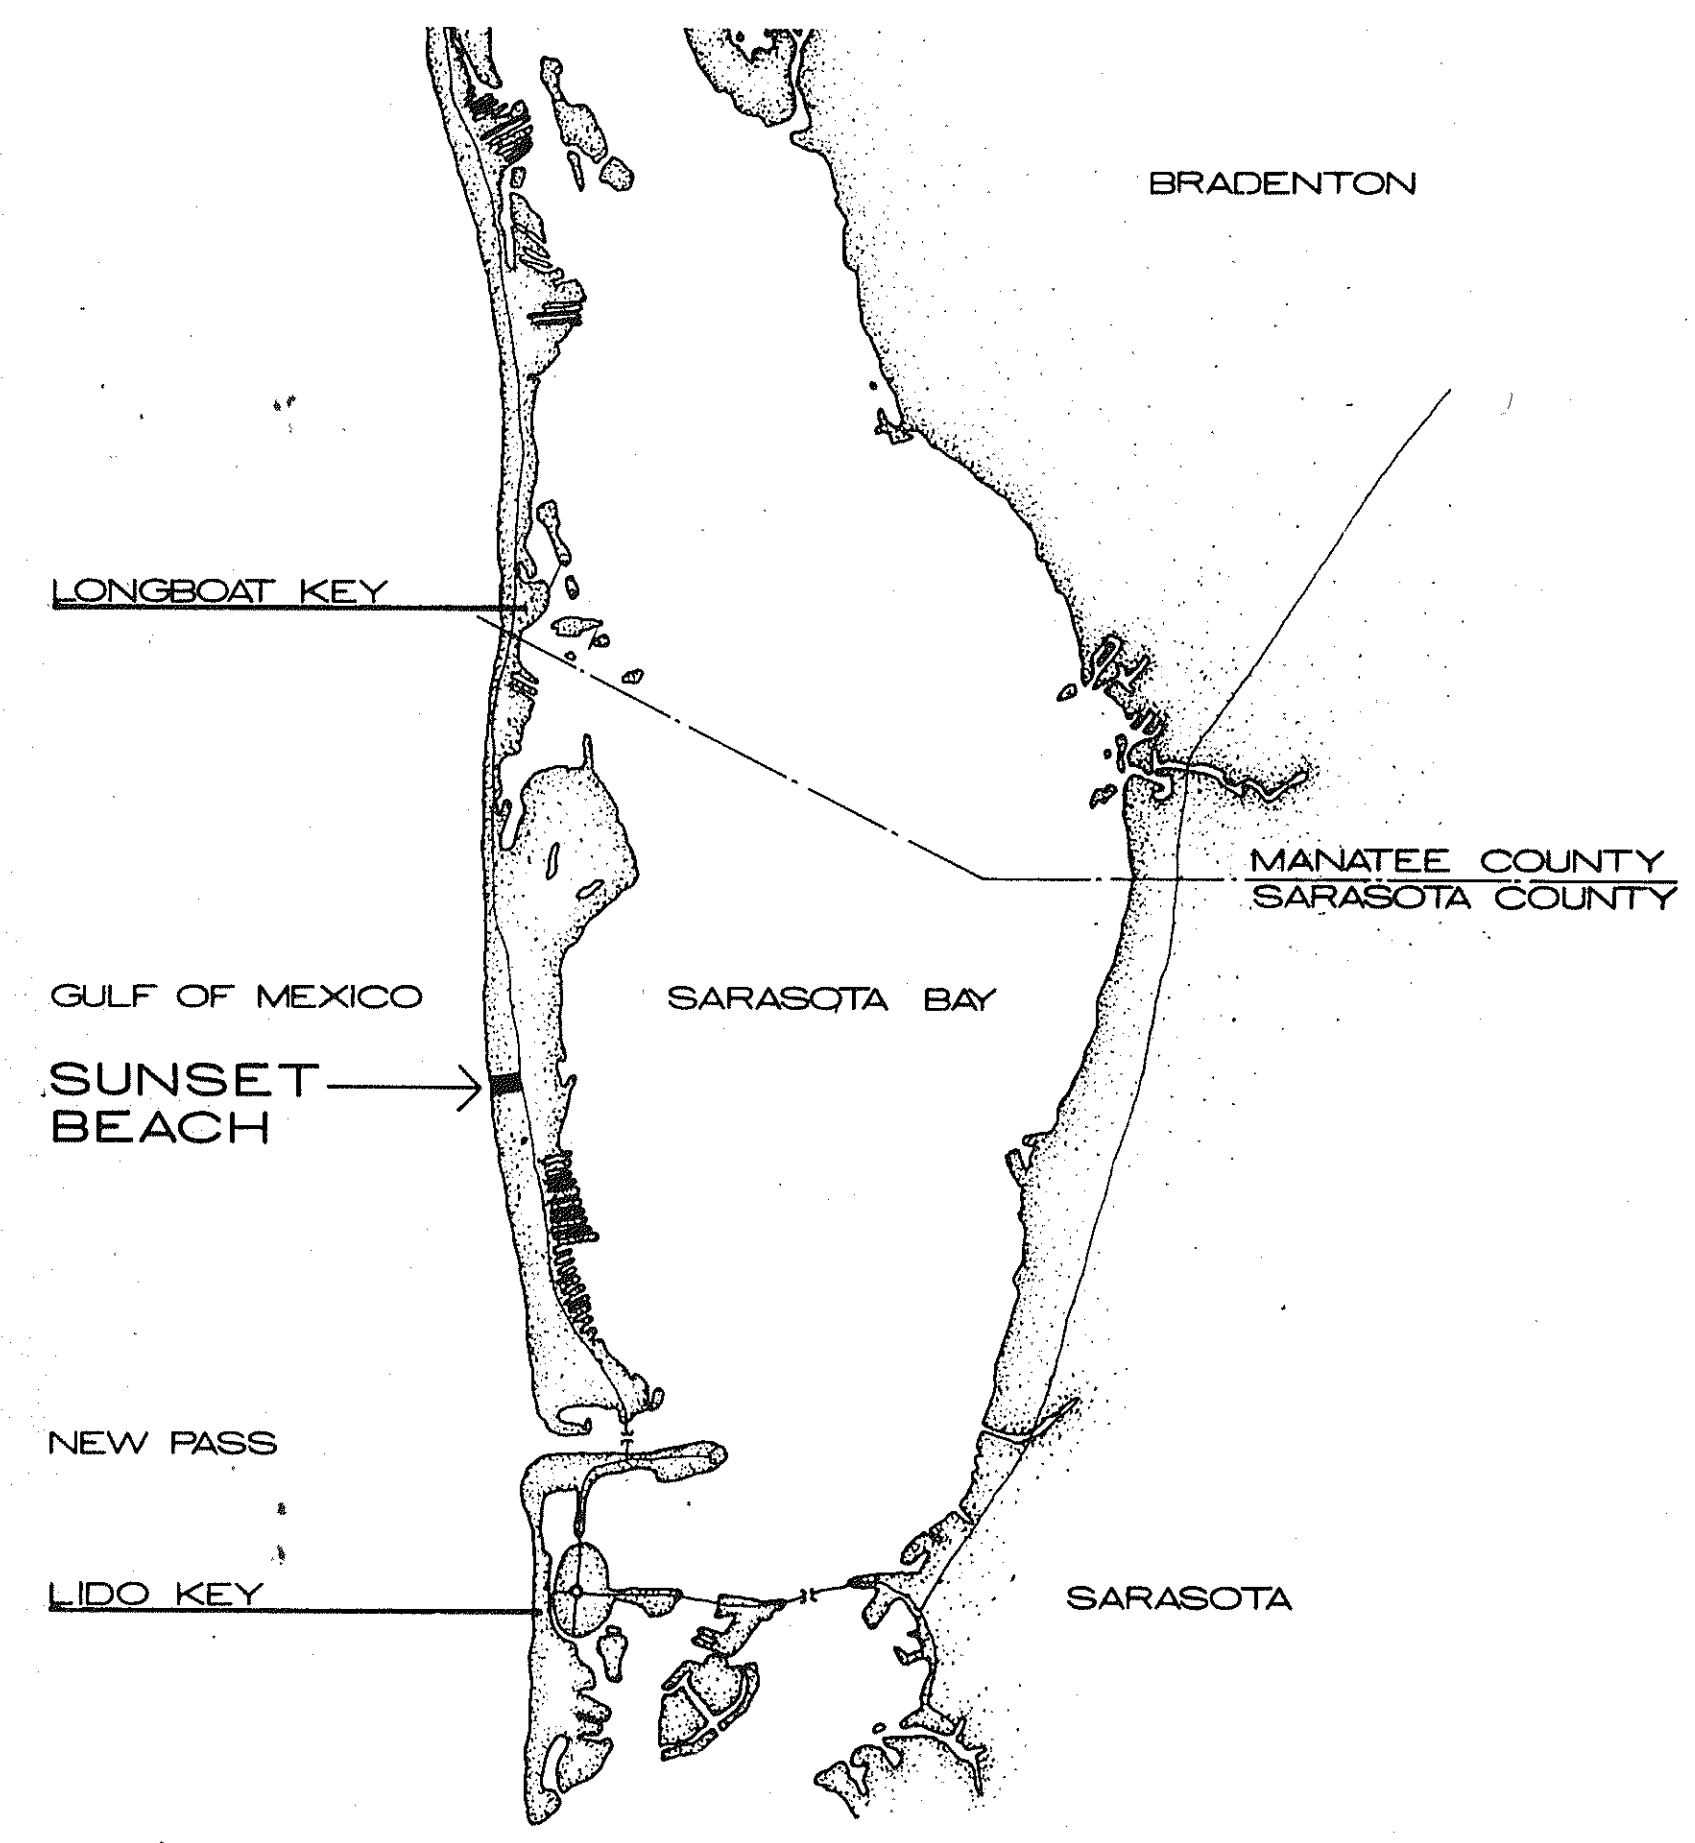


OVERLAYS
COMPOSITE

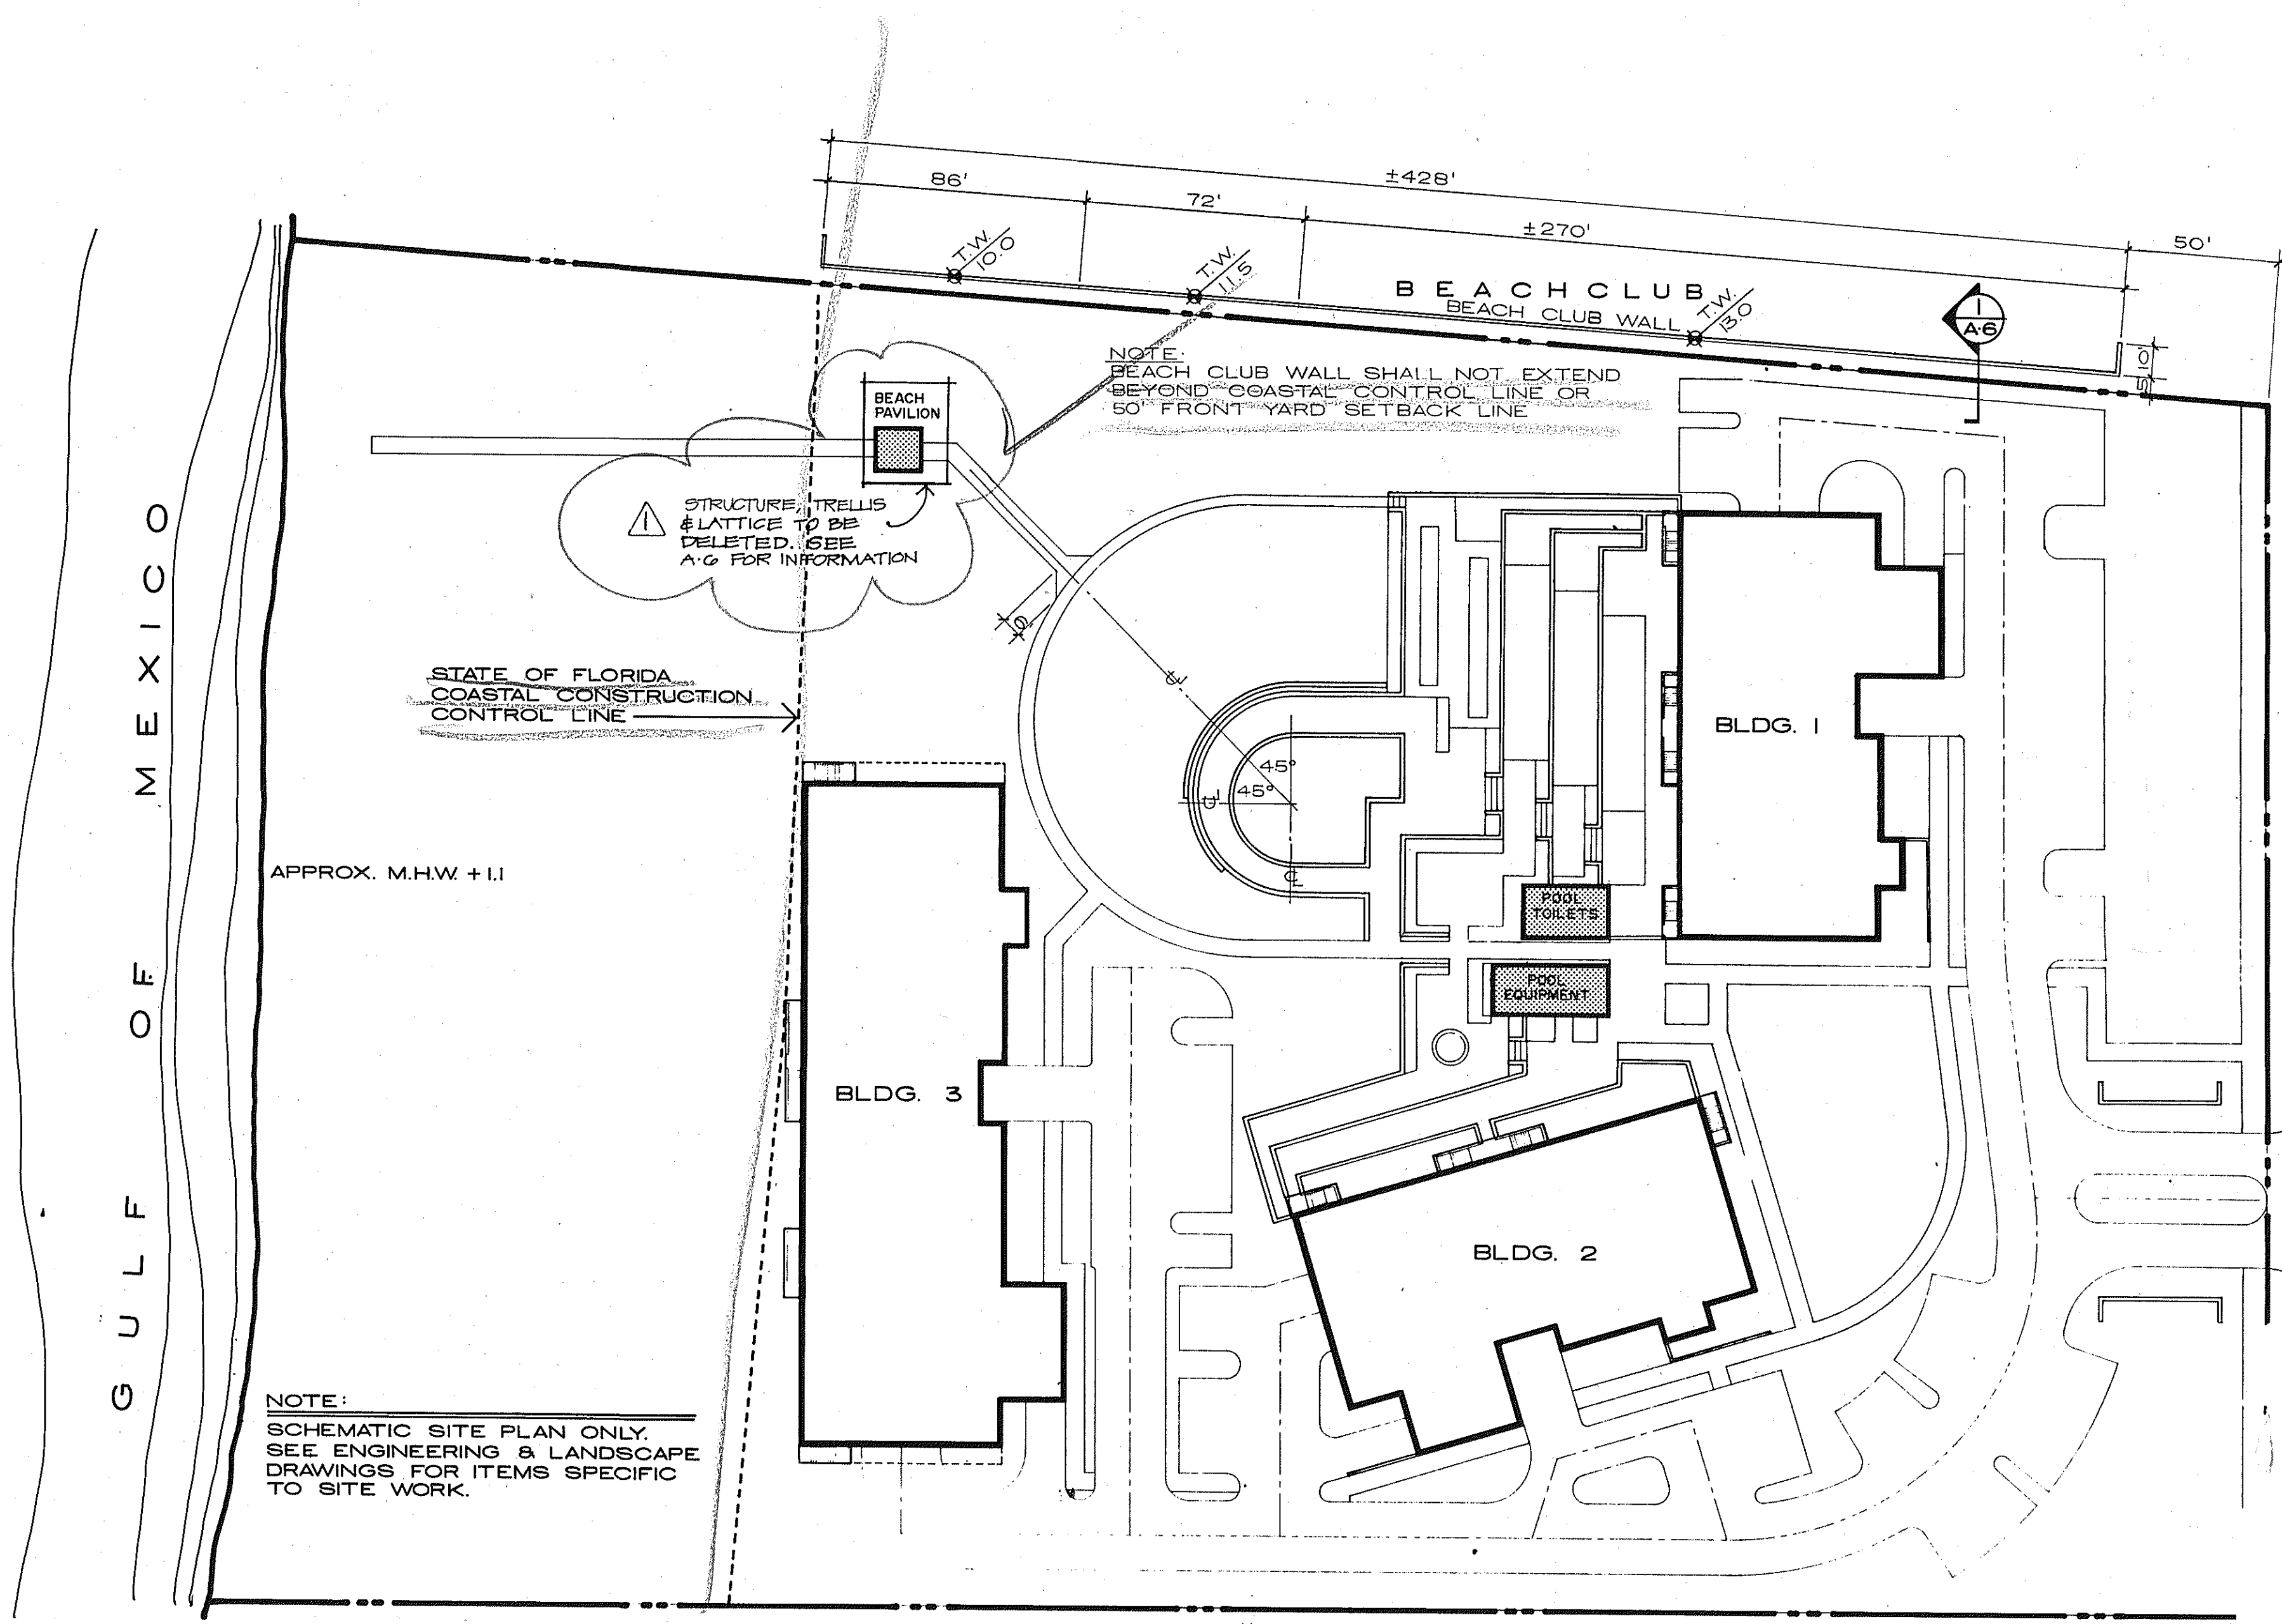


LOCATION MAP

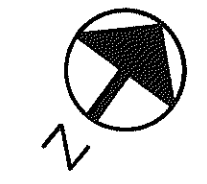

SITE PLAN

1" = 40'

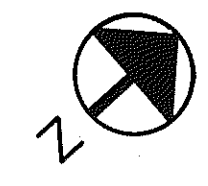

NOTE: ALL POOL SIGNAGE SHALL BE APPROVED BY ARCHITECT PRIOR TO FABRICATION.

SUNSET BEACH
OF LONGBOAT KEY

MAP & SITE PLAN 1" = 40'

T & PLANNER PA - THE SWA GROUP
N WHITE & ASSOCIATES STRUCTURAL ENGINEERS · BENNETT & BISHOP INC CONSULTING ENGINEERS & SURVEYORS

EXICICO DRIVE