




**DETAIL A**  
TYP. PARAPET  
1 1/2" = 1'-0"

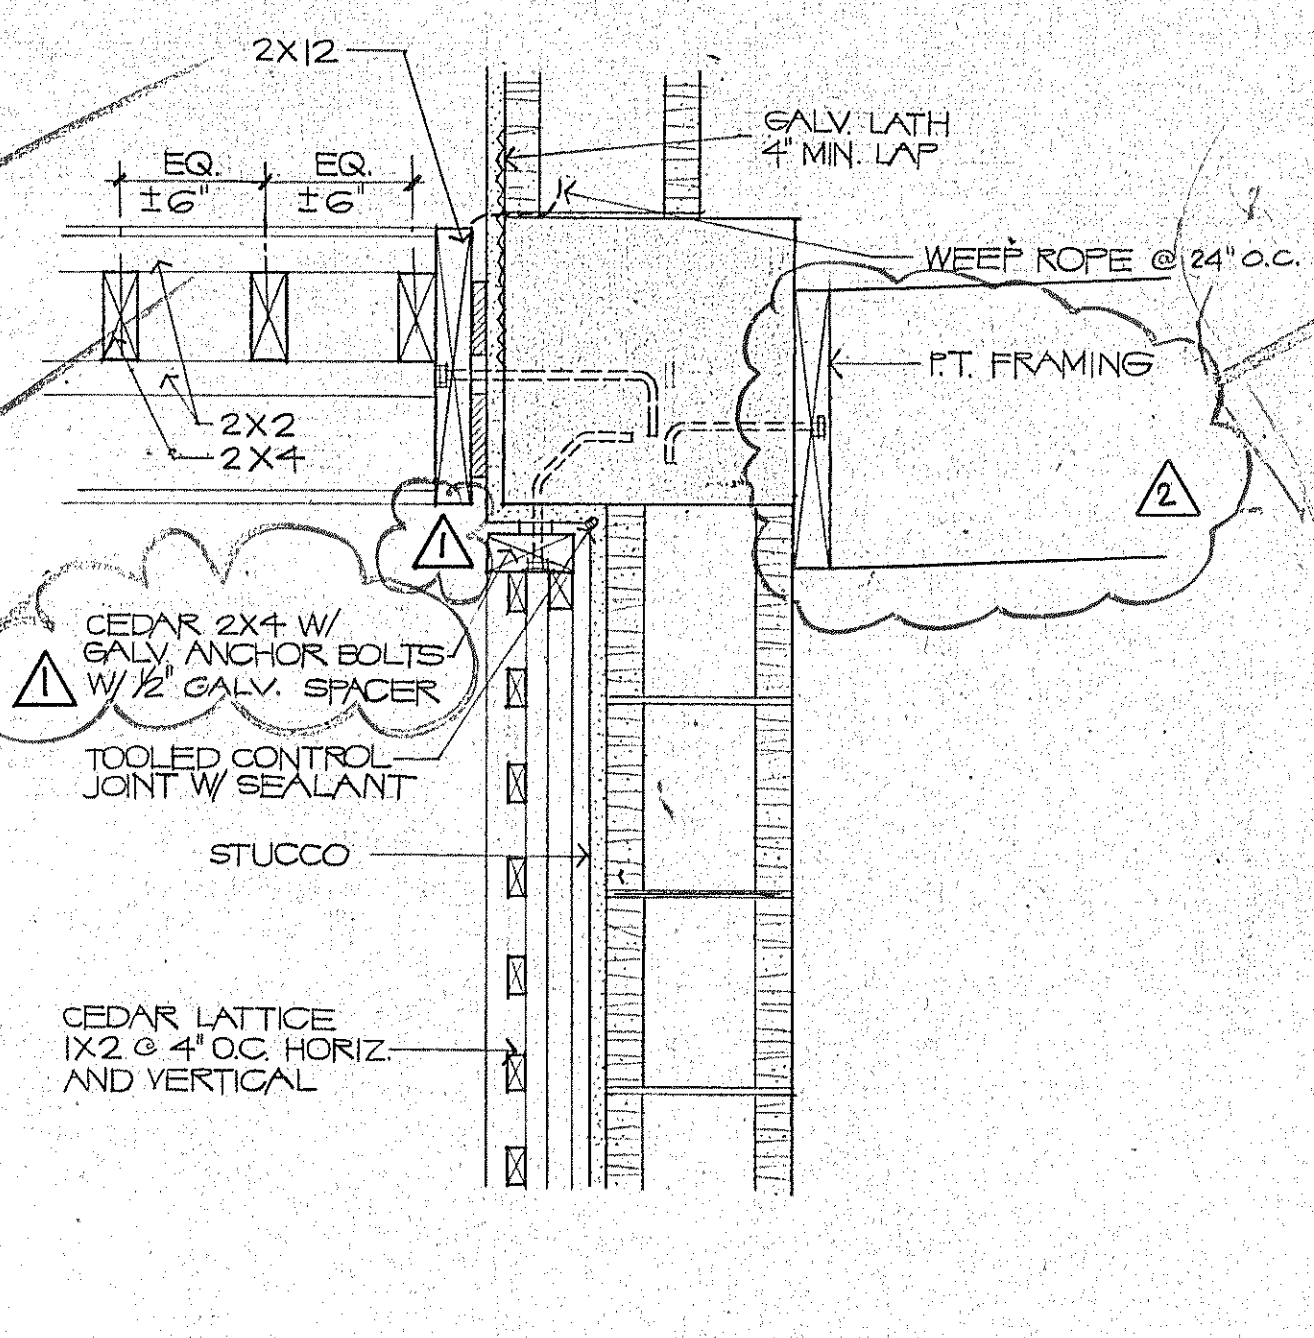


**DETAIL B**  
LATTICE HEAD  
1 1/2" = 1'-0"

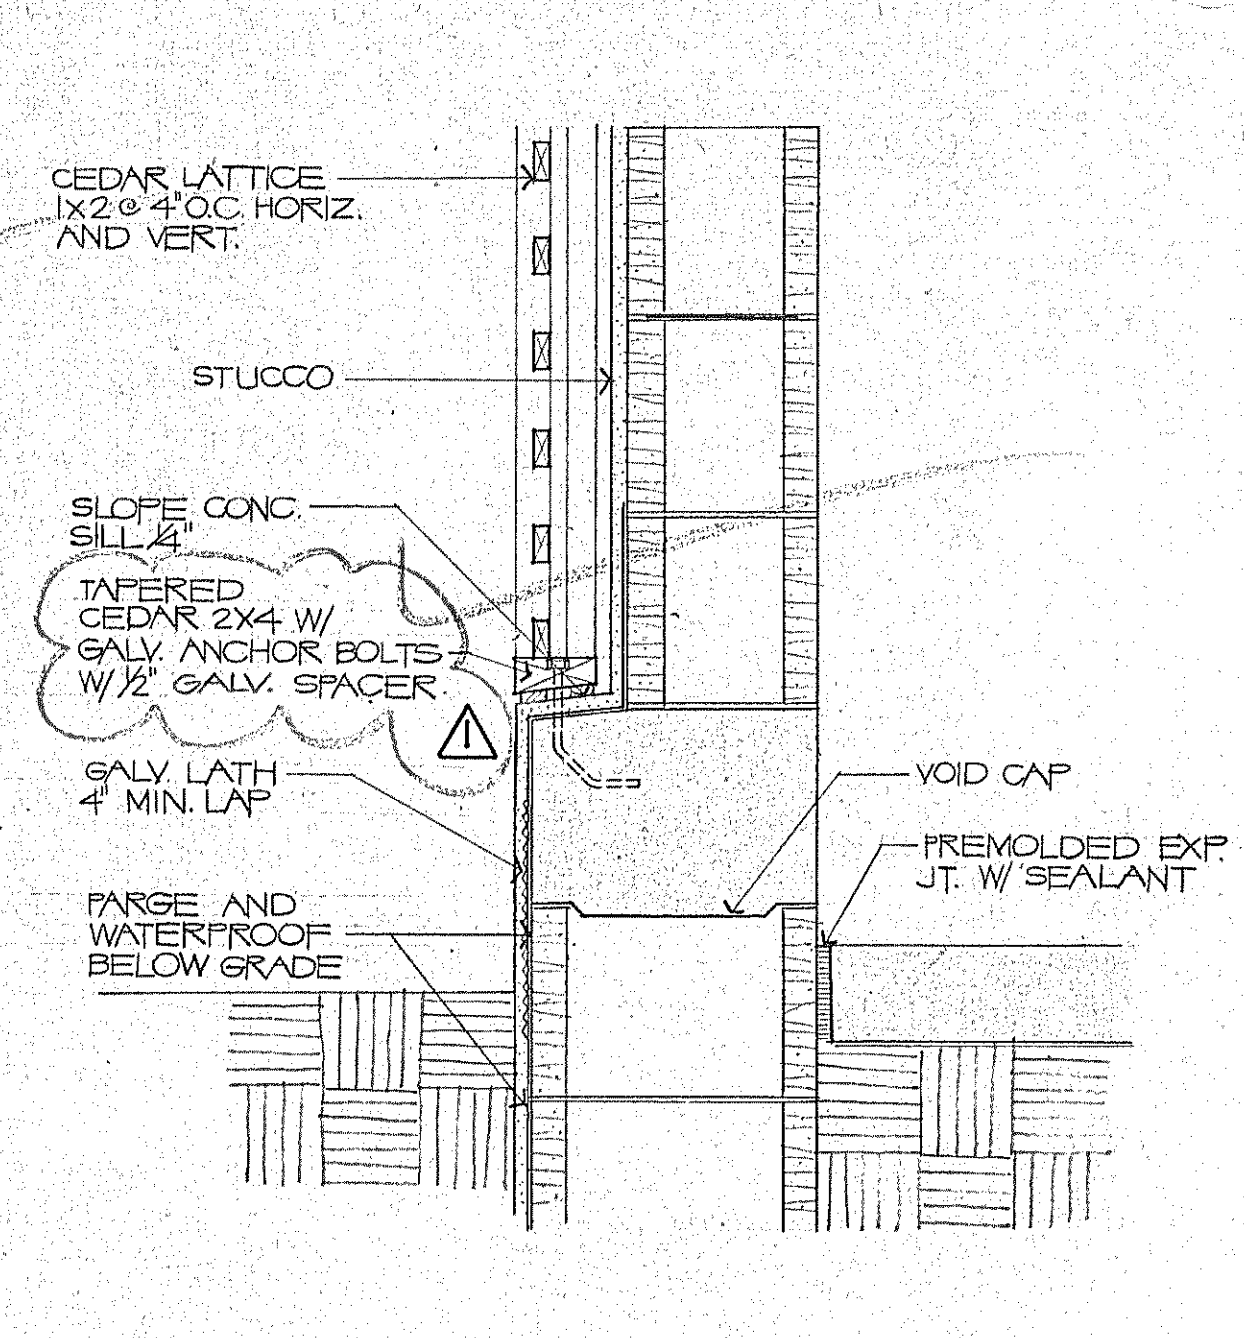


**DETAIL C**  
LATTICE SILL  
1 1/2" = 1'-0"

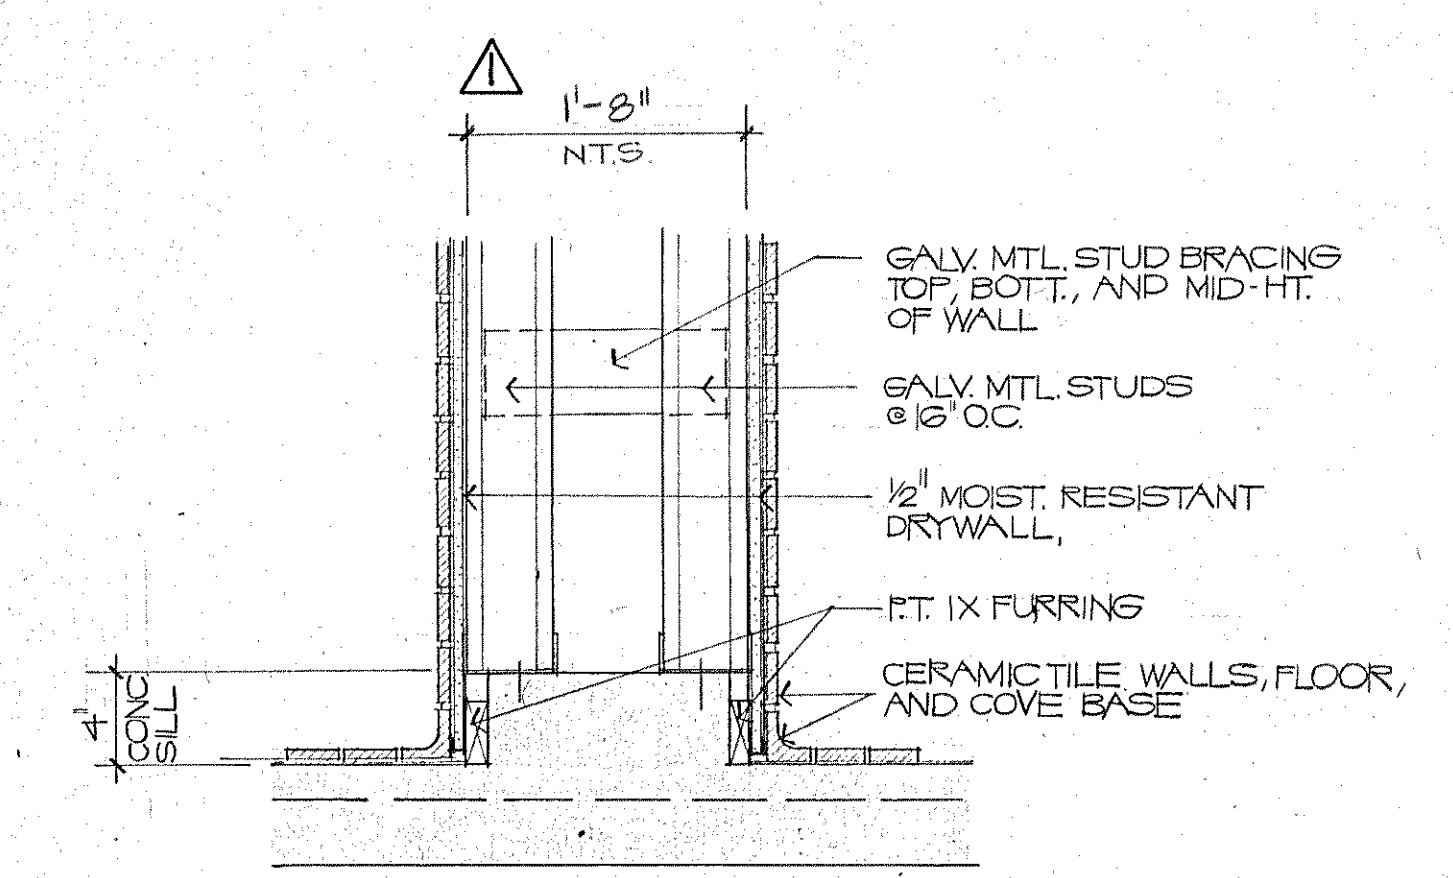


**DETAIL D**  
TOILET ROOM  
CHASE WALL  
1 1/2" = 1'-0"

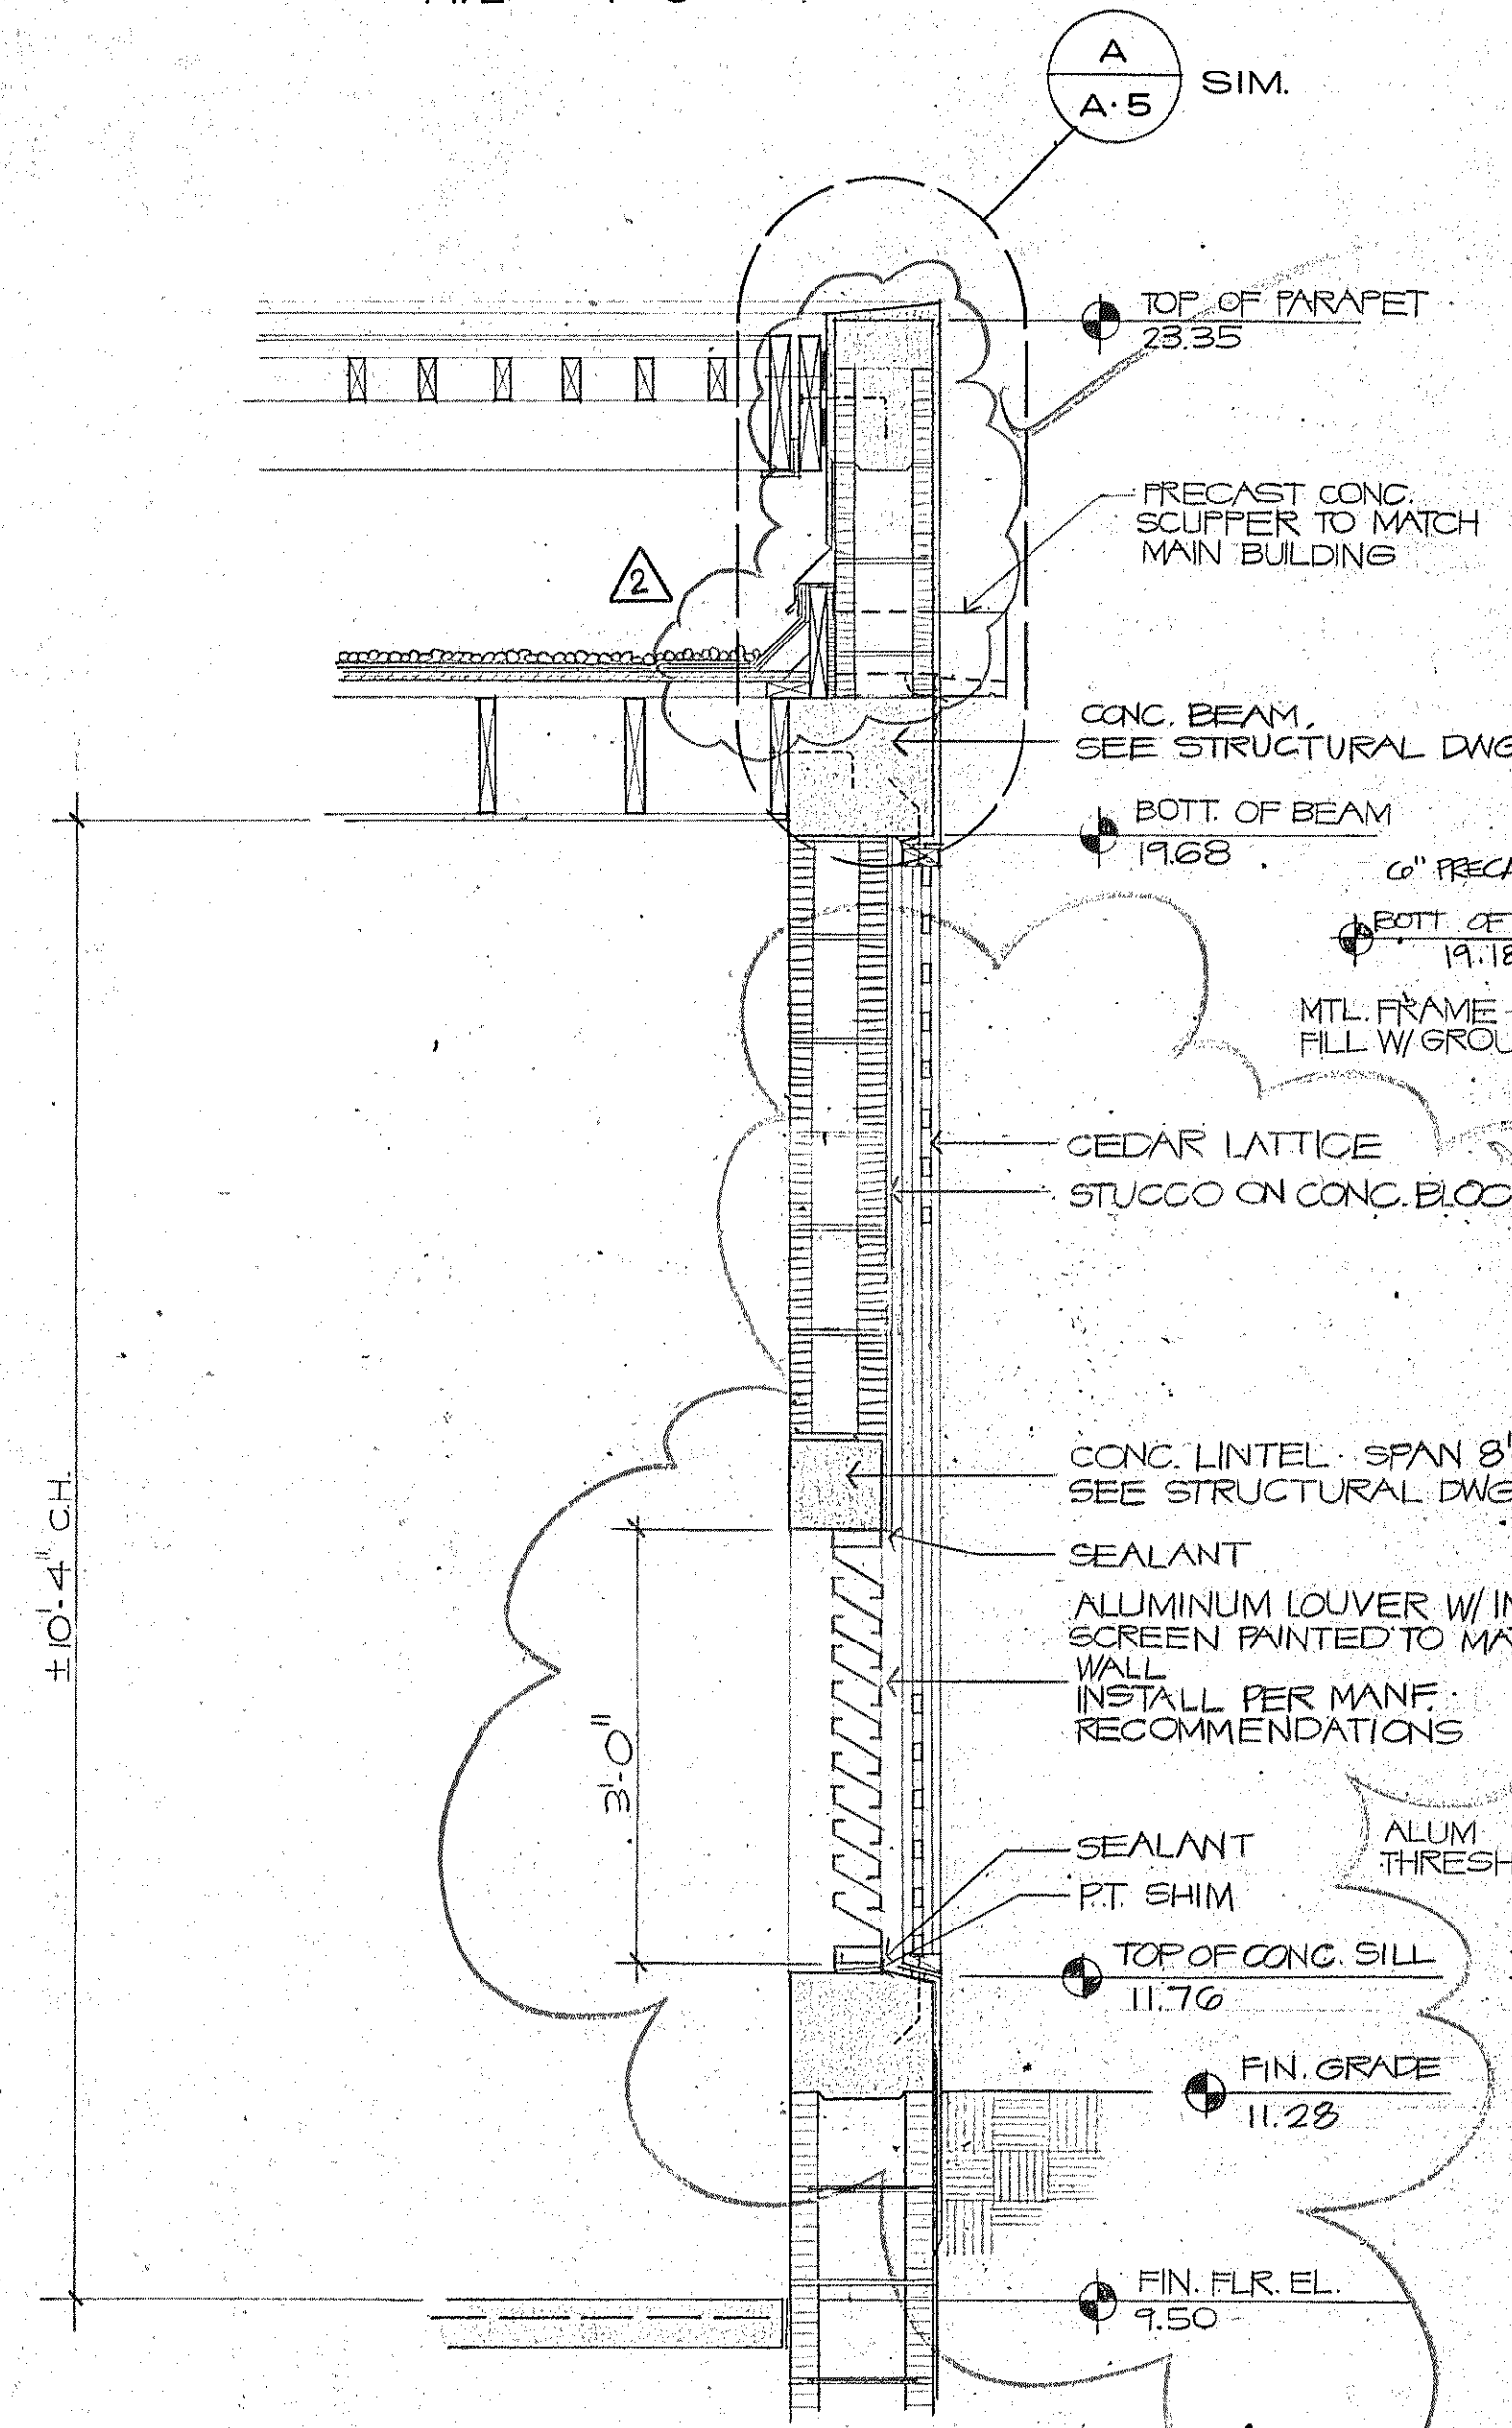


**SECTION 1**  
TYP. 3/4" = 1'-0"

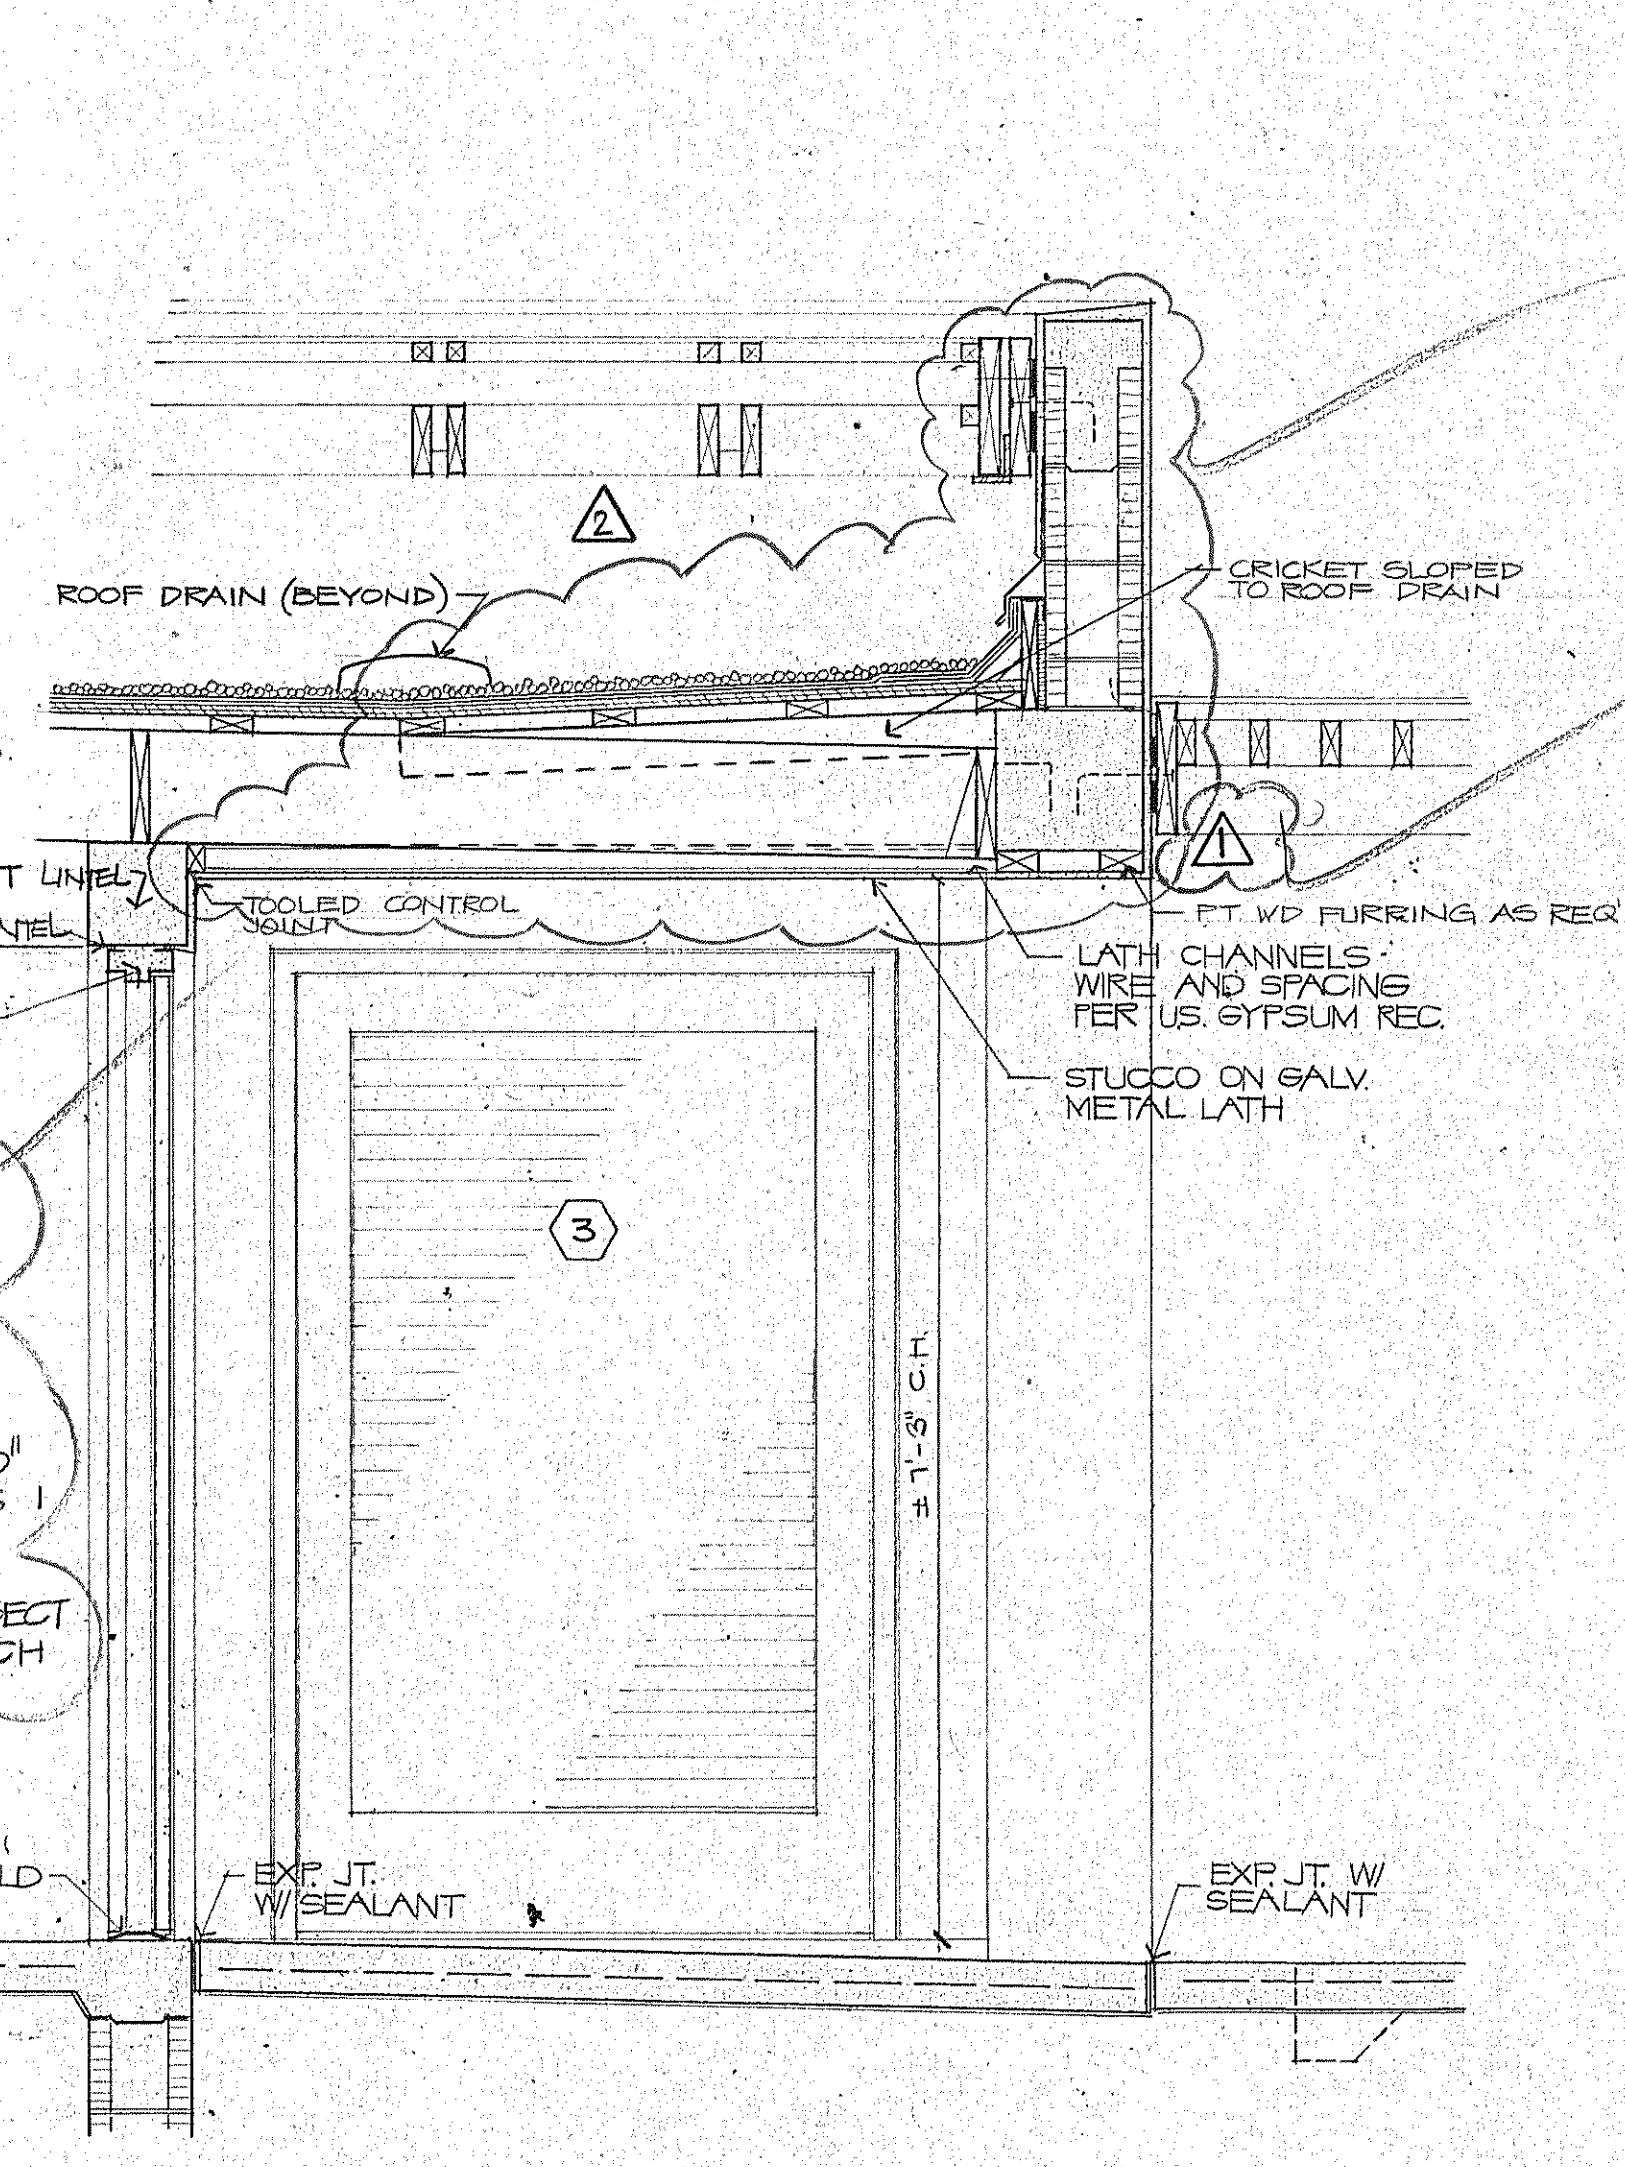

**SECTION 2**  
1 1/2" = 1'-0"

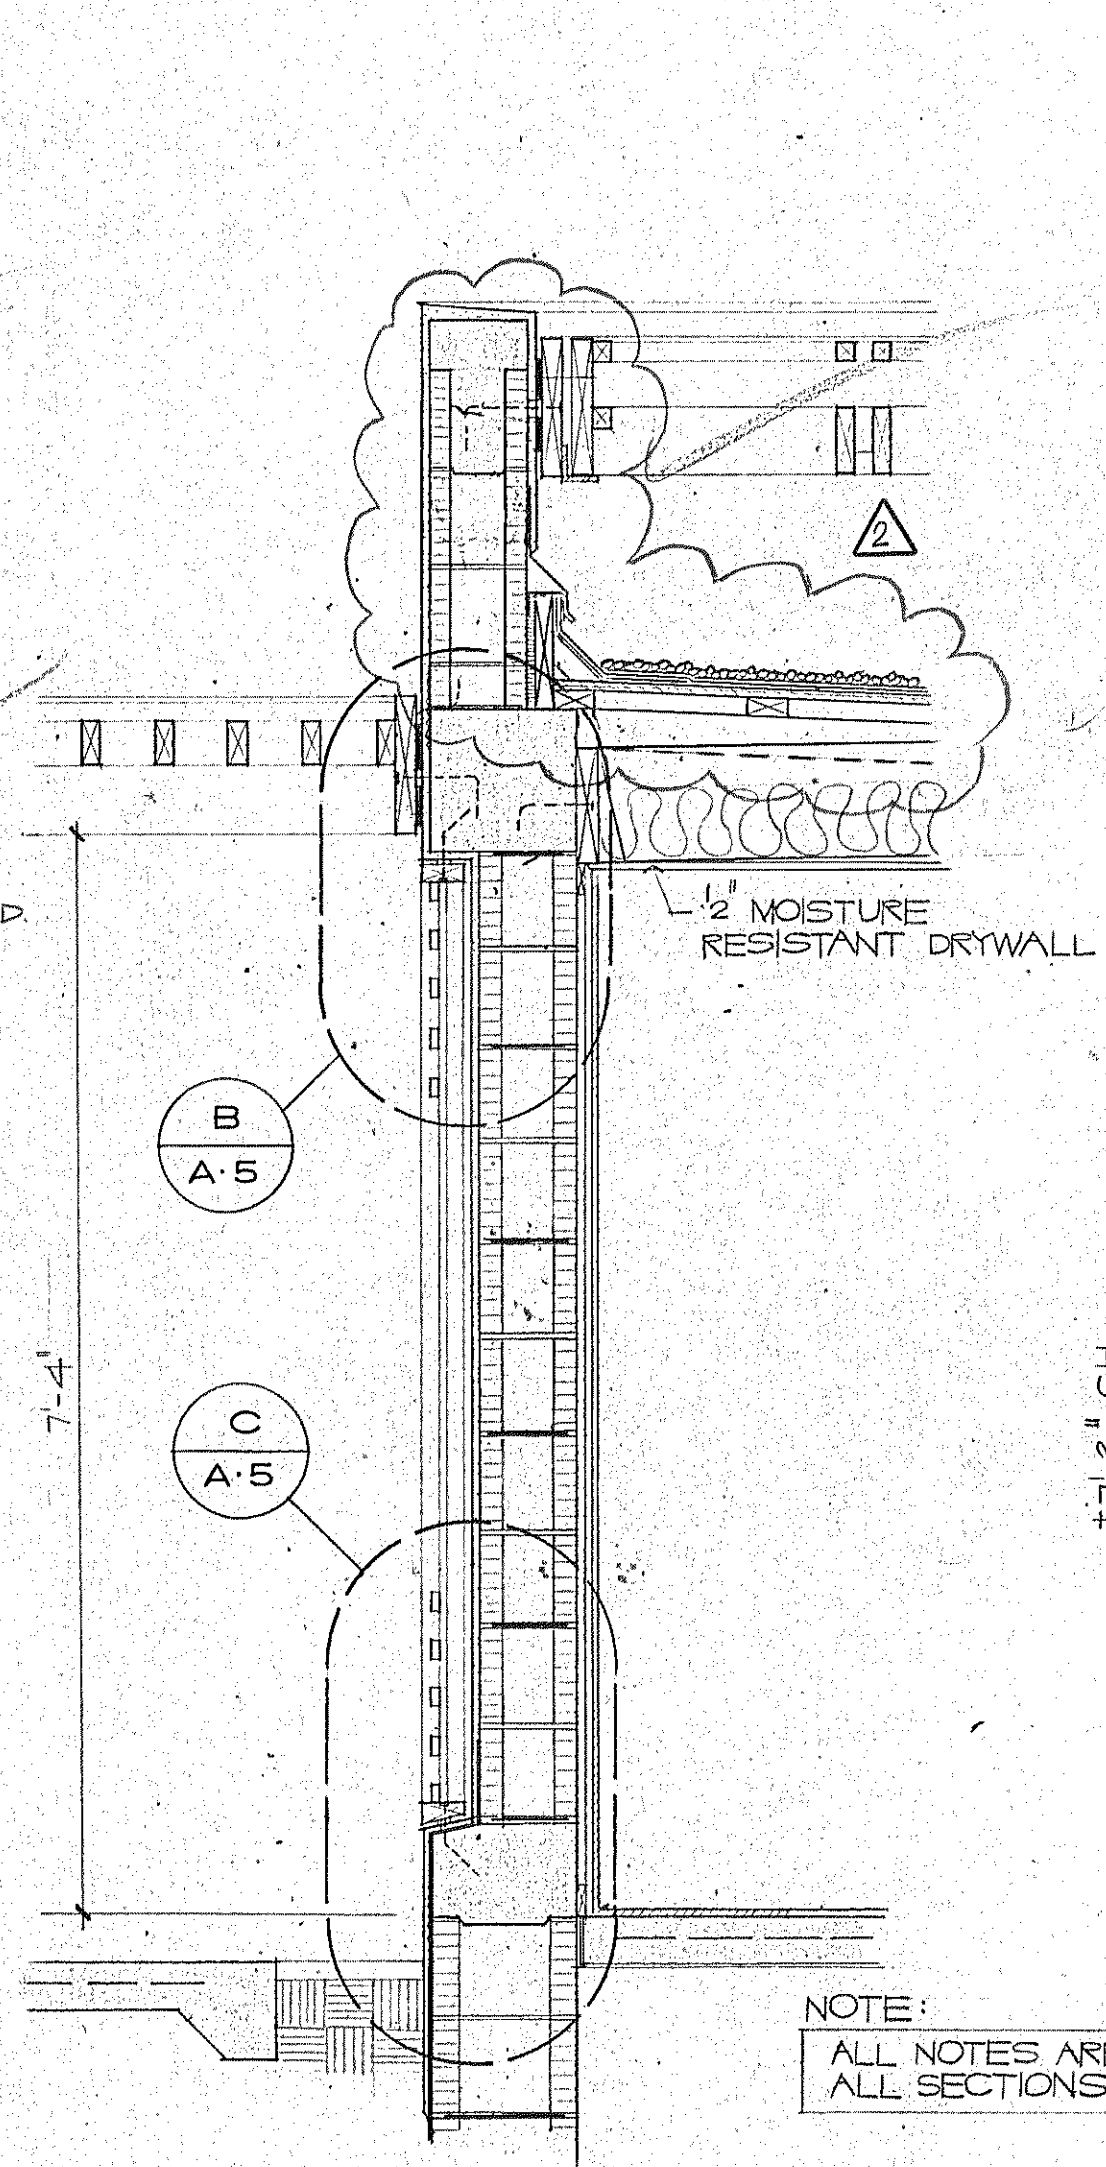

**SECTION 3**  
1 1/2" = 1'-0"

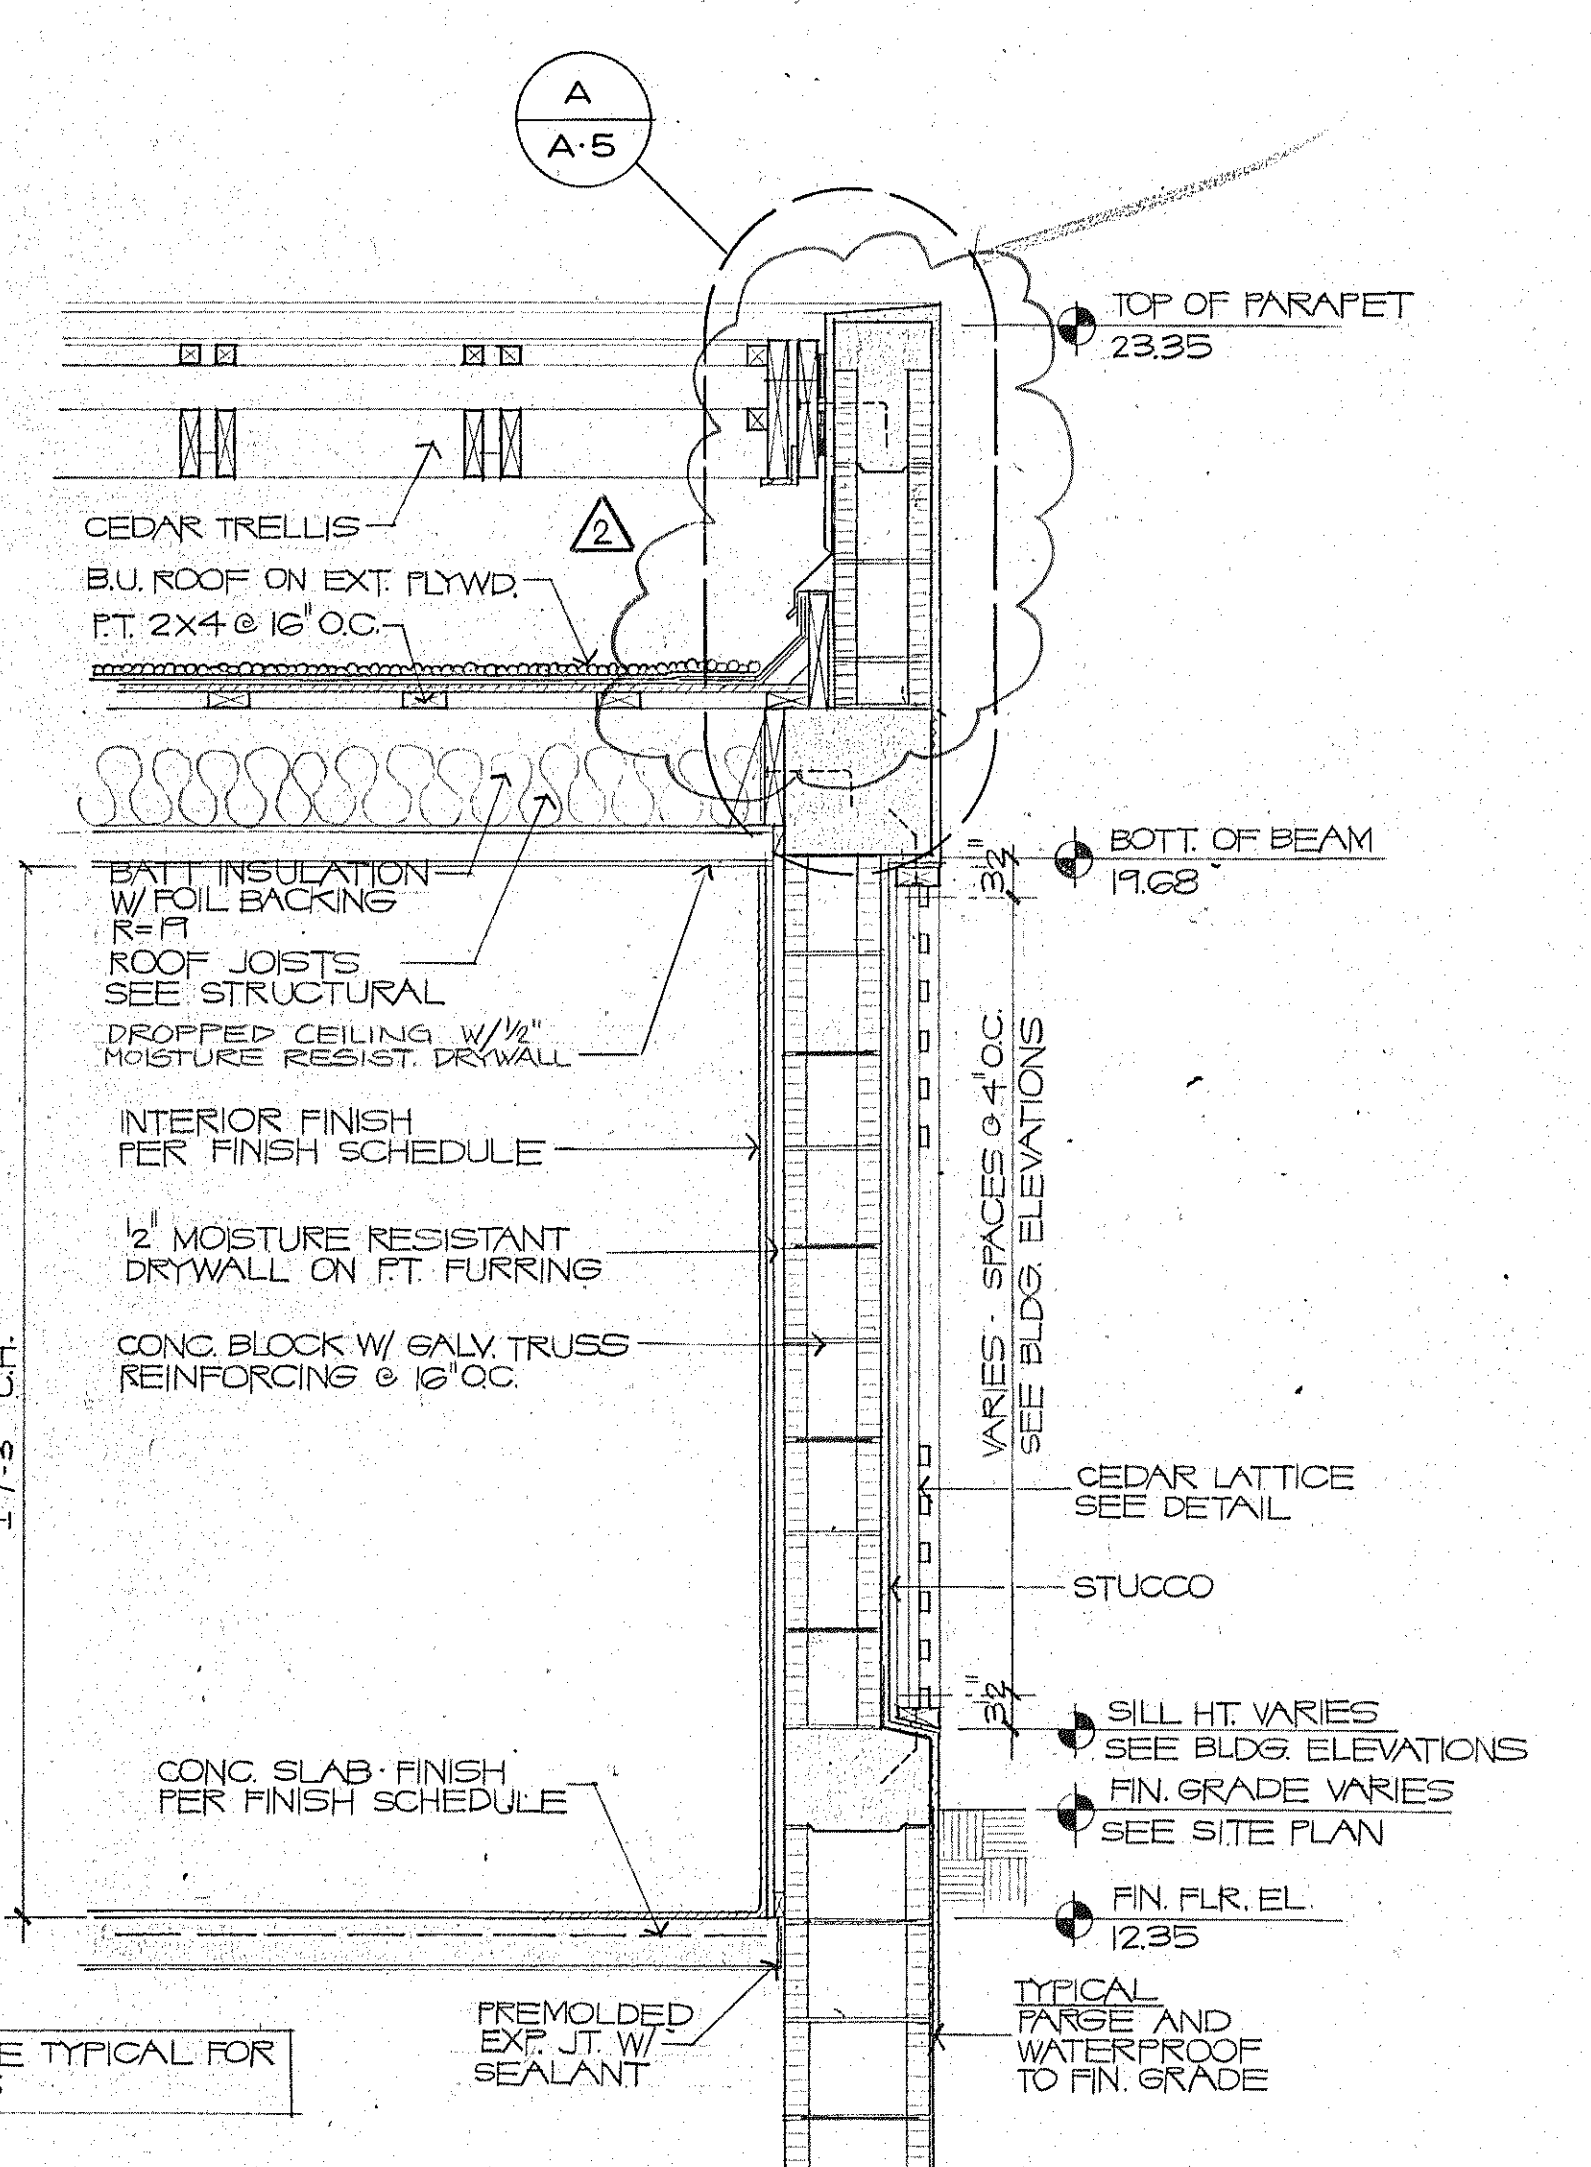

**SECTION 4**  
1 1/2" = 1'-0"

NOTE:  
ALL NOTES ARE TYPICAL FOR  
ALL SECTIONS