



SEE PLAN FOR FOUNDATION INFO.


SECTION 1  
S5 1/2" = 1'-0"

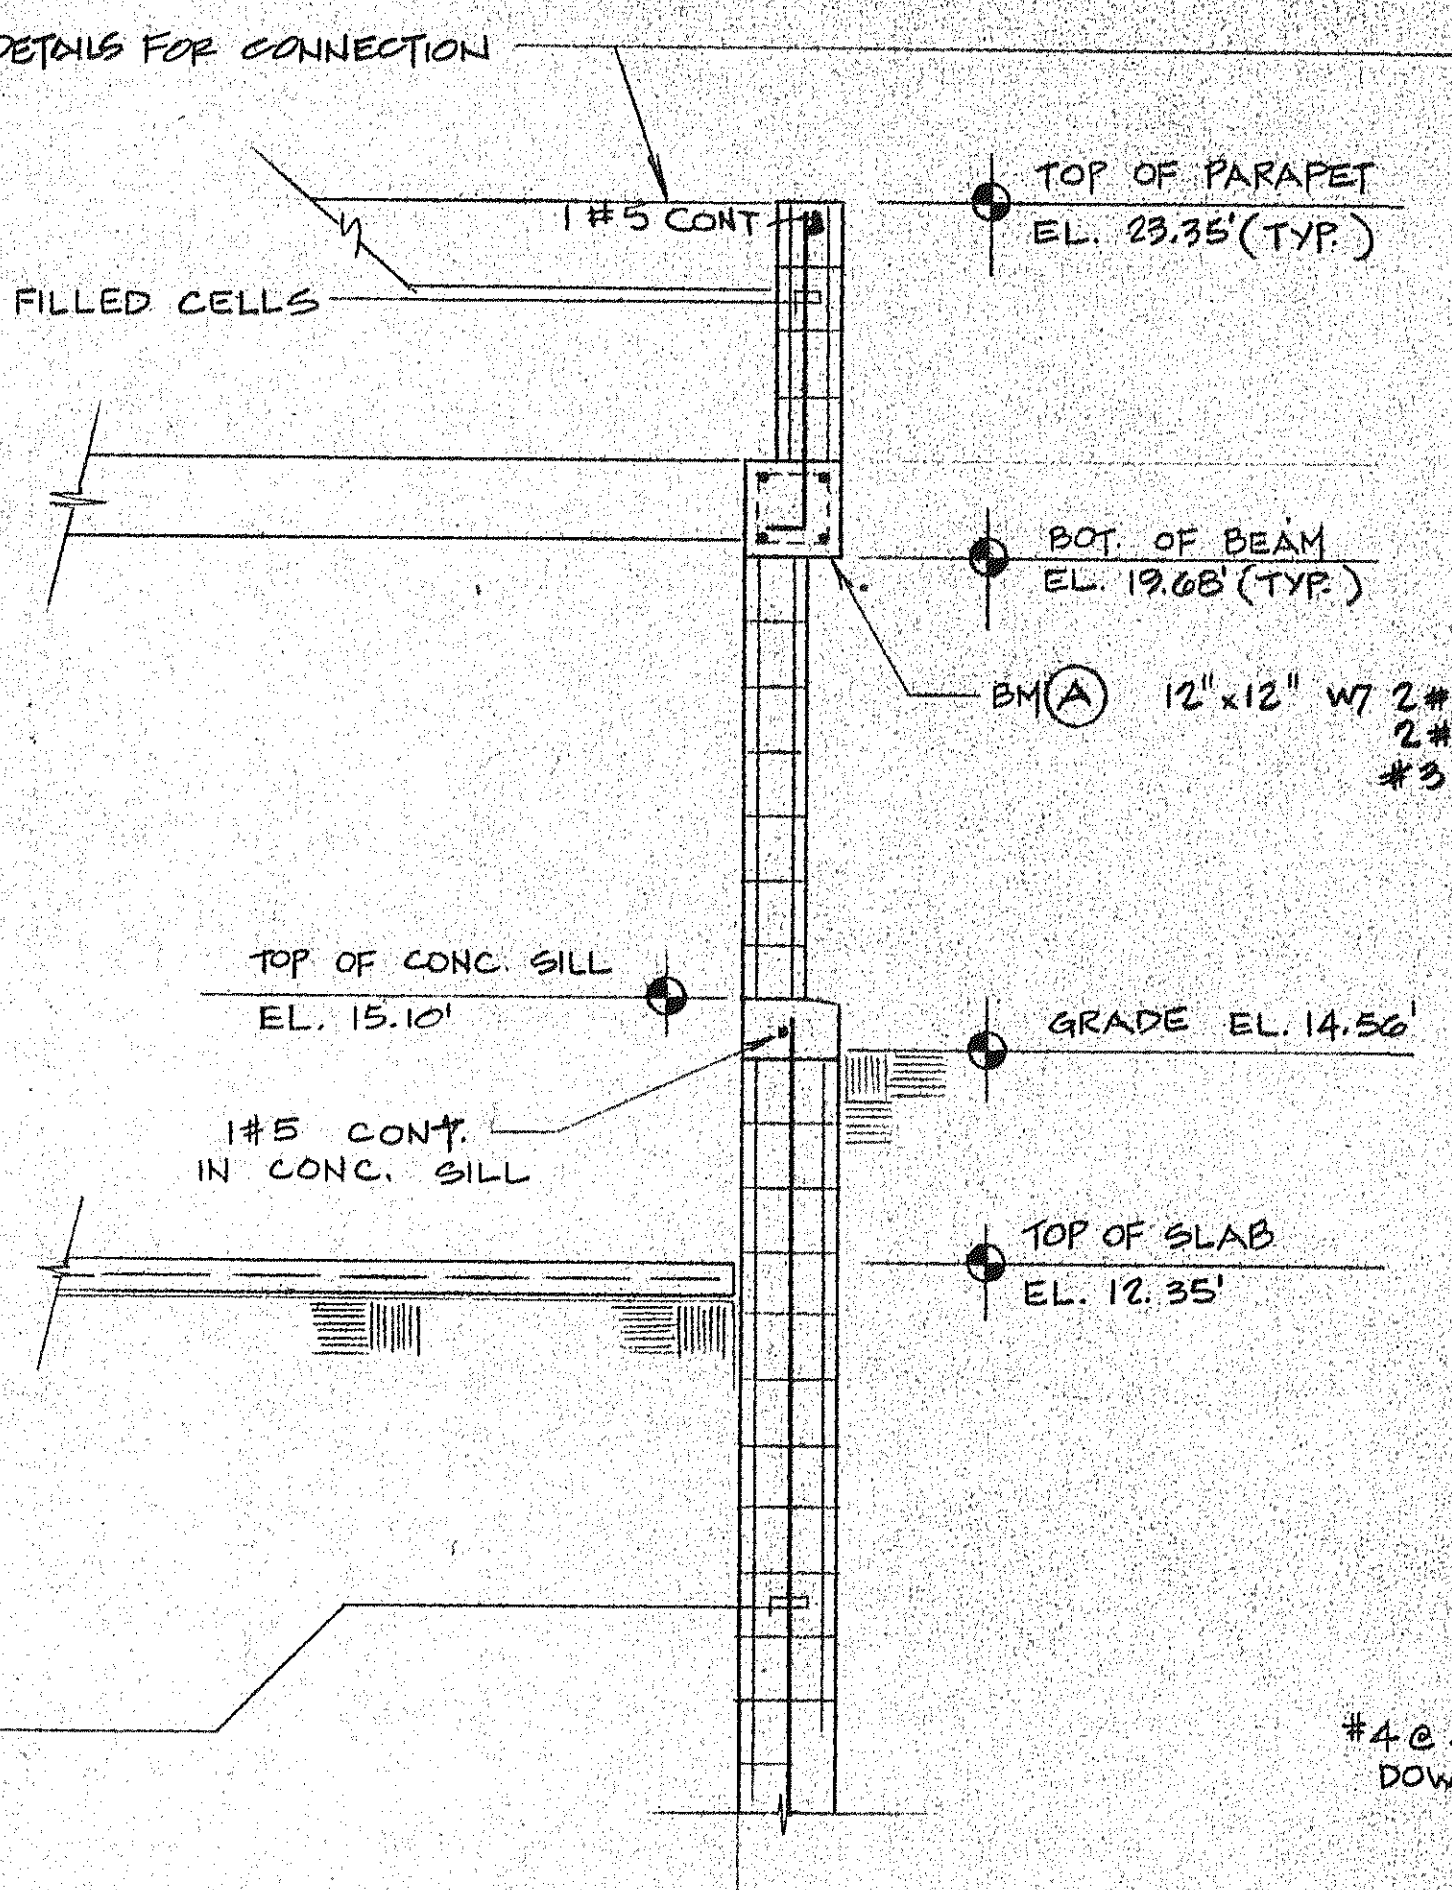


SECTION 2  
S5 1/2" = 1'-0"

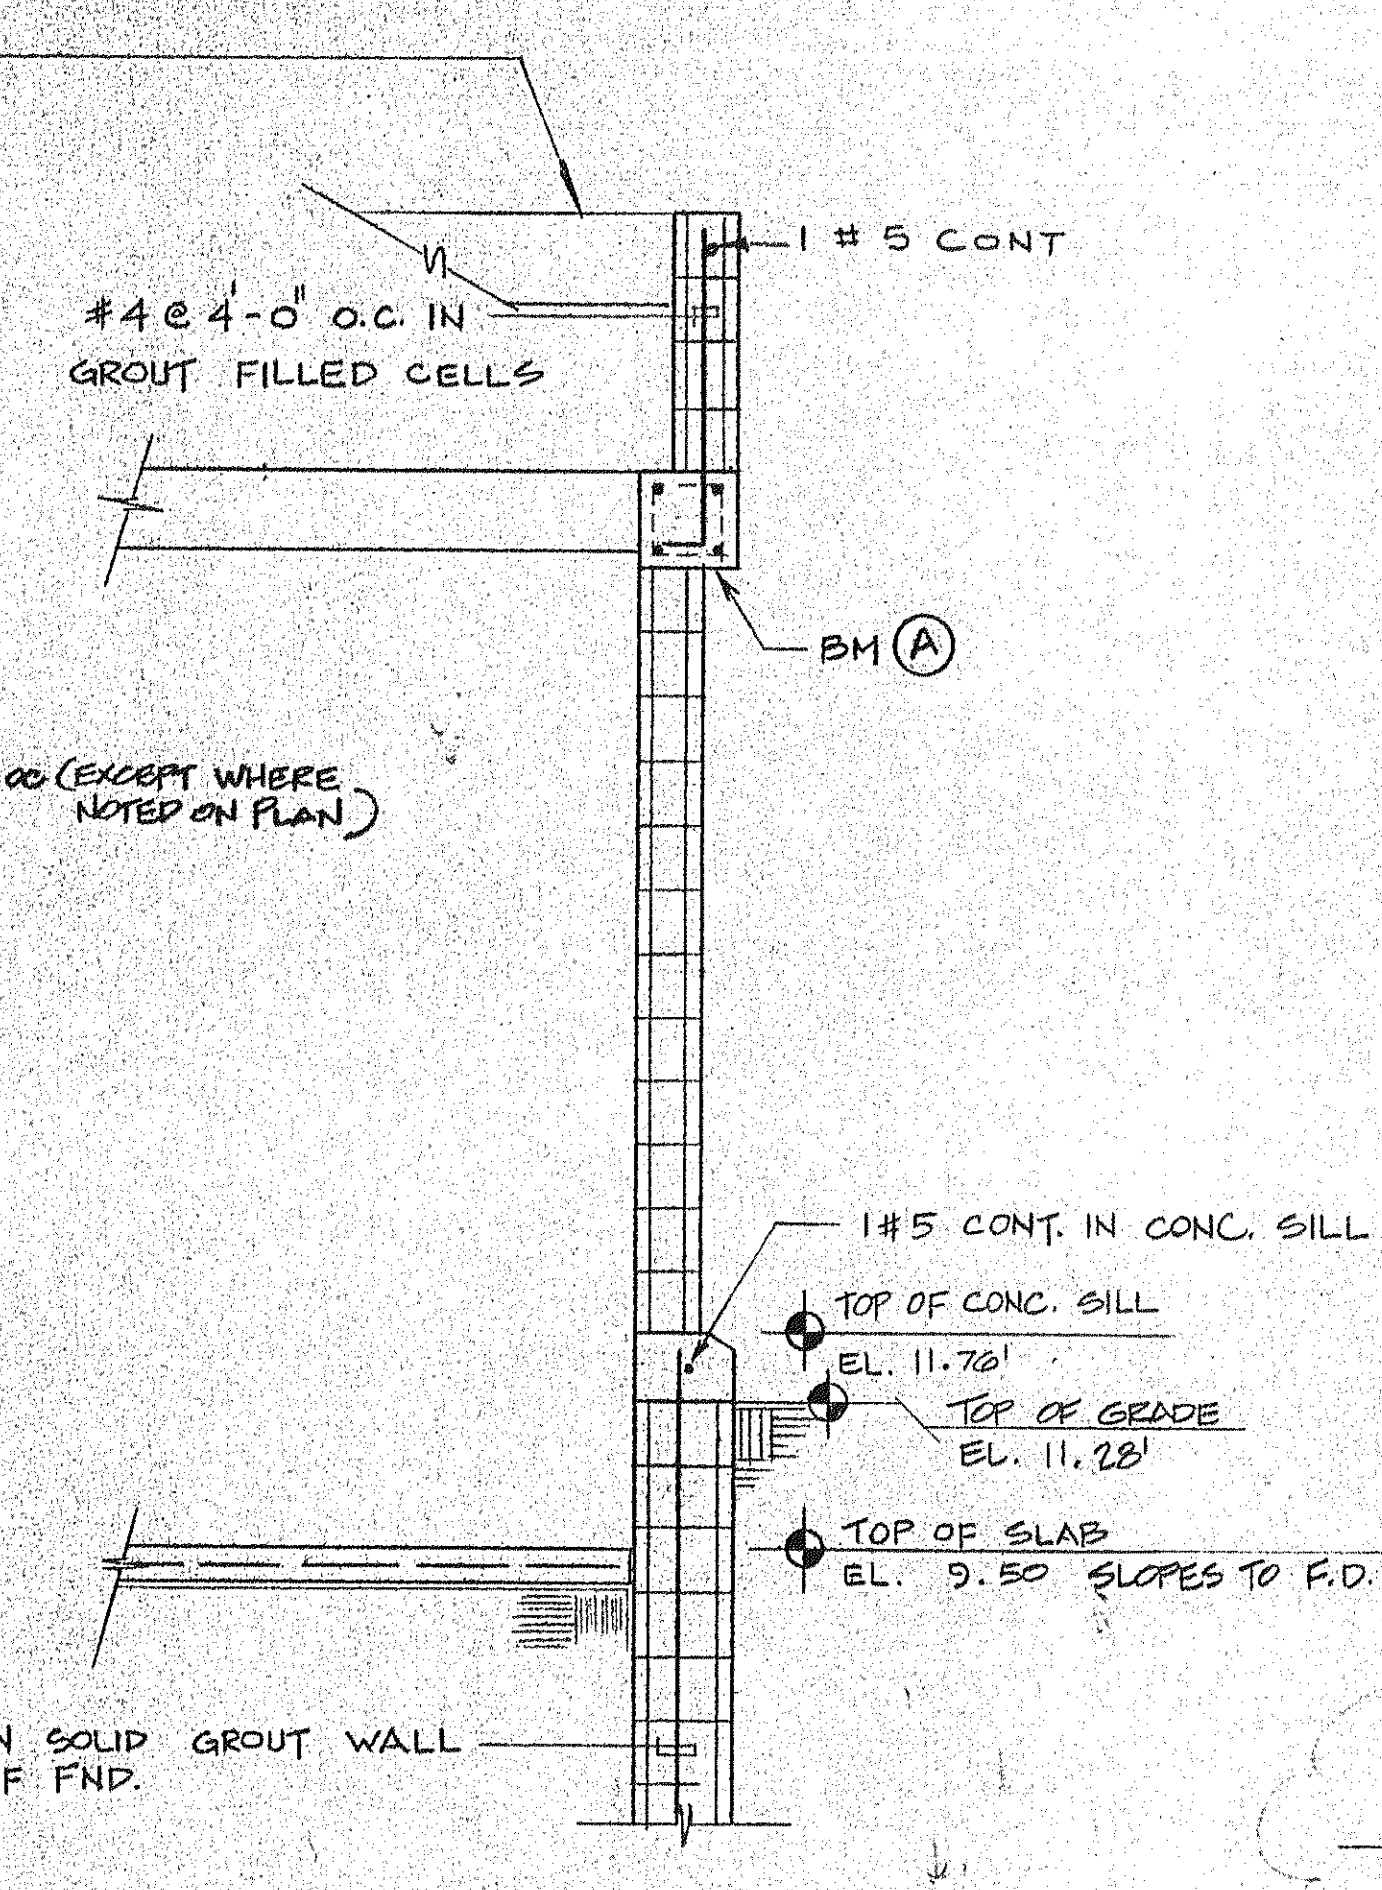


SECTION 3  
S5 1/2" = 1'-0"

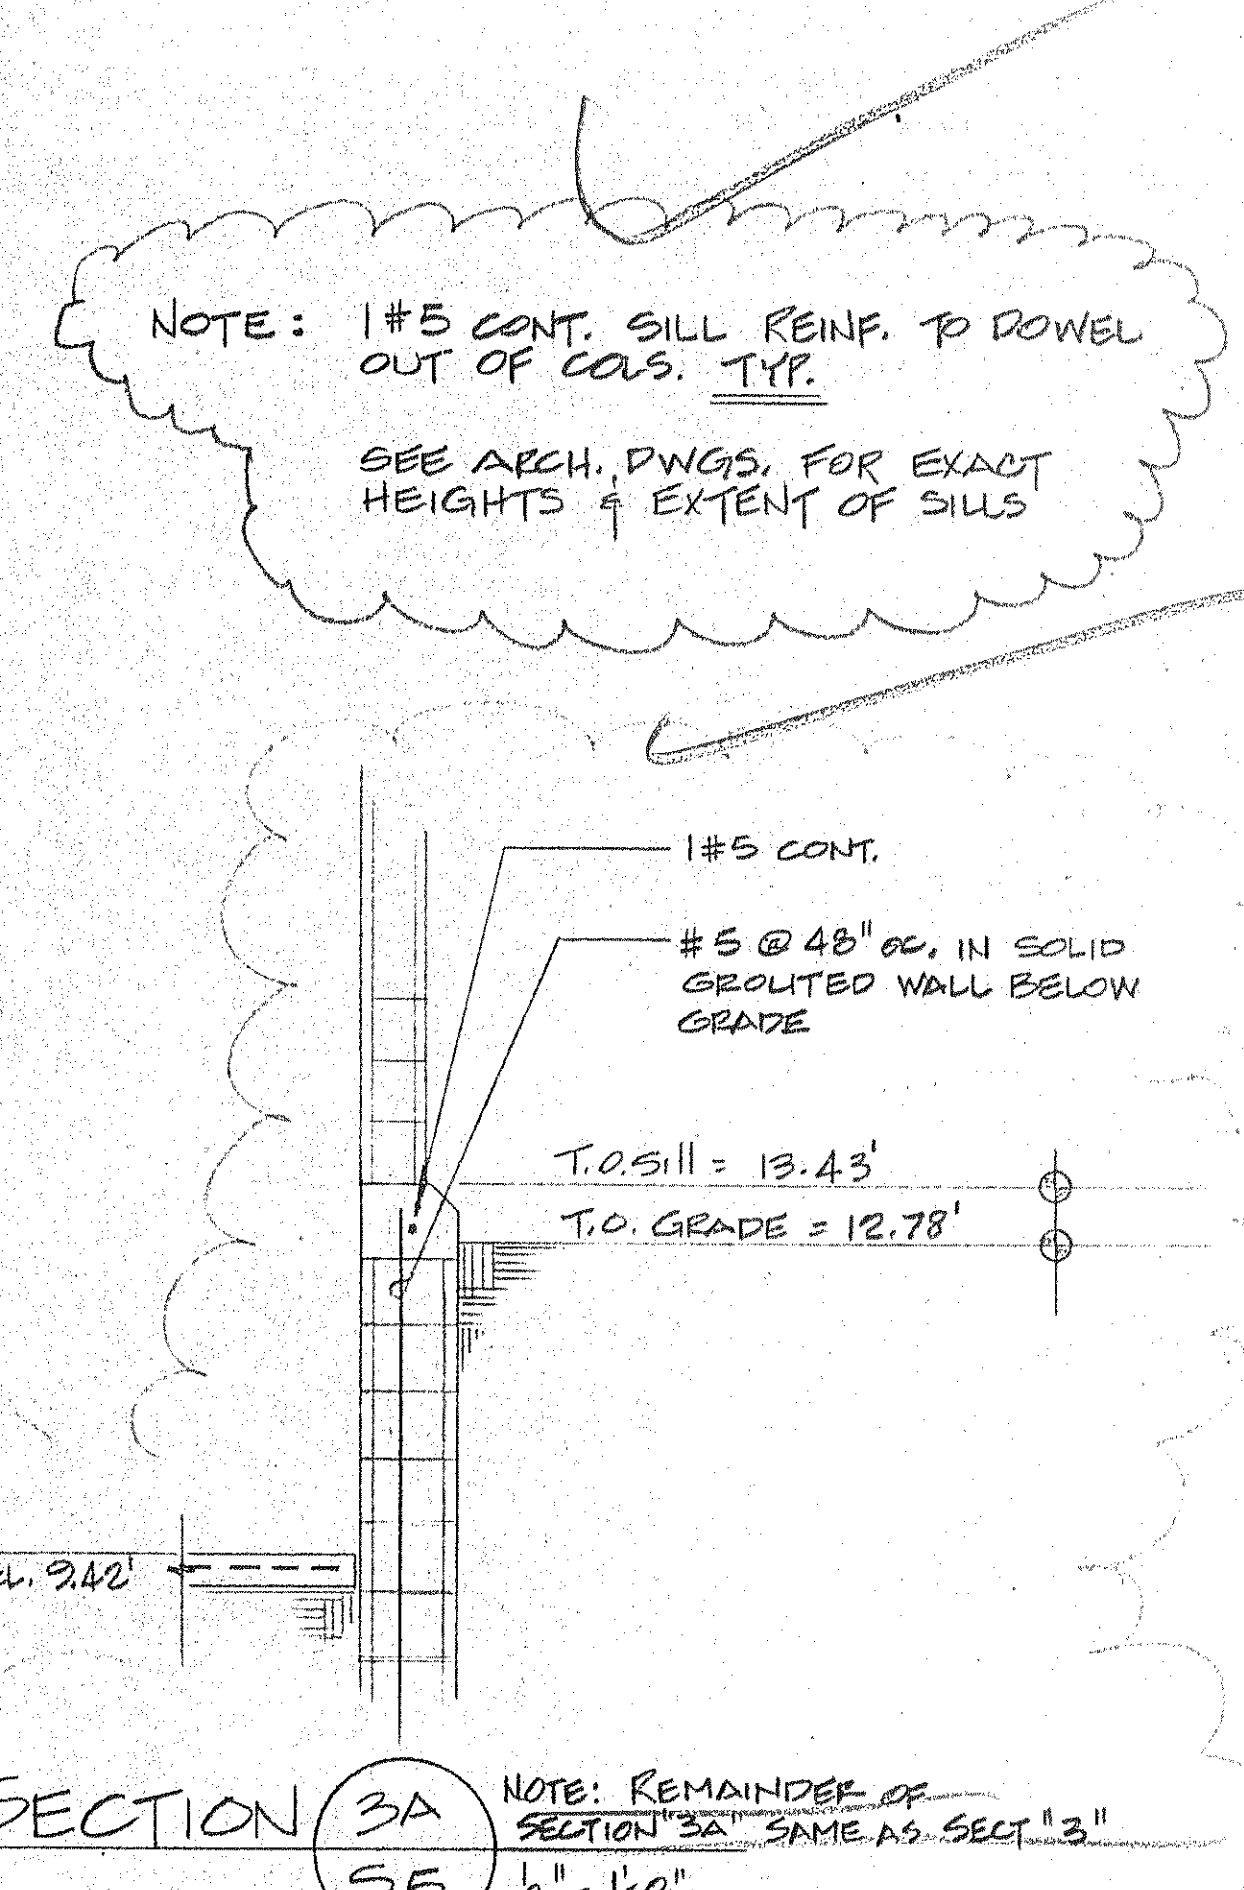


SECTION 3A  
S5 1/2" = 1'-0"

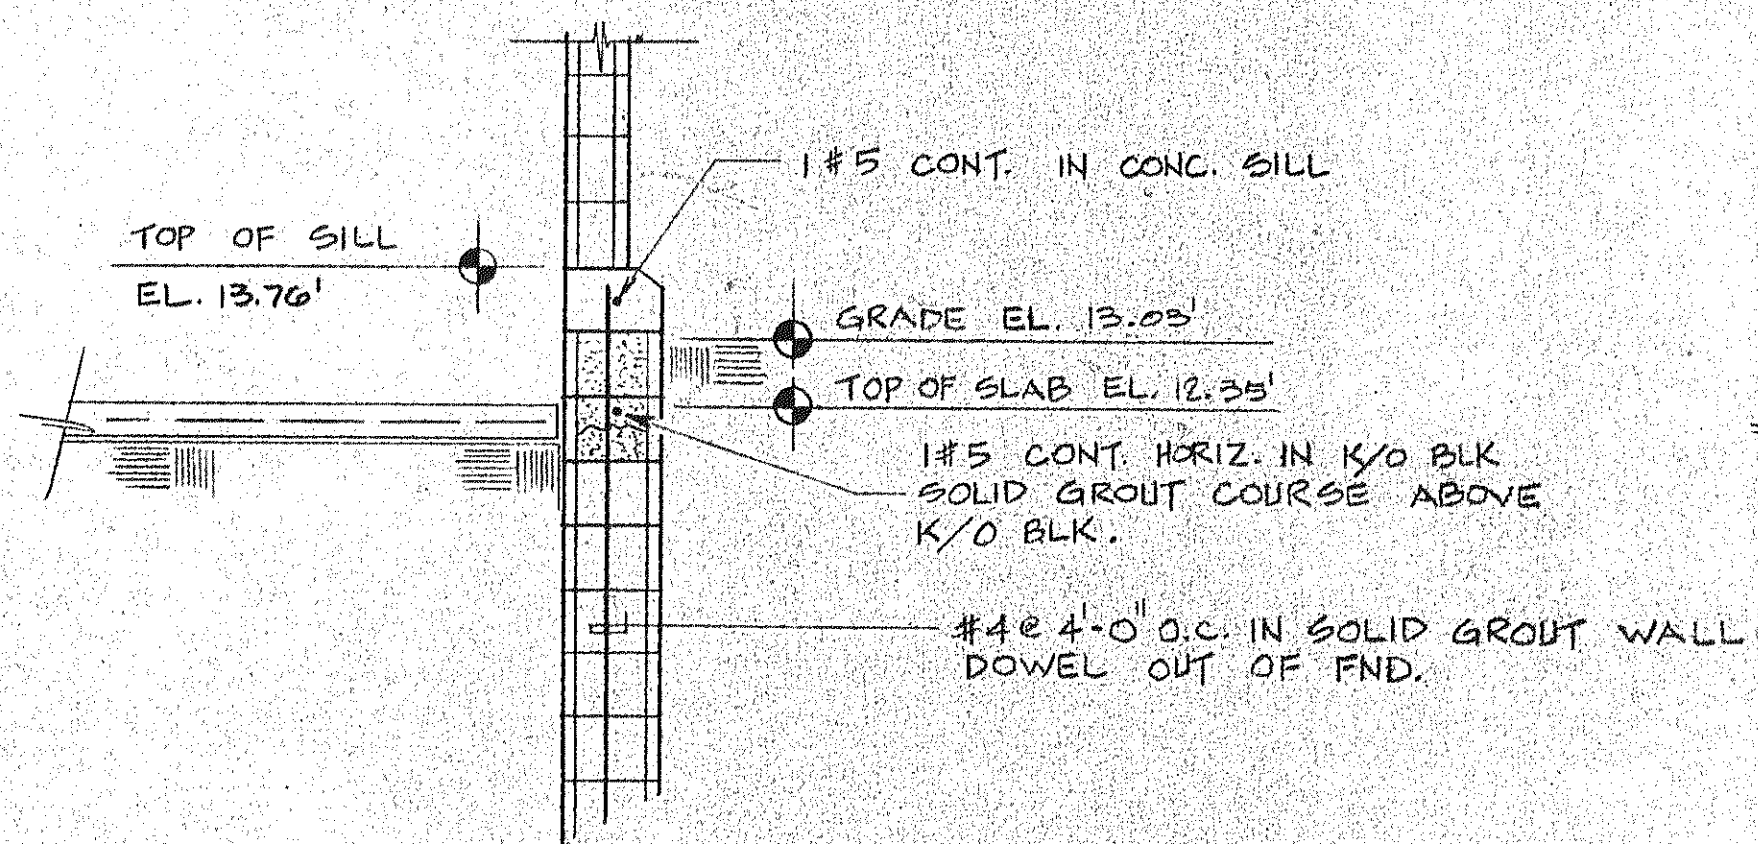


SECTION 4  
S5 1/2" = 1'-0"

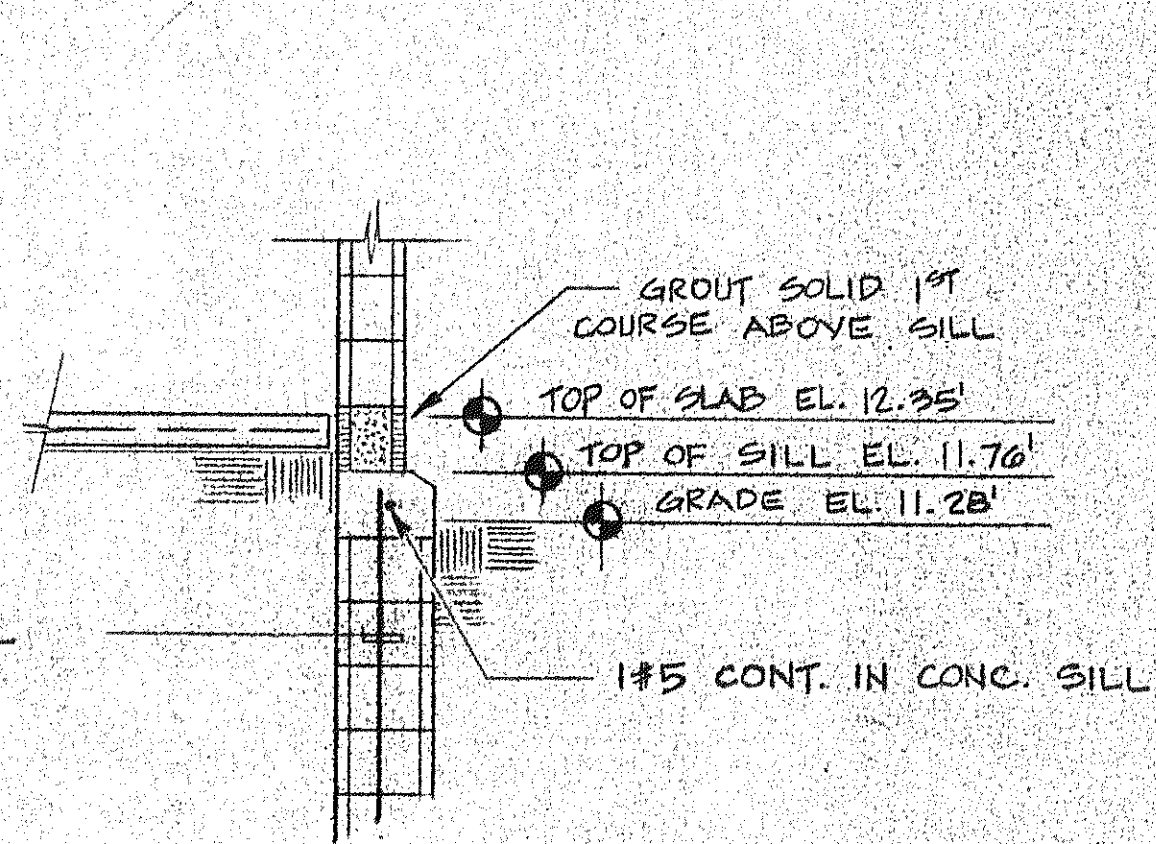


SECTION 5  
S5 1/2" = 1'-0"

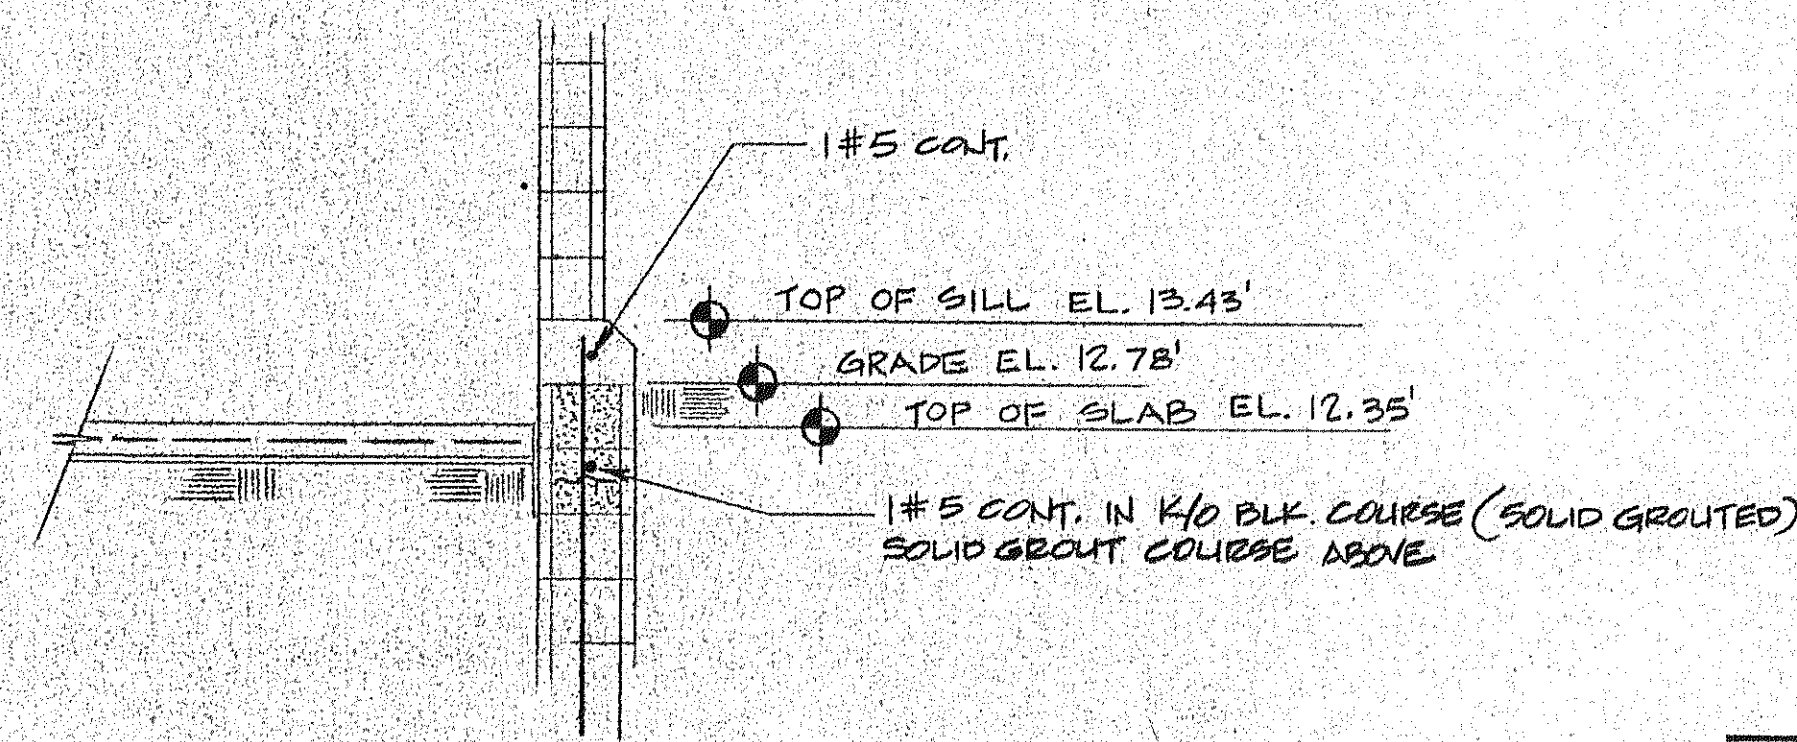

SECTION 6  
S5 1/2" = 1'-0"

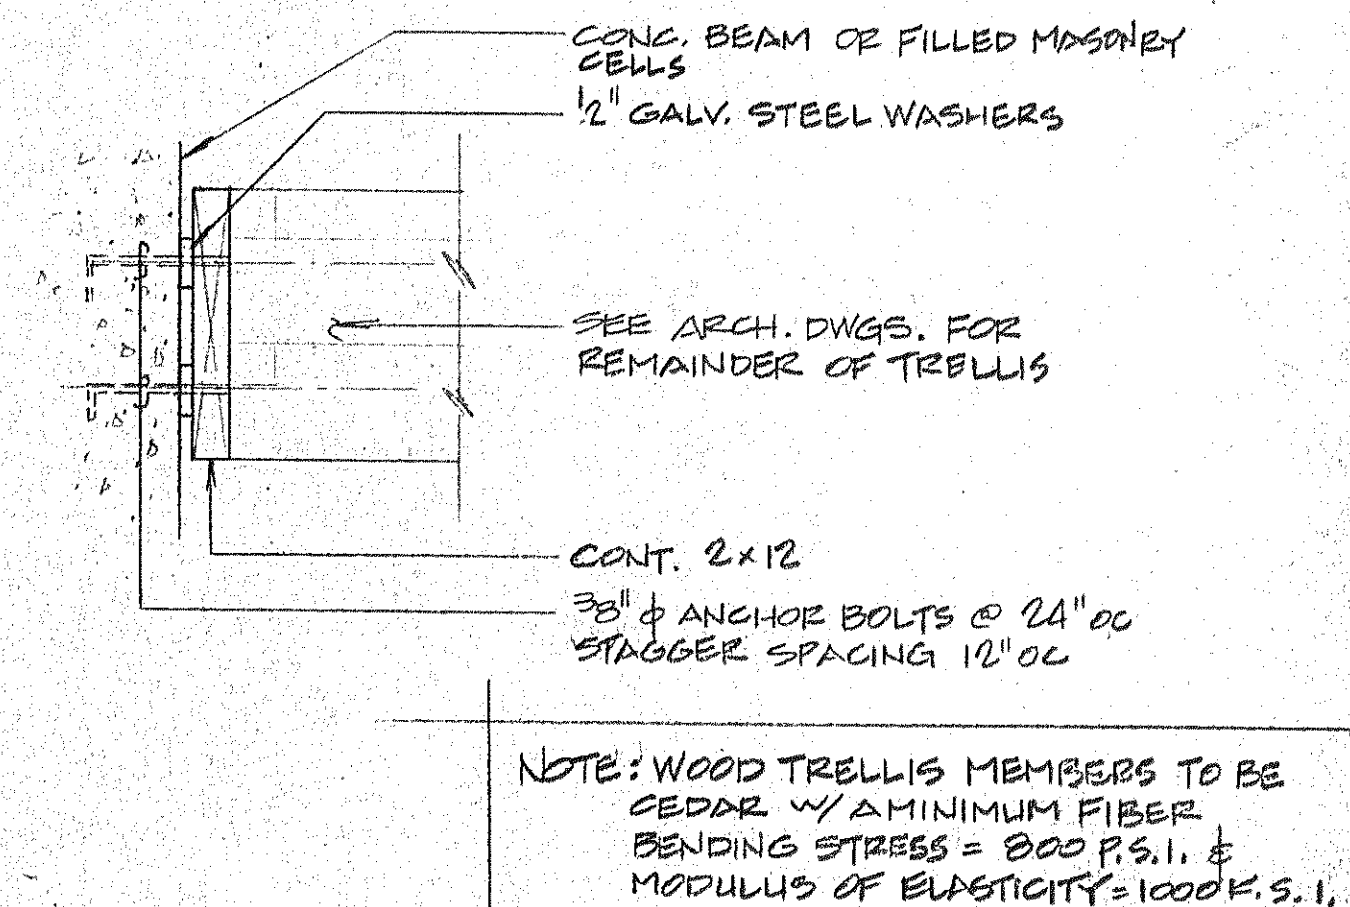

TYPICAL TRELLIS CONN. DETAIL  
NOT REMOVABLE

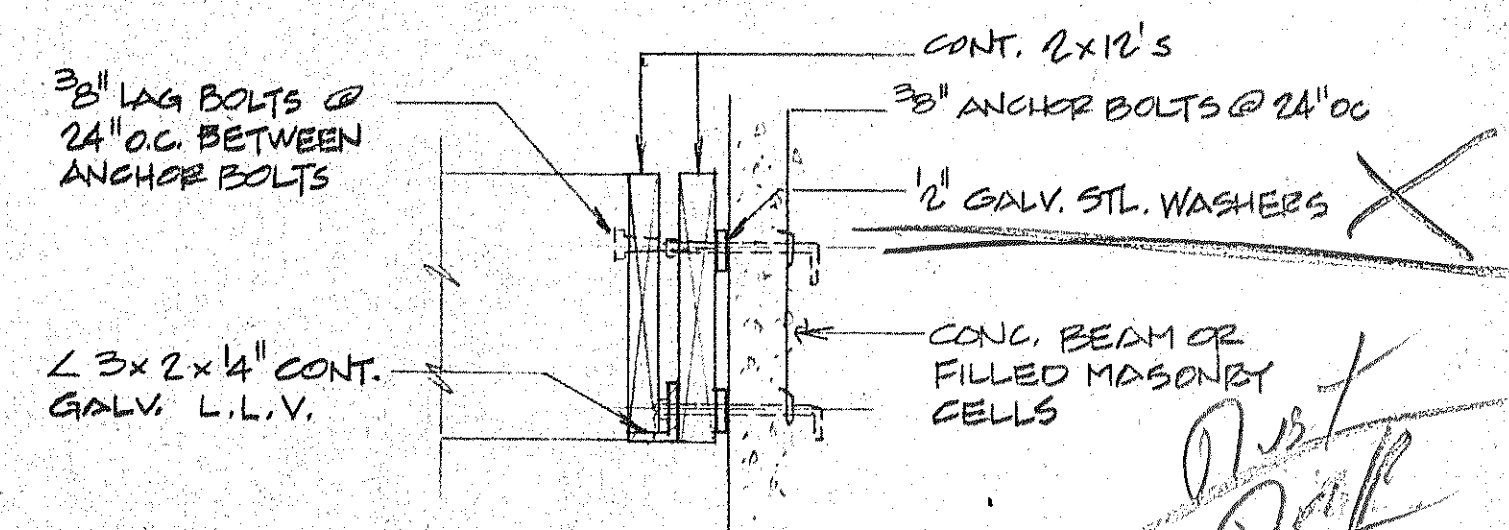

TYPICAL REMOVABLE TRELLIS  
CONNECTION DETAIL

SUNSET BEACH  
 THE SVA GROUP  
 EDWARD J. SEBERT, ARCHITECT & PLANNER, P.A.  
 BRABHAM, KUHN, DEBAY CONSULTING ENGINEERS  
 OLSEN, WHITE & ASSOCIATES STRUCTURAL ENGINEERS  
 BENNETT & BISHOP, INC. CONSULTING ENGINEERS & SURVEYORS  
 SECTIONS  
 ISSUED 12-10-82  
 REVISED 1-4-83  
 12-20-85  
 SHEET  
 S5  
 OF  
 22161