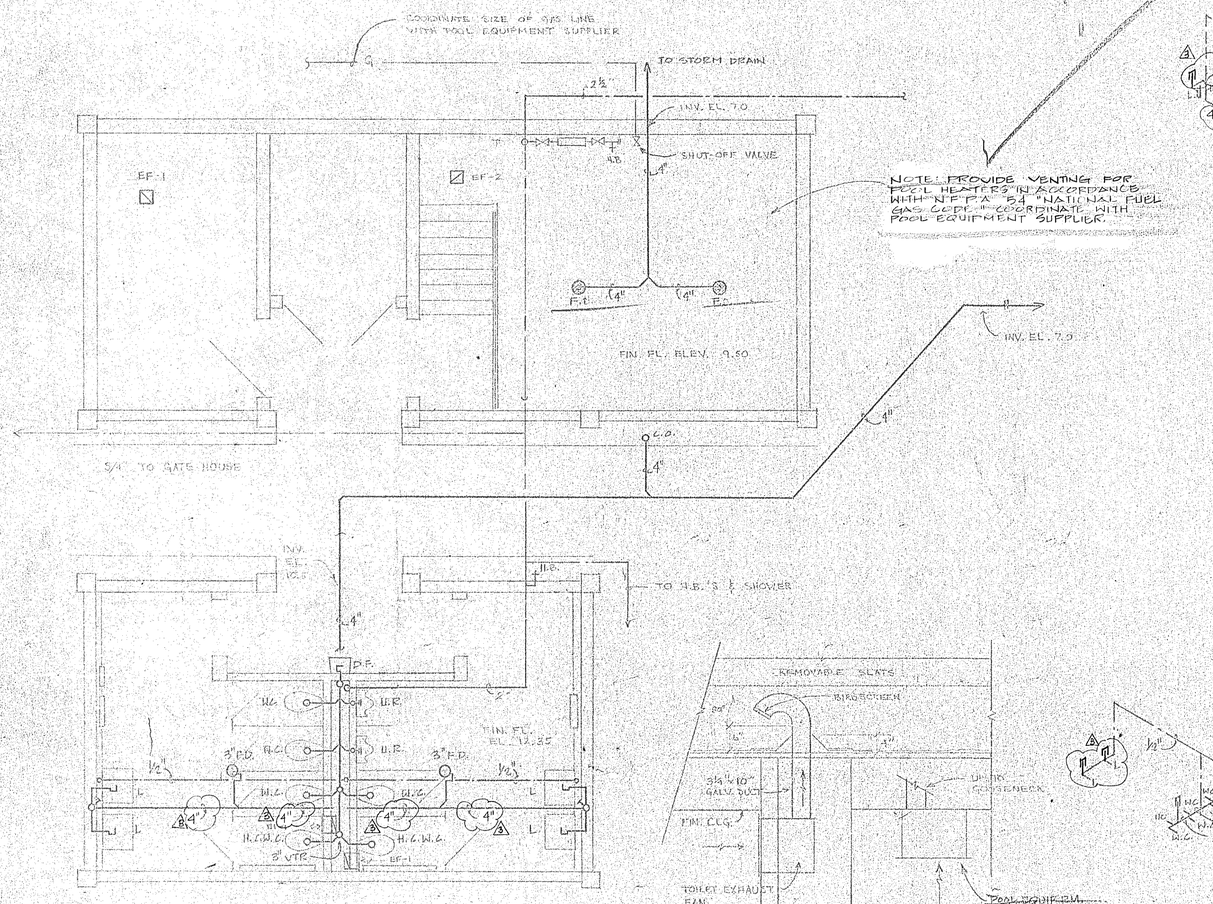

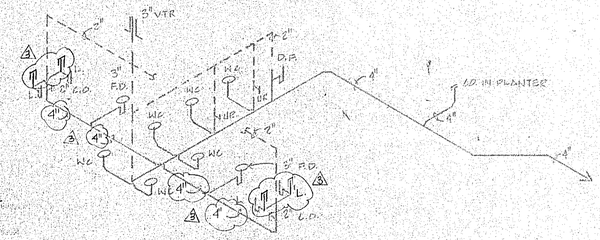

WASTE RISER DIAGRAM

n.t.s.

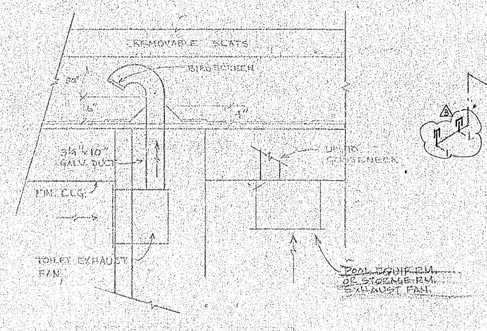

EXH. FAN DETAIL

n.t.s.

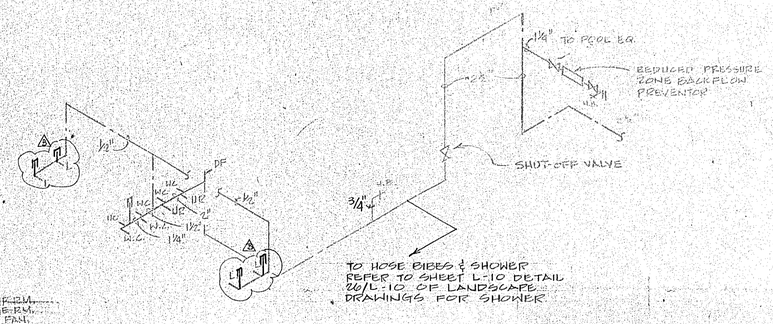

WATER RISER DIAGRAM

n.t.s.

AUXILIARY BUILDING

POOL TOILET ROOMS AND EQUIPMENT BUILDING – PLUMBING PLAN

scale 1/4" : 1'-0"

EXHAUST FANS SHALL BE:
EF-1 GREENHECK SP-27; 350 CFM @ 1/8" S.P.
EF-2 GREENHECK SP-60; 1000 CFM @ 1/8" S.P.

POOL BUILDING FIXTURE SCHEDULE

LAVATORY (L)	–	"AMERICAN STANDARD" DECLYN 0321.075 FAUCET 2103.886
WATER CLOSET (WC-1)	–	"AMERICAN STANDARD" MADERA 2221.018 FLUSH VALVE: SLOAN ROYAL 110 SEAT: CHURCH 5321.112
WATER CLOSET (WC-2) HANDICAP	–	"AMERICAN STANDARD" CADET 9468.018 FLUSH VALVE: SLOAN ROYAL 110
DRINKING FOUNTAIN (DF)	–	"AMERICAN STANDARD" SARATOGA 8310.112
URINAL (UR)	–	"AMERICAN STANDARD" LYNBROOK URINAL 5530.018 FLUSH VALVE: SLOAN ROYAL 180

JUL 21 1983

CONCEPT DEVELOPMENT PLAN
CONCEPTUAL PLAN
PRELIMINARY PLAN
FINAL PLAN
PRELIMINARY PLAT
FINAL PLAT
SITE PLAN
ISSUED
4-1-83
REVISED
8-19-83