

LIGHTING CONTROL DIAGRAM

FIXTURE SCHEDULE

TYPE	MANUFACTURER	CATALOG NO.	LAMPS	VOLTS	MOUNTING	REMARKS
5A	ALPHALUBB	5B2410	1-HI100E 2XFL20-4	208	CONCRETE BASE	
5B	ALPHALUBB	5B2411	1-HI100E 2XFL20-4	208	CONCRETE BASE	
5C	KIM	1-HI100E 2XFL20-4	1-HI100E 2XFL20-4	208	14" HINGED POLE	
5D	POBLESS	1-HI100E 2XFL20-4	1-HI100E 2XFL20-4	120	12" POLE	FIXED FIXTURES PER POLE
5E	KIM	5507 HV	1-HI100E 43	208	FLUSH WITH FINISH GRADE	
5F	KIM HUBBELL	5520 MY 5520 S100C 152	1-HI100E 43	208	FLUSH WITH FINISH GRADE	
5G	LANARDE HARRIS	5000 W/1501 2000 S.C.P.	1-60AH	120	BOTTOM OF HANDRAIL	
5H	LITHONIA SILKAR	DL 240 A 1F 240 L4	2-F40CW	120	SURFACE	
5I	LANTORNY LIGHTOWER	1500/1241 1202/1241	1-150AZ1	120	SEMI- RECESSED	
5J	LANTORNY LIGHTOWER	1500/1241 1202/1241	1-150AZ1	120	SURFACE-WALL	SATIN CHROME FINISH
5K	RESOLITE LIGHTOWER	1533A 1533	1-150B20	120	SURFACE-WALL	MATE WHITE FINISH

* CO-ORDINATE ACTUAL FINISHES WITH ARCHITECT.

PANEL BOARD SCHEDULE 'P'

bus amps			LOAD	poles	amps	bus amps			LOAD	bus amps		
A	B	C				A	B	C		A	B	C
2	4	4	LTA PARKING	2	20	1	2	2	MIG. LANDSCAPE	6	6	6
4	4	4	LANDSCAPE	2	20	5	8	8		4	4	4
4	6	6		2	20	9	10	10		6	6	6

Rated voltage: 120/208 277/480V 3phase, 4 wire

Rated amps: 100 225 400

Branch poles: 12 20 30 42

Cabinet: Surface Flush

Full neutral bus Ground bus Hinged door Keyed door latch

Fused Circuit breaker (bolt-in) branch devices

Feed is to be bottom top

Main lugs only Main amp breaker fused switch 25, 27, 29, 31 to be GFI breakers

All breakers must be rated to interrupt a short circuit I_{sc} of 10,000 amps symmetrical

PANEL BOARD SCHEDULE 'PA'

bus amps			LOAD	poles	amps	bus amps			LOAD	bus amps		
A	B	C				A	B	C		A	B	C
3			RECEPTACLE	1	20	1	2	2				
			POOL LIGHTS	1	20	3	4	4				
			CEILING			5	6	6				
						7	8	8				
						9	10	10				
						11	12	12				
						13	14	14				
						15	16	16				
						17	18	18				
						19	20	20				
						21	22	22				
						23	24	24				
						25	26	26				
						27	28	28				
						29	30	30				
						31	32	32				
						33	34	34				
						35	36	36				
						37	38	38				
						39	40	40				
						41	42	42				

Rated voltage: 120/208 277/480V 3phase, 4 wire

Rated amps: 100 225 400

Branch poles: 12 20 30 42

Cabinet: Surface Flush

Full neutral bus Ground bus Hinged door Keyed door latch


Fused Circuit breaker (bolt-in) branch devices

Feed is to be bottom top


Main lugs only Main amp breaker fused switch to be GFI breakers

All breakers must be rated to interrupt a short circuit I_{sc} of 10,000 amps symmetrical

- #### GENERAL ELECTRICAL NOTES:
- ALL ELECTRICAL WORK SHALL COMPLY WITH THE NATIONAL ELECTRICAL CODE, THE STANDARD BUILDING CODE, THE NATIONAL FIRE CODES AND ALL APPLICABLE LOCAL CODES AND ORDINANCES.
 - THE CONTRACTOR SHALL THOROUGHLY REVIEW THE PROJECT TO ENSURE THAT ALL WORK SHALL MEET OR EXCEED THE ABOVE REQUIREMENTS. ANY ALLEGED DISCREPANCIES SHALL BE BROUGHT TO THE ENGINEER'S ATTENTION PRIOR TO BID.
 - THE CONTRACTOR IS DIRECTED TO OBTAIN COPIES OF ALL RELATED PLANS, SPECIFICATIONS, SHOP DRAWINGS AND ADDENDUMS TO COORDINATE THE RELATED WORK AND SCHEDULING.
 - THE CONTRACTOR IS REMINDED THAT ELECTRICAL SERVICE TO AND FOR MECHANICAL AND OTHER EQUIPMENT ARE BASED ON EQUIPMENT DESIGN DATA. THE VALUES MAY DIFFER DEPENDING UPON THE ACTUAL EQUIPMENT TO BE FURNISHED; ANY MODIFICATION TO THE ELECTRICAL, BASED UPON ACTUAL EQUIPMENT SELECTION, SHALL RESULT IN NO ADDITIONAL COST TO THE OWNER.
 - MECHANICAL AND ELECTRICAL EQUIPMENT HAVE BEEN LOCATED AND ARRANGED TO MINIMIZE THE INTERFERENCES OF EQUIPMENT AND STRUCTURE. THE CONTRACTOR SHALL THOROUGHLY FAMILIARIZE HIMSELF WITH THE WORK TO BE PERFORMED BY OTHER TRADES AND THE PHYSICAL CHARACTERISTICS OF THE STRUCTURE IN ORDER TO SCHEDULE AND INSTALL EQUIPMENT AND TO MINIMIZE POSSIBLE INTERFERENCE. FAILURE TO PROPERLY COMMUNICATE AND SCHEDULE WORK WITH OTHER TRADES RESULTING IN ADDITIONAL WORK AND MATERIAL, SHALL BE THE RESPONSIBILITY OF THE CONTRACTOR. THE MODIFICATIONS REQUIRED TO RESOLVE THE CONFLICT SHALL BE DECIDED BY THE ENGINEER.
 - PRELIMINARY COORDINATION HAS BEEN STARTED WITH THE LOCAL POWER COMPANY. THE RESULTING UTILITY REQUIREMENTS ARE INDICATED ON THE PLANS; THE CONTRACTOR IS DIRECTED TO OBTAIN FINAL UTILITY REQUIREMENTS AND/OR SPECIFICATIONS AND INCLUDE ALL COST AND CHARGES IN HIS BID.
 - ALL CONDUIT TURN-UPS SHALL BE MADE WITH RIGID GALVANIZED CONDUIT COATED WITH RUST INHIBITOR.
 - MINIMUM TRADE SIZE CONDUIT PERMITTED SHALL BE 3/4 INCH UNLESS NOTED OTHERWISE.
 - ALL CONDUITS SHALL HAVE A SEPARATE GREEN GROUND CONDUCTOR INSTALLED FOR GROUNDING.
 - ALL CONDUITS SHALL BE CONNECTED BY MEANS OF COMPRESSION TYPE CONNECTIONS; NO SET SCREW TYPE FITTINGS SHALL BE PERMITTED.
 - THE PLANS INDICATE THE DESIRED ARRANGEMENT AND GENERAL LOCATIONS OF THE LIGHT FIXTURES. THE ARCHITECTURAL PLANS INDICATE ADDITIONAL DATA AS TO THE FINAL FIXTURE PLACEMENT.
 - THE CONTRACTOR SHALL FURNISH THE CEILING CONTRACTOR COPIES OF APPROVED LIGHT FIXTURE SHOP DRAWINGS.
 - ALL CONDUCTOR METAL SHALL BE COPPER WITH 600 VOLT INSULATION TYPE THN, THHN/THWN, OR THW/THWN/THWN. (MINIMUM SIZE SHALL BE #12AWG.)
 - ALL CONDUIT RUNS SHALL BE CONCEALED UNLESS SPECIFICALLY NOTED OTHERWISE.
 - ALL LIGHT SWITCHES AND DUPLEX RECEPTACLES SHALL BE RATED FOR 20 AMPERE AT 125 VOLTS A/C. WIRING DEVICES SHALL BE MANUFACTURED BY HUBBELL OR APPROVED EQUAL.
 - ALL DISCONNECT SWITCHES SHALL BE THE HEAVY DUTY TYPE WITH BUSSMAN TIME DELAY, DUAL ELEMENT, AND CURRENT LIMITING FUSES.
 - THE CONTRACTOR IS DIRECTED TO VERIFY ALL CEILING MEDIA AND LIGHT FIXTURE FRAMING AND MOUNTINGS PRIOR TO SHOP DRAWING SUBMITTALS. ANY DEVIATION NECESSARY FROM CONTRACT DRAWINGS SHALL BE INDICATED ON SAID SHOP DRAWING SUBMITTAL FOR APPROVAL BY ENGINEER.
 - ALL ELECTRICAL WIRING DEVICES INDICATED TO BE INSTALLED IN WALLS OR FLOORS SHALL BE FLUSH MOUNTED. THE CONDUITS TO ASSOCIATED ELECTRICAL EQUIPMENT SHALL BE CONCEALED IN WALLS OR FLOOR.

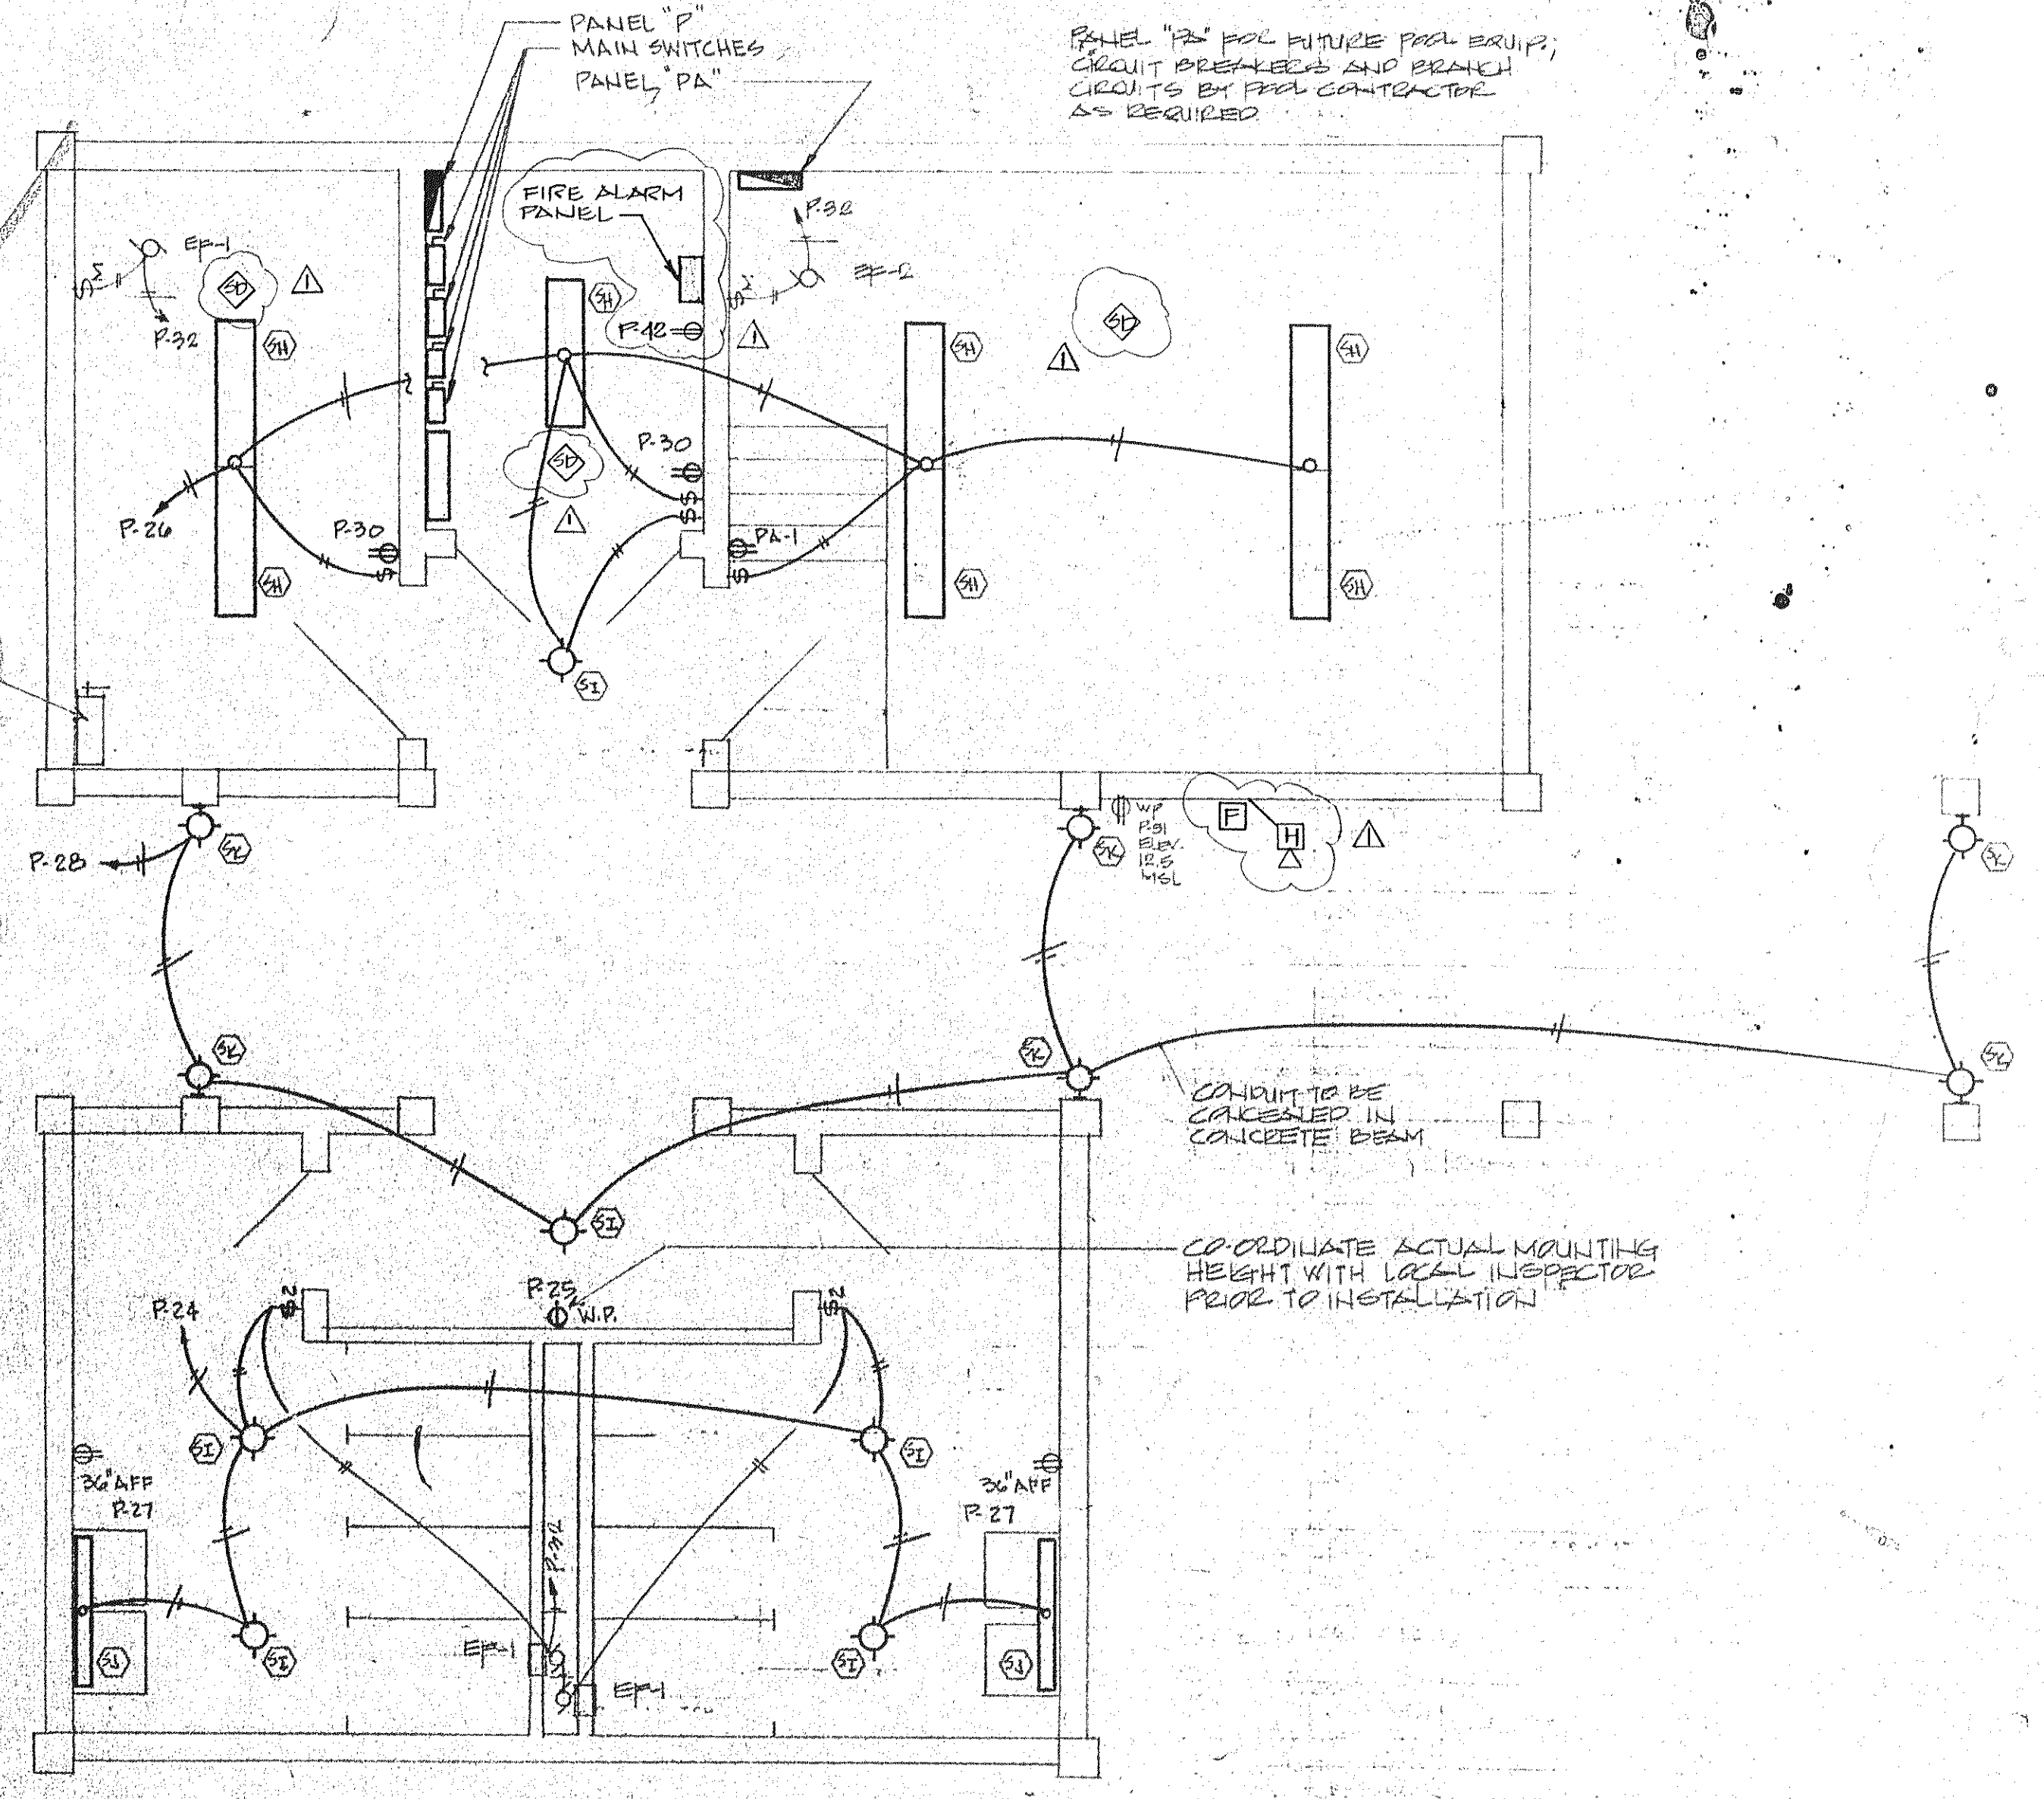

POOL HOUSE ELECTRICAL PLAN
scale 1/4" = 1'-0"

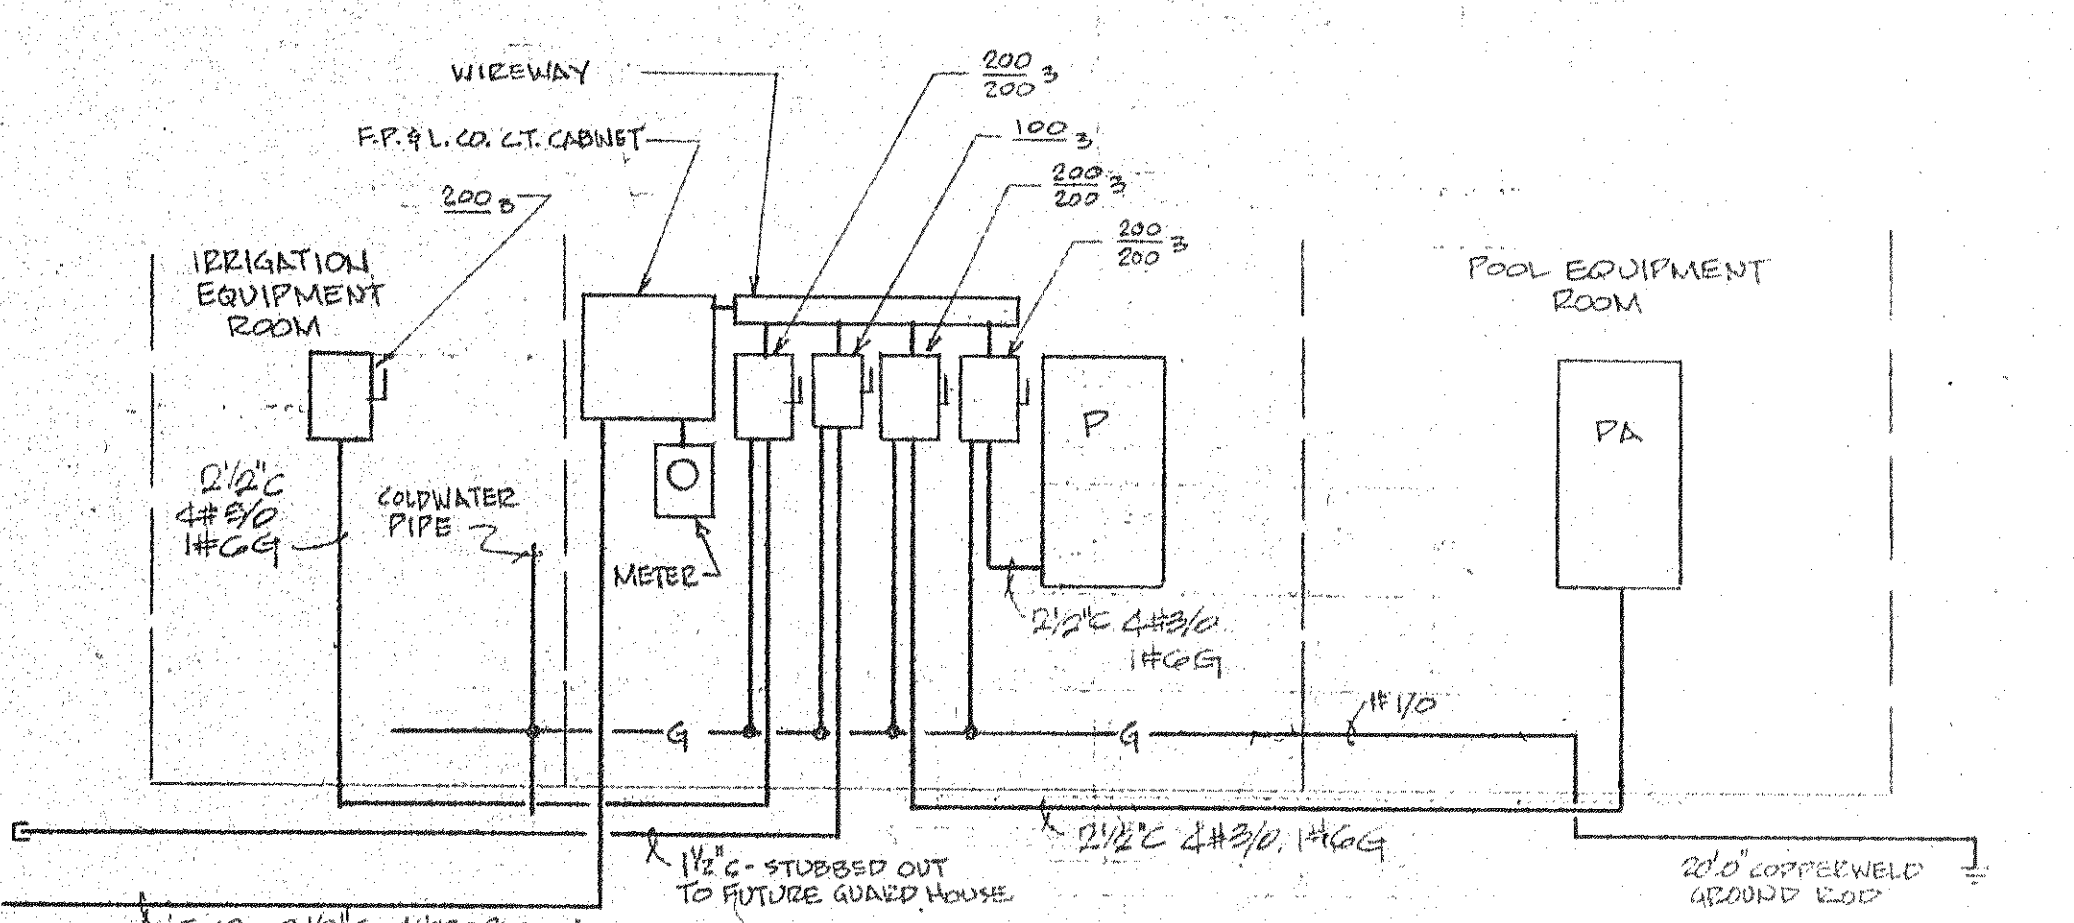

ELECTRICAL RISER DIAGRAM
n.t.s.

 ARVIDA CORPORATION · EDWARD J. SIBERT, P.E., ARCHITECT & PLANNER, P.A. · THE SWA GROUP
 BRADHAM KUHNS DESAY CONSULTING ENGINEERS · OLSEN WHITE & ASSOCIATES STRUCTURAL ENGINEERS · BENNETT & BIR

ISSUED	4-1-83
REVISED	
APPENDIX	6-23-83
SHEET	
OF	