


OVERLAYS
2
3
COMPOSITE

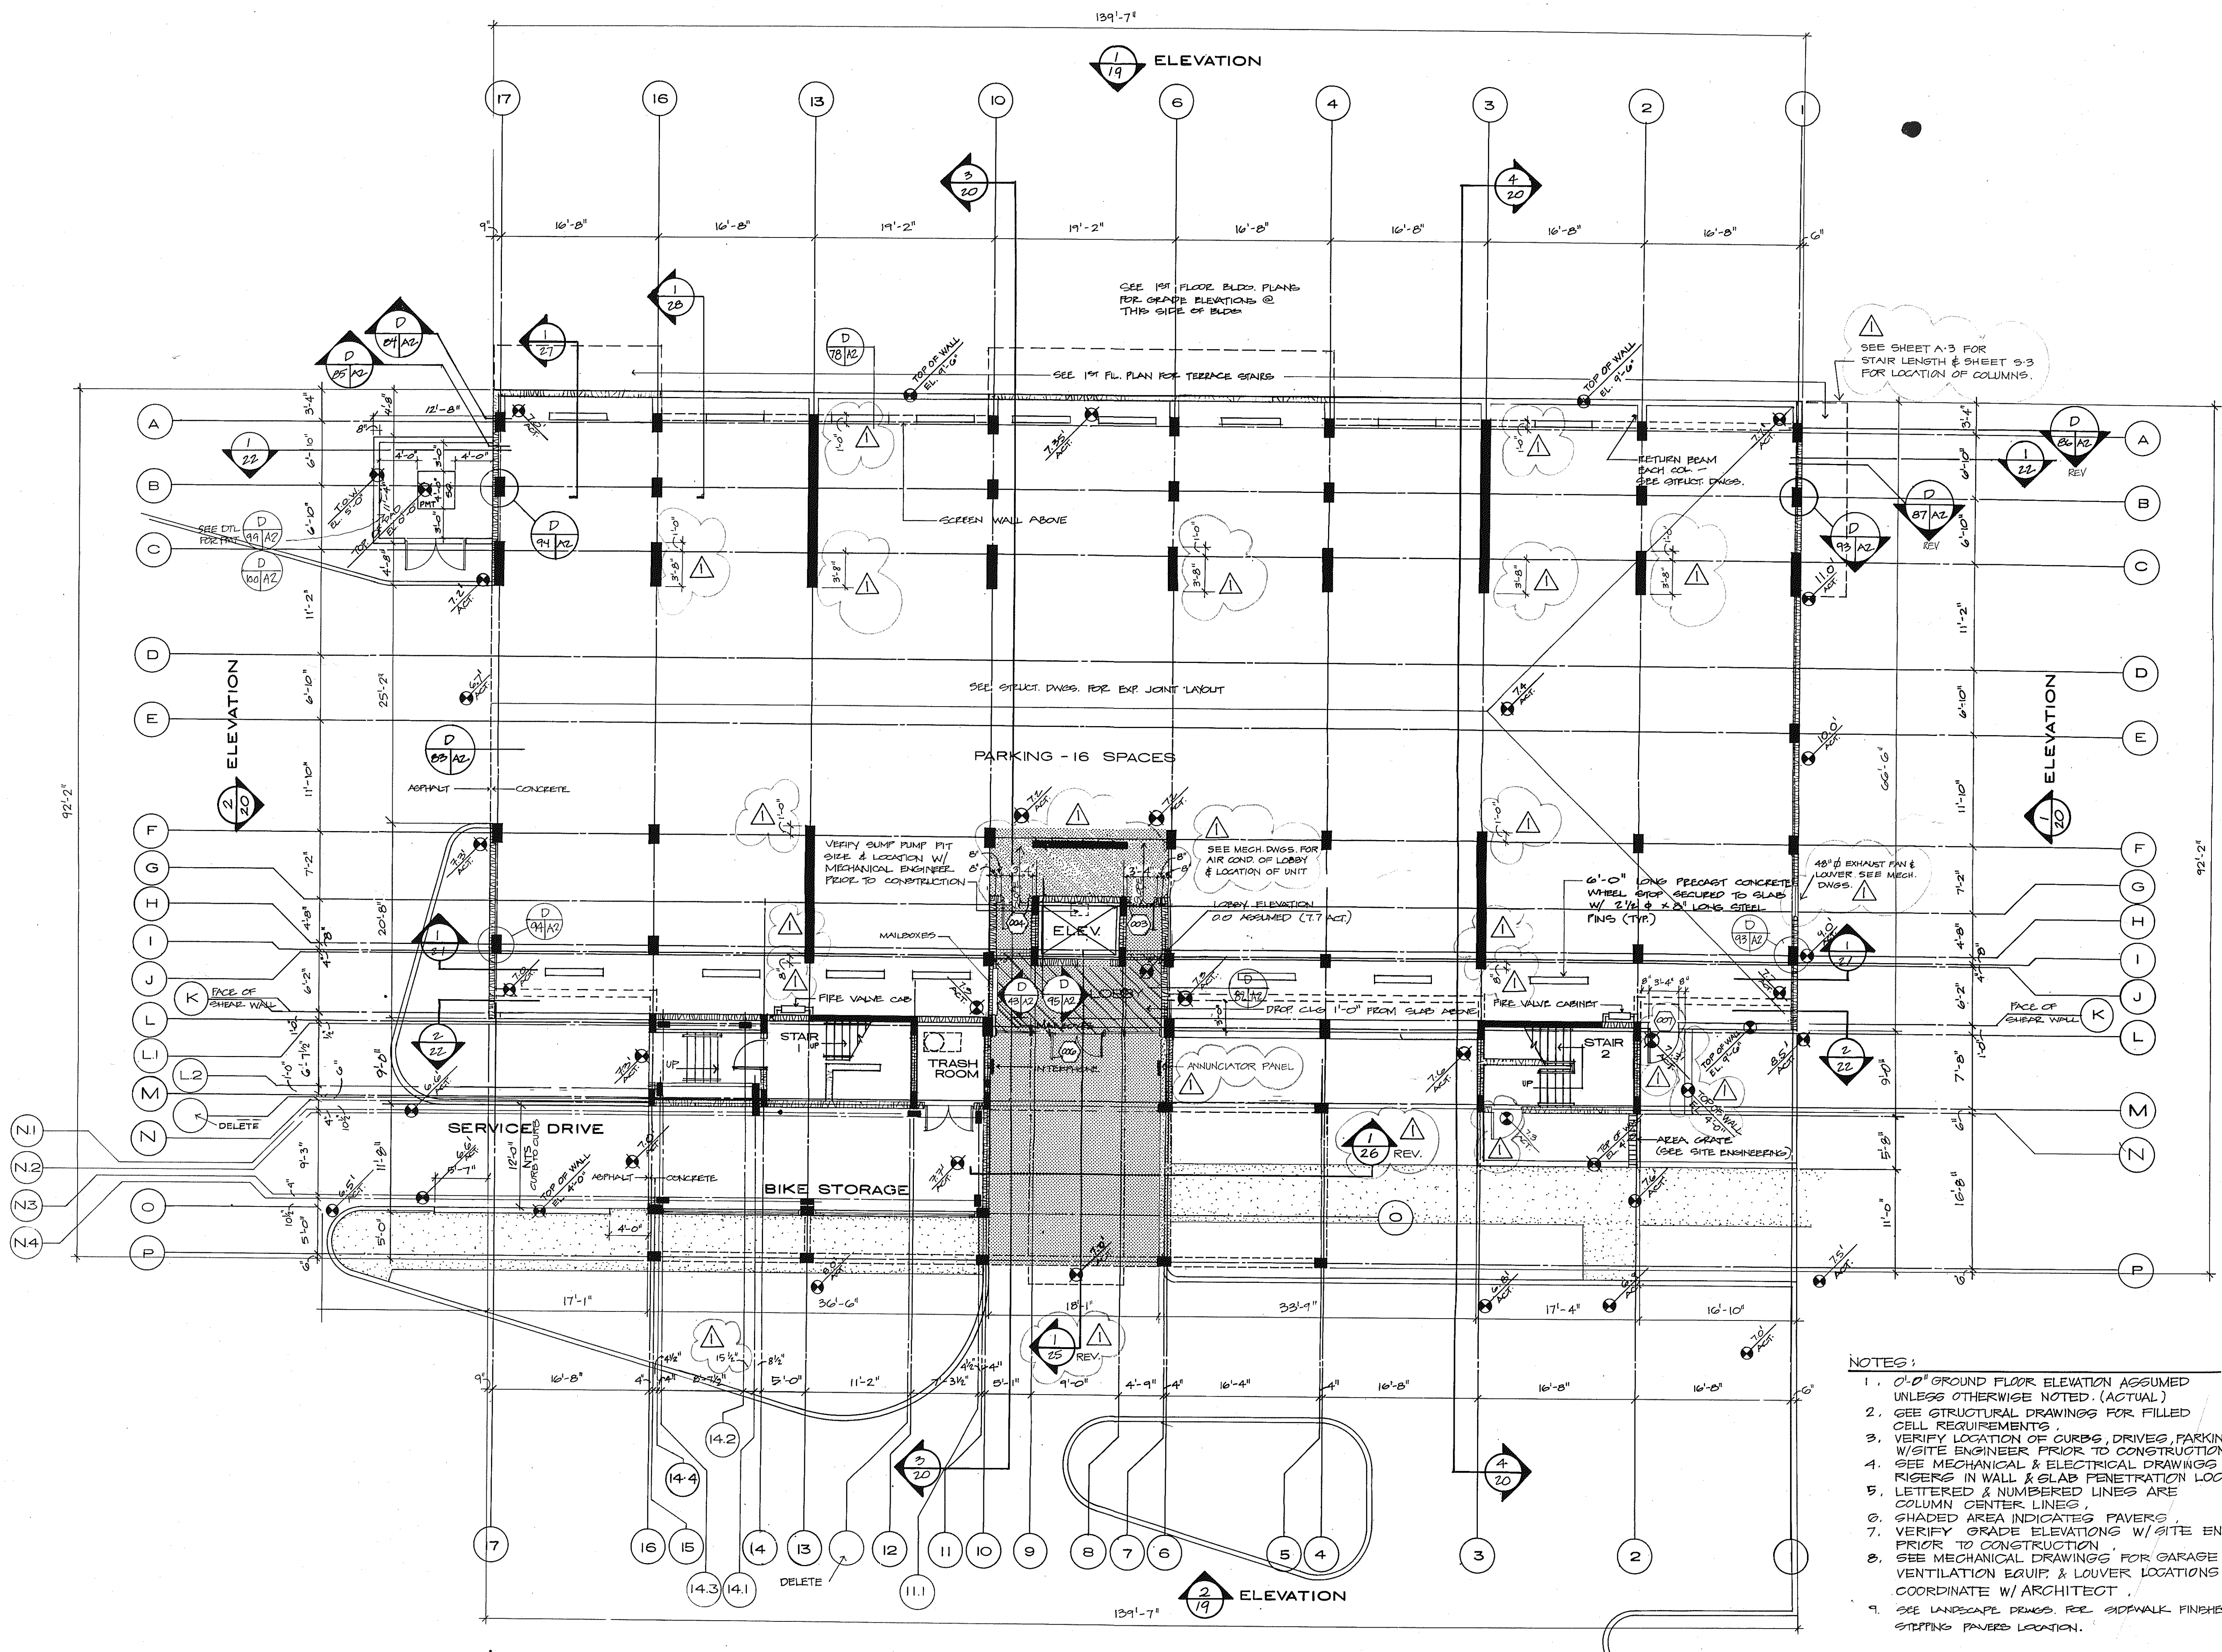

- NOTES:**
1. 0'-0" GROUND FLOOR ELEVATION ASSUMED UNLESS OTHERWISE NOTED. (ACTUAL)
 2. SEE STRUCTURAL DRAWINGS FOR FILLED CELL REQUIREMENTS.
 3. VERIFY LOCATION OF CURBS, DRIVES, PARKING, ETC... W/SITE ENGINEER PRIOR TO CONSTRUCTION.
 4. SEE MECHANICAL & ELECTRICAL DRAWINGS FOR RISERS IN WALL & SLAB PENETRATION LOCATIONS.
 5. LETTERED & NUMBERED LINES ARE COLUMN CENTER LINES.
 6. SHADED AREA INDICATES PAVERS.
 7. VERIFY GRADE ELEVATIONS W/SITE ENGINEER PRIOR TO CONSTRUCTION.
 8. SEE MECHANICAL DRAWINGS FOR GARAGE VENTILATION EQUIP. & LOUVER LOCATIONS. COORDINATE W/ ARCHITECT.
 9. SEE LANDSCAPE DRWS. FOR SIDEWALK FINISHES & STRIPPING PAVERS LOCATION.

SUNSET BEACH
 OF LONG BEACH KEY
 CONSULTING ENGINEERS & SURVEYORS

BUILDING 2 GROUND FLOOR PLAN 1/8" = 1'-0"
 ARVDA CORPORATION · EDWARD J SEIBERT AIA ARCHITECT & PLANNER PA · THE SWA GROUP
 BRABHAM KUHNIS DEBAY CONSULTING ENGINEERS · OLSEN WHITE & ASSOCIATES STRUCTURAL ENGINEERS · BENNETT & BISHOP INC CONSULTING ENGINEERS & SURVEYORS

ISSUED
10 DEC. 82
REVISED
4-1-83
SHEET
A-2
OF 37