

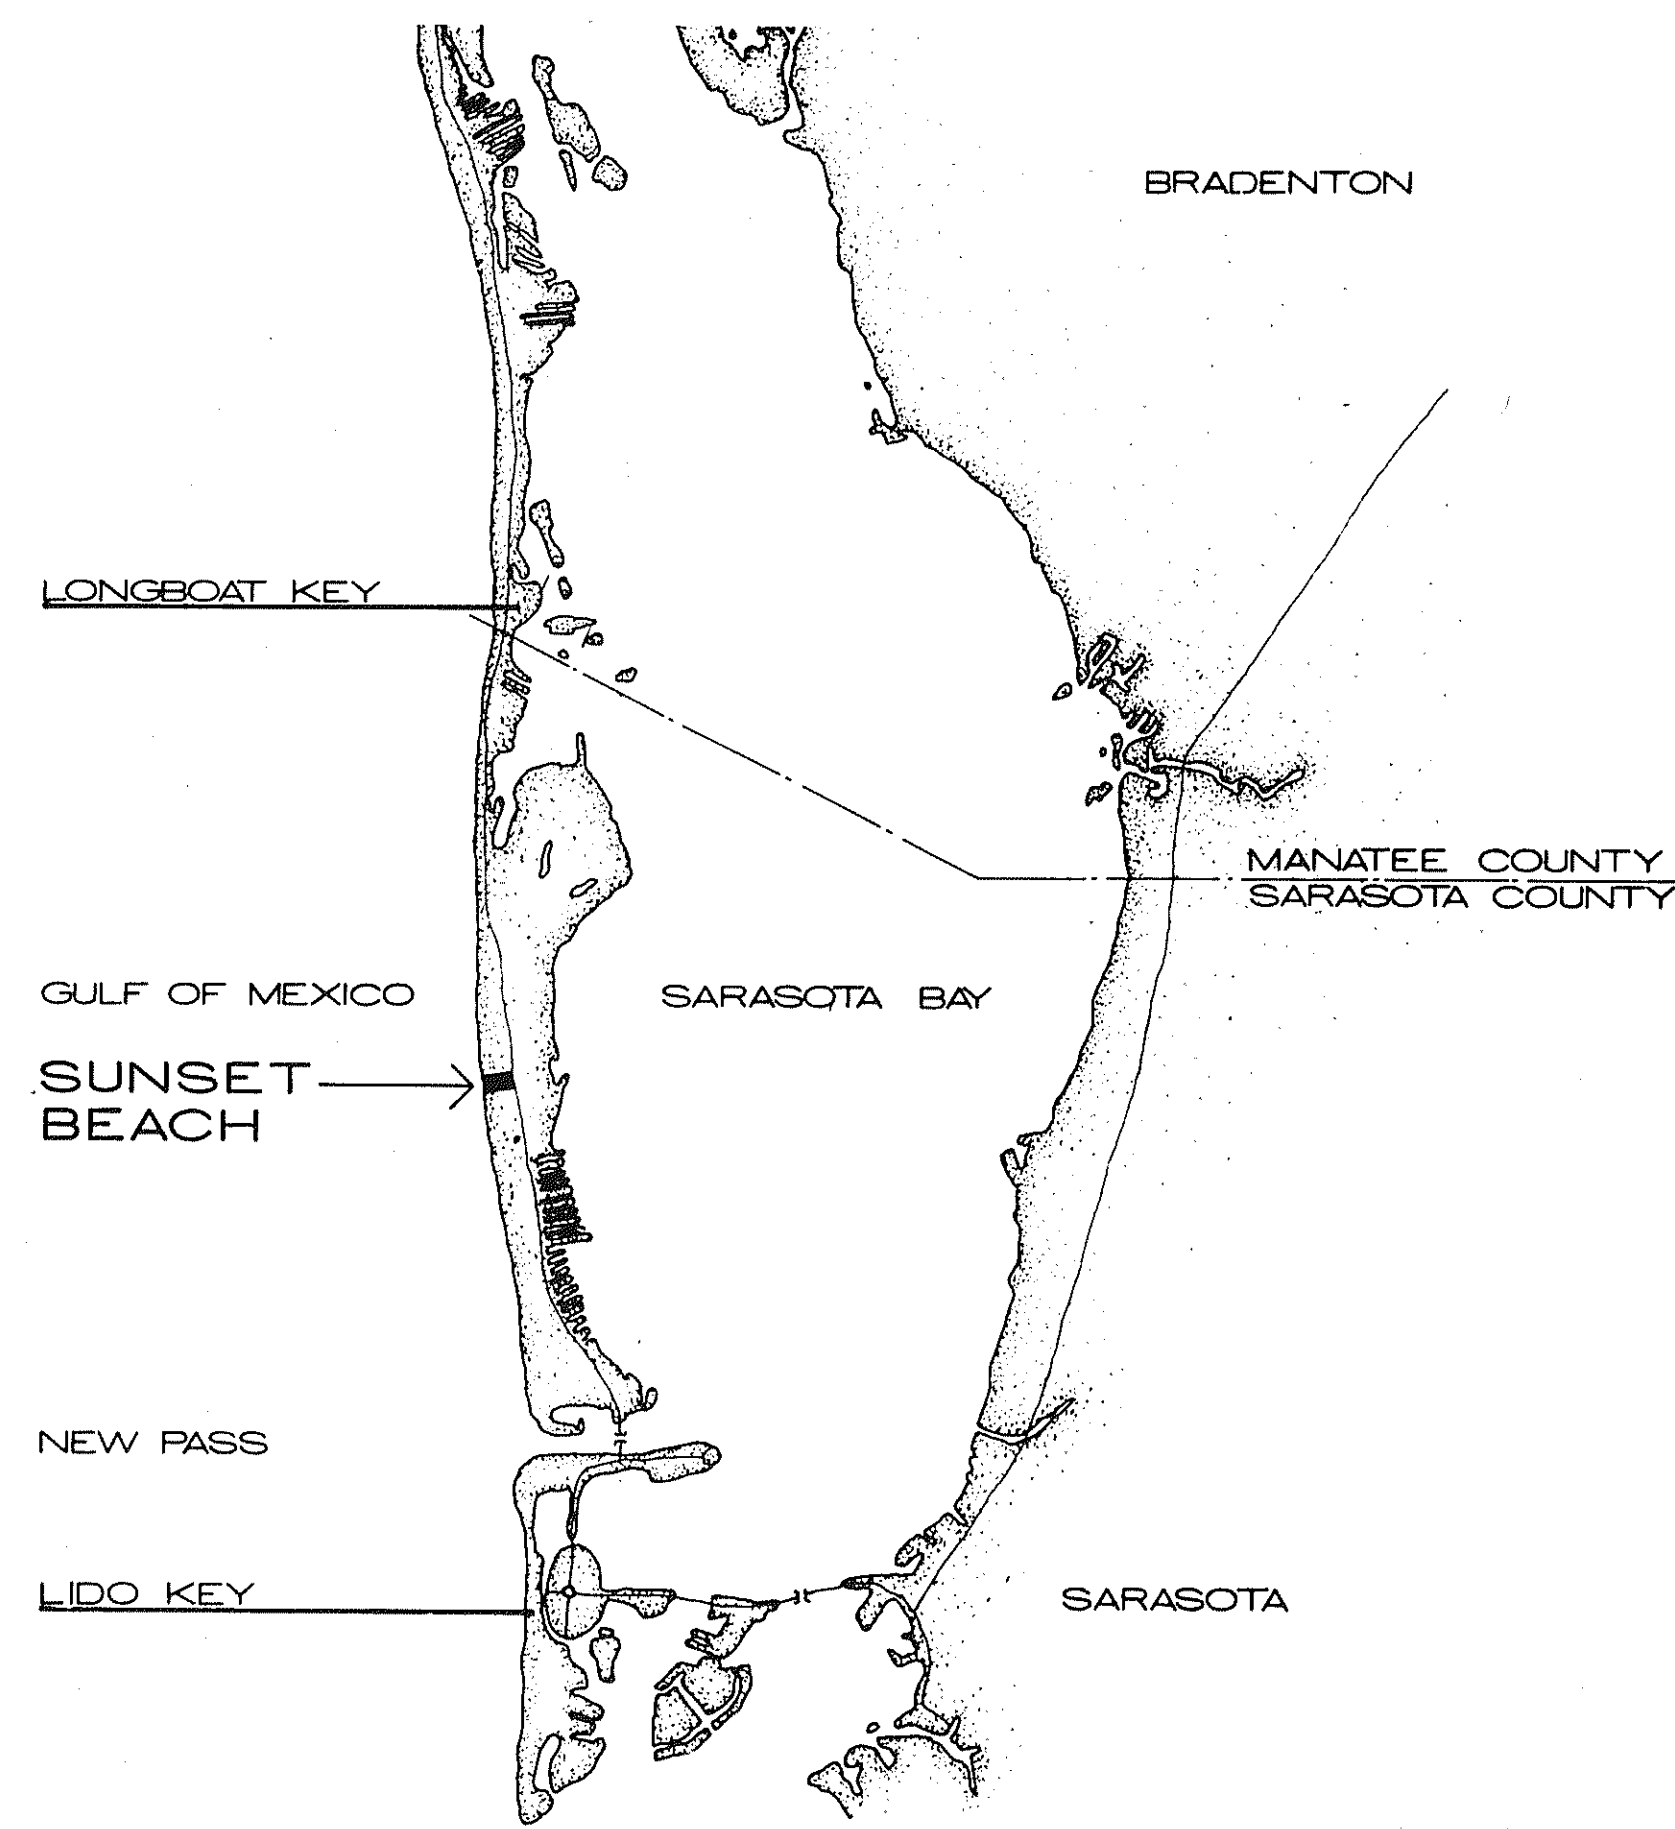


OVERLAYS
COMPOSITE

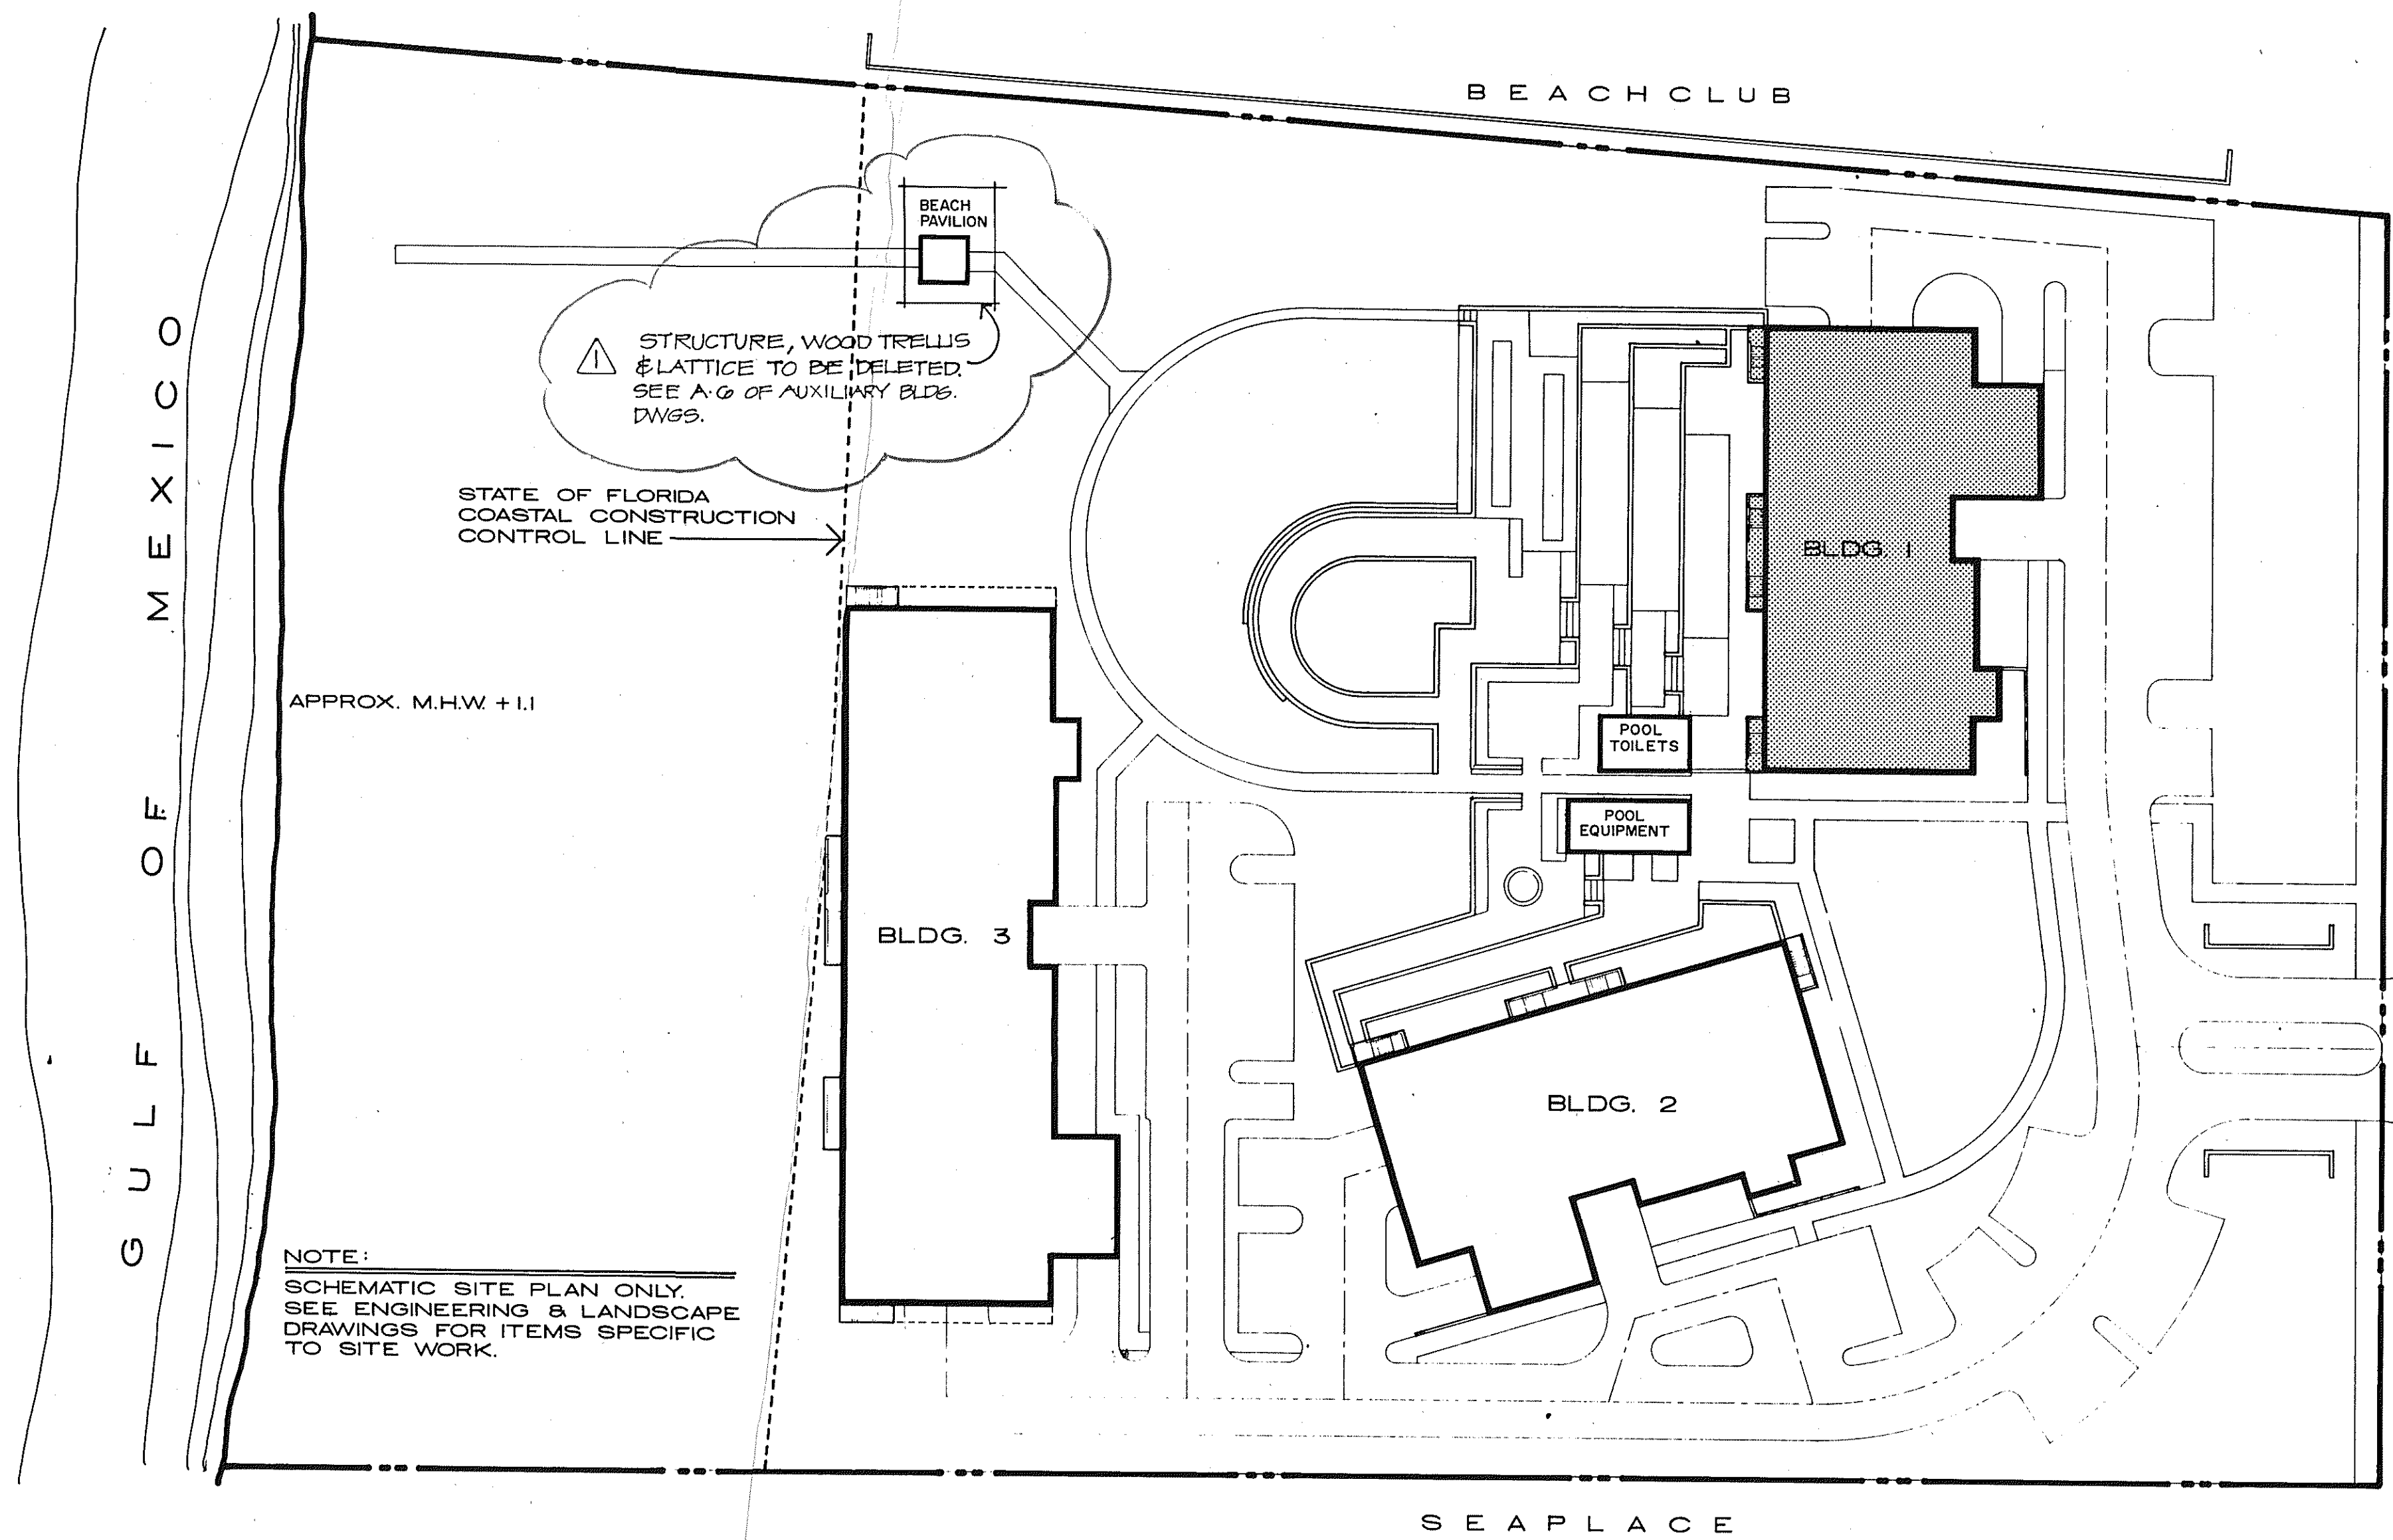


LOCATION MAP

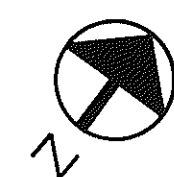

SITE PLAN

1" = 40'

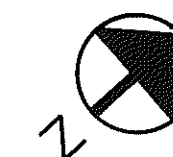

SUNSET BEACH
OF LONGBOAT KEY

BUILDING 1 LOCATION MAP & SITE PLAN 1" = 40'
ARVIDA CORPORATION · EDWARD J. SEIBERT AIA ARCHITECT & PLANNER PA THE SWA GROUP
BRABHAM KUHNIS DEBBY CONSULTING ENGINEERS OLSEN WHITE & ASSOCIATES STRUCTURAL ENGINEERS · BENNETT & BISHOP INC CONSULTING ENGINEERS & SURVEYORS

ISSUED
10 DEC. 02

REVISED
4-1-03

SHEET

A-1

OF 37