


OVERLAYS	1
COMPOSITE	2
	3

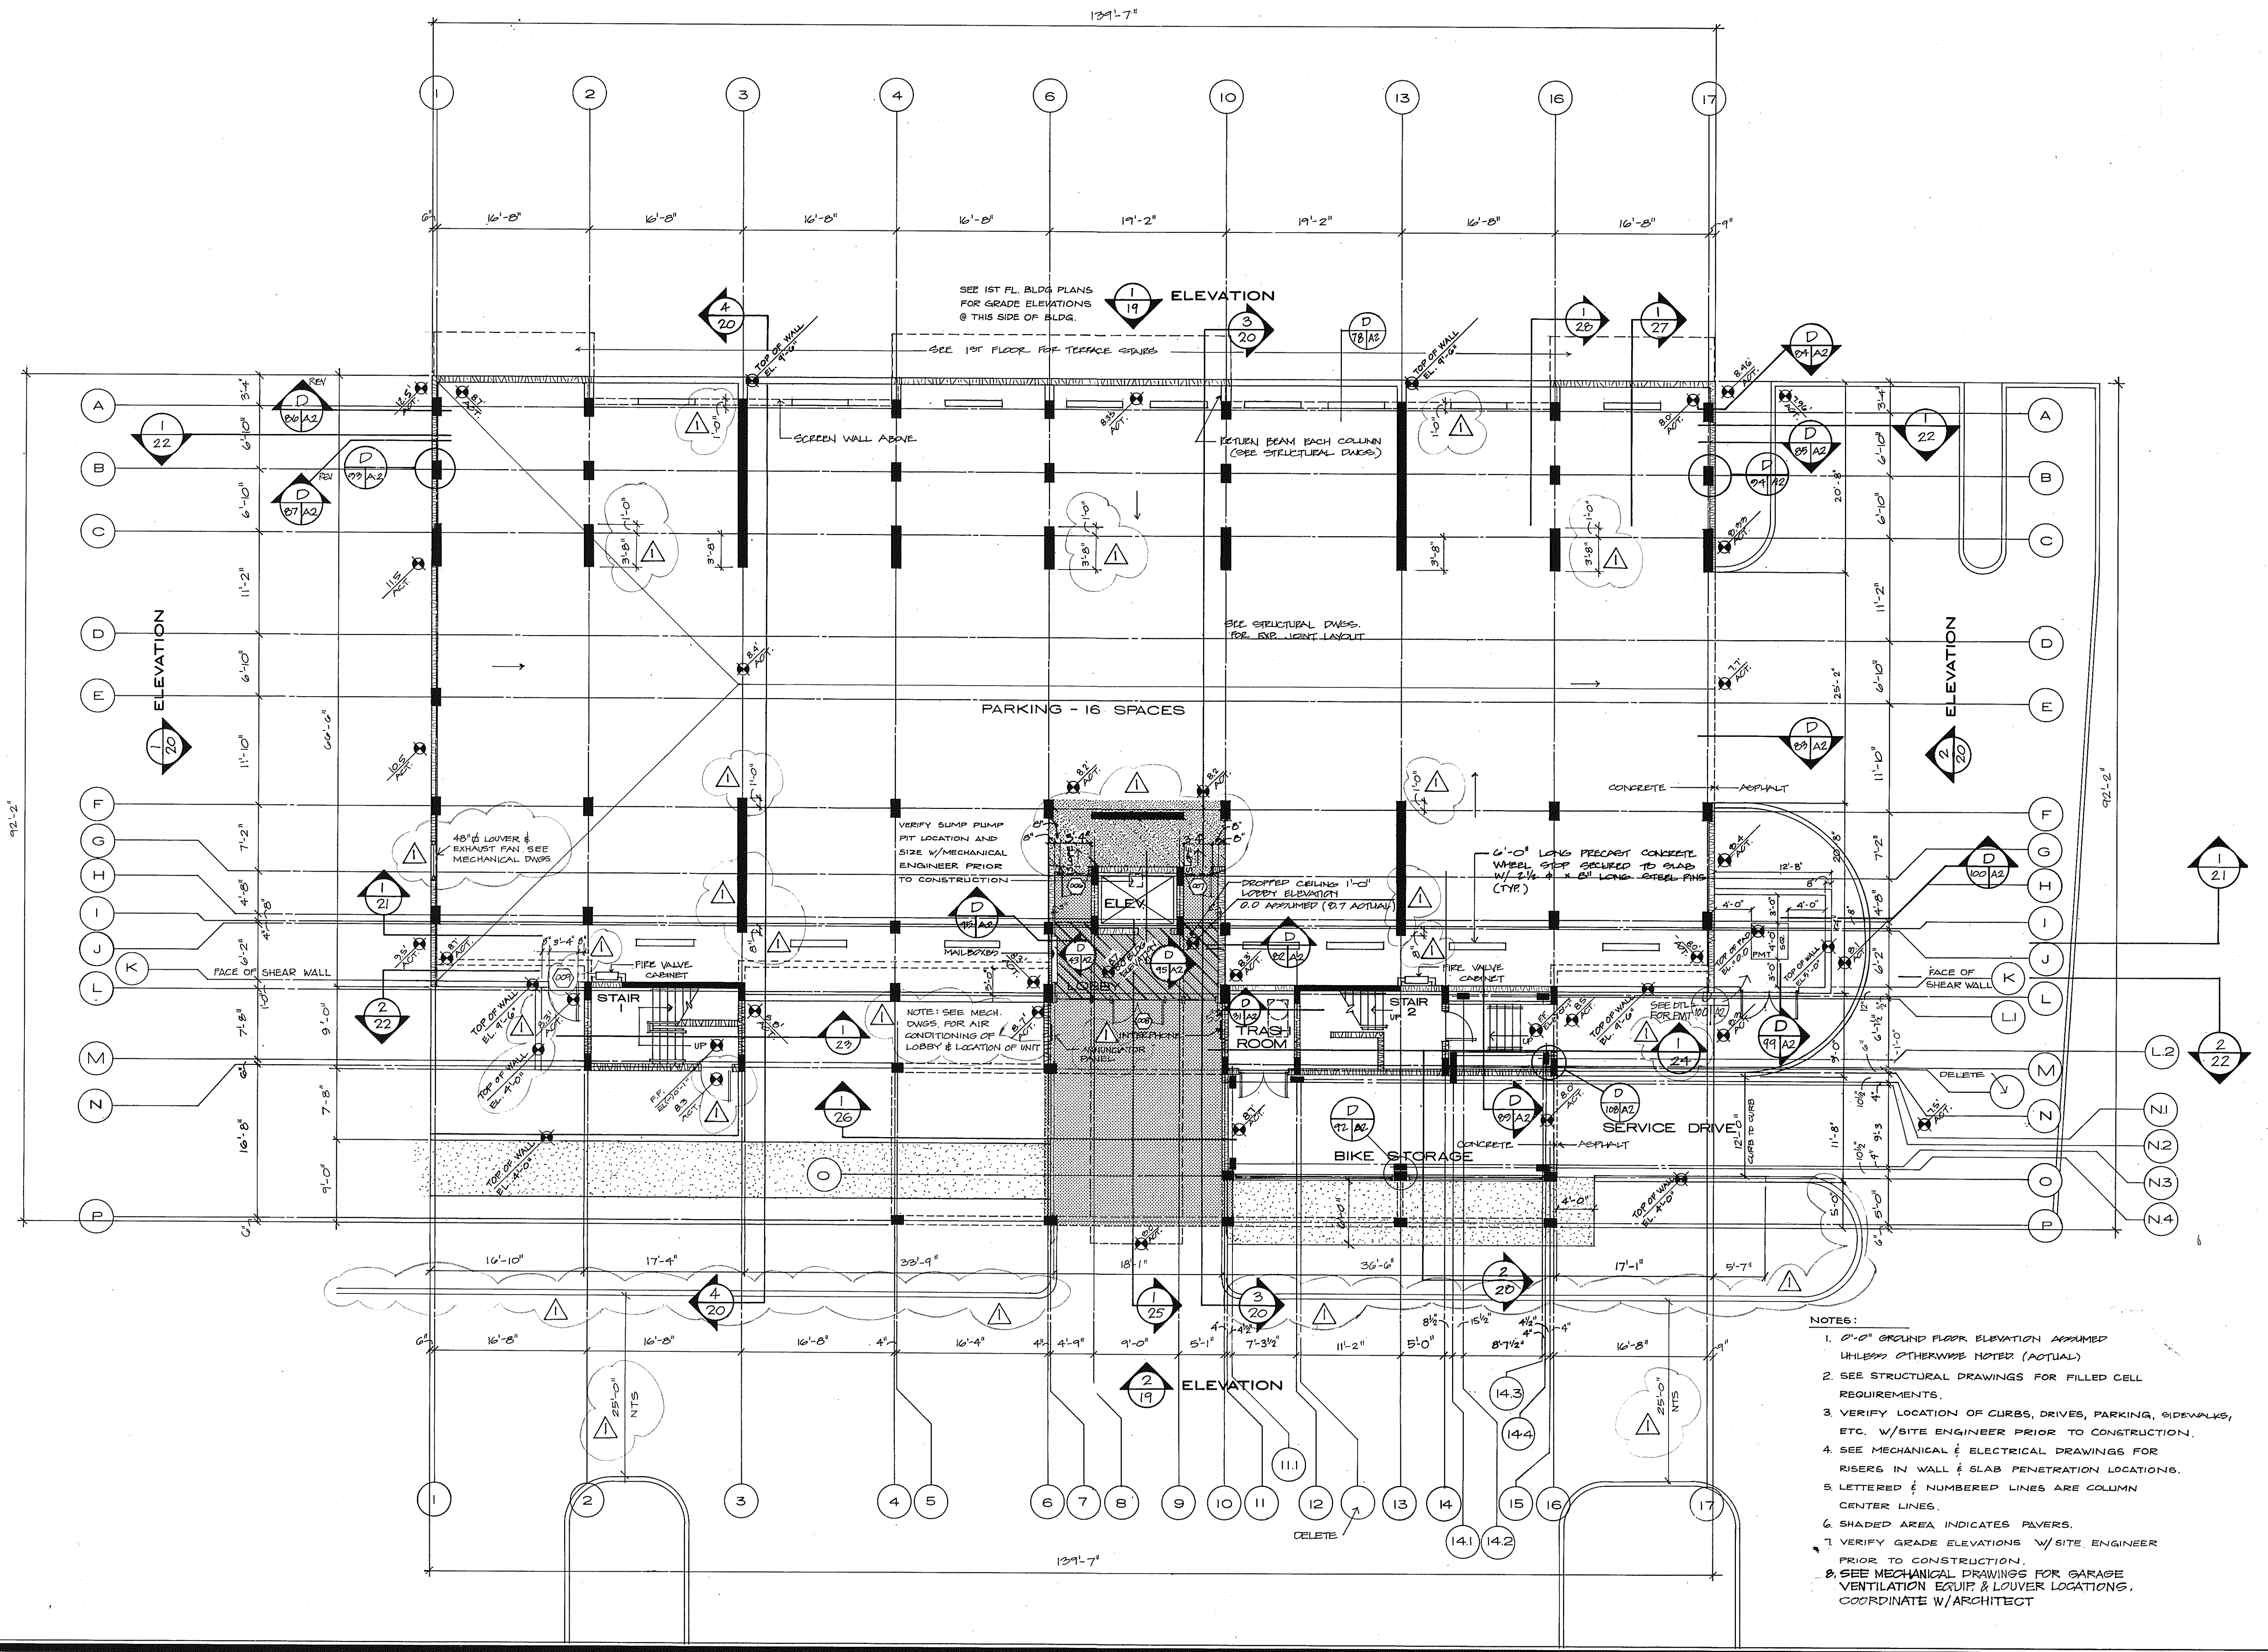

- NOTES:
1. 0'-0" GROUND FLOOR ELEVATION ASSUMED UNLESS OTHERWISE NOTED (ACTUAL)
 2. SEE STRUCTURAL DRAWINGS FOR FILLED CELL REQUIREMENTS.
 3. VERIFY LOCATION OF CURBS, DRIVES, PARKING, SIDEWALKS, ETC. W/SITE ENGINEER PRIOR TO CONSTRUCTION.
 4. SEE MECHANICAL & ELECTRICAL DRAWINGS FOR RISERS IN WALL & SLAB PENETRATION LOCATIONS.
 5. LETTERED & NUMBERED LINES ARE COLUMN CENTER LINES.
 6. SHADED AREA INDICATES PAVERS.
 7. VERIFY GRADE ELEVATIONS W/SITE ENGINEER PRIOR TO CONSTRUCTION.
 8. SEE MECHANICAL DRAWINGS FOR GARAGE VENTILATION EQUIP. & LOUVER LOCATIONS. COORDINATE W/ARCHITECT

SUNSET BEACH
 OF FLOLONG BOAT KEY
 BUILDING 1 GROUND FLOOR PLAN 1/8" = 1'-0"
 ARVIDA CORPORATION · EDWARD J. SEIBERT AIA ARCHITECT & PLANNER PA · THE SWA GROUP
 BRABHAM KUHNS DEBAY CONSULTING ENGINEERS · OLSEN WHITE & ASSOCIATES STRUCTURAL ENGINEERS · BENNETT & BISHOP INC CONSULTING ENGINEERS & SURVEYORS
 ISSUED 10 DEC 82
 REVISED 4-1-83
 SHEET A-2 OF 37