


OVERLAYS	1	1
COMPOSITE	2	2
	4	4
	5	5
	6	6

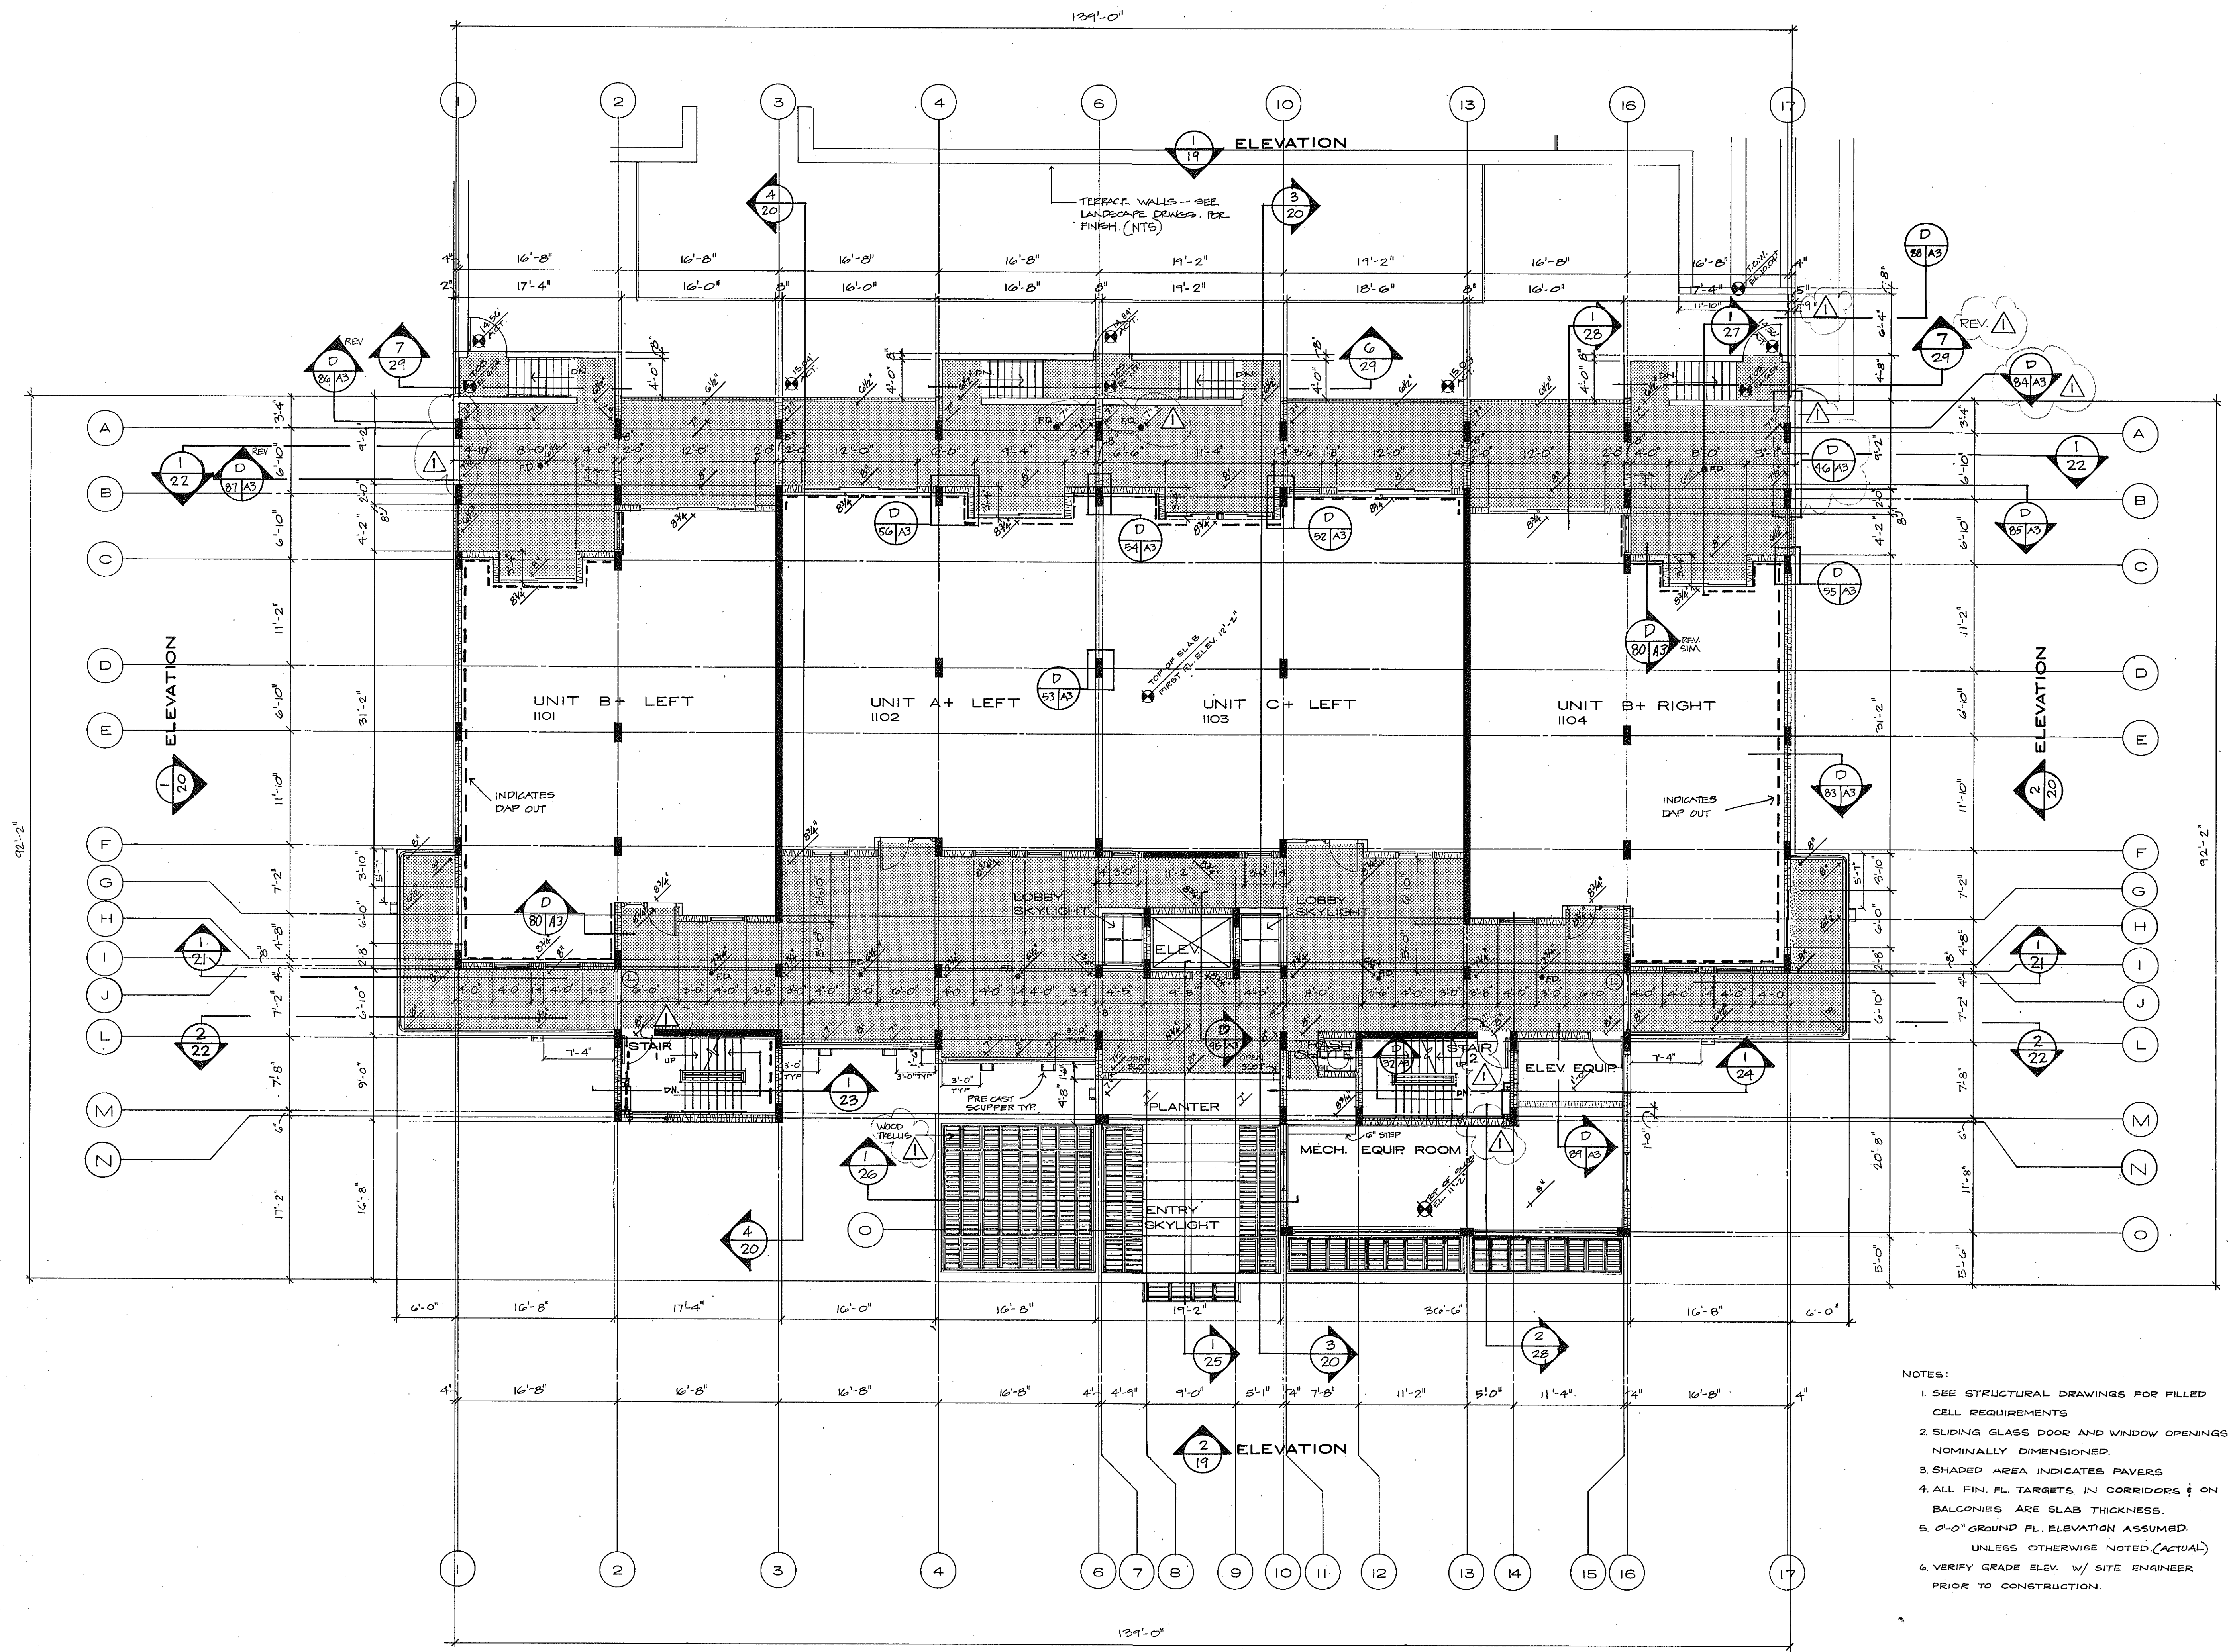

- NOTES:
1. SEE STRUCTURAL DRAWINGS FOR FILLED CELL REQUIREMENTS
  2. SLIDING GLASS DOOR AND WINDOW OPENINGS NOMINALLY DIMENSIONED.
  3. SHADED AREA INDICATES PAVERS
  4. ALL FIN. FL. TARGETS IN CORRIDORS & ON BALCONIES ARE SLAB THICKNESS.
  5. 0'-0" GROUND FL. ELEVATION ASSUMED UNLESS OTHERWISE NOTED (ACTUAL)
  6. VERIFY GRADE ELEV. W/ SITE ENGINEER PRIOR TO CONSTRUCTION.