


OVERLAYS	1	1
COMPOSITE	2	2
	4	4
	7	7
	8	8

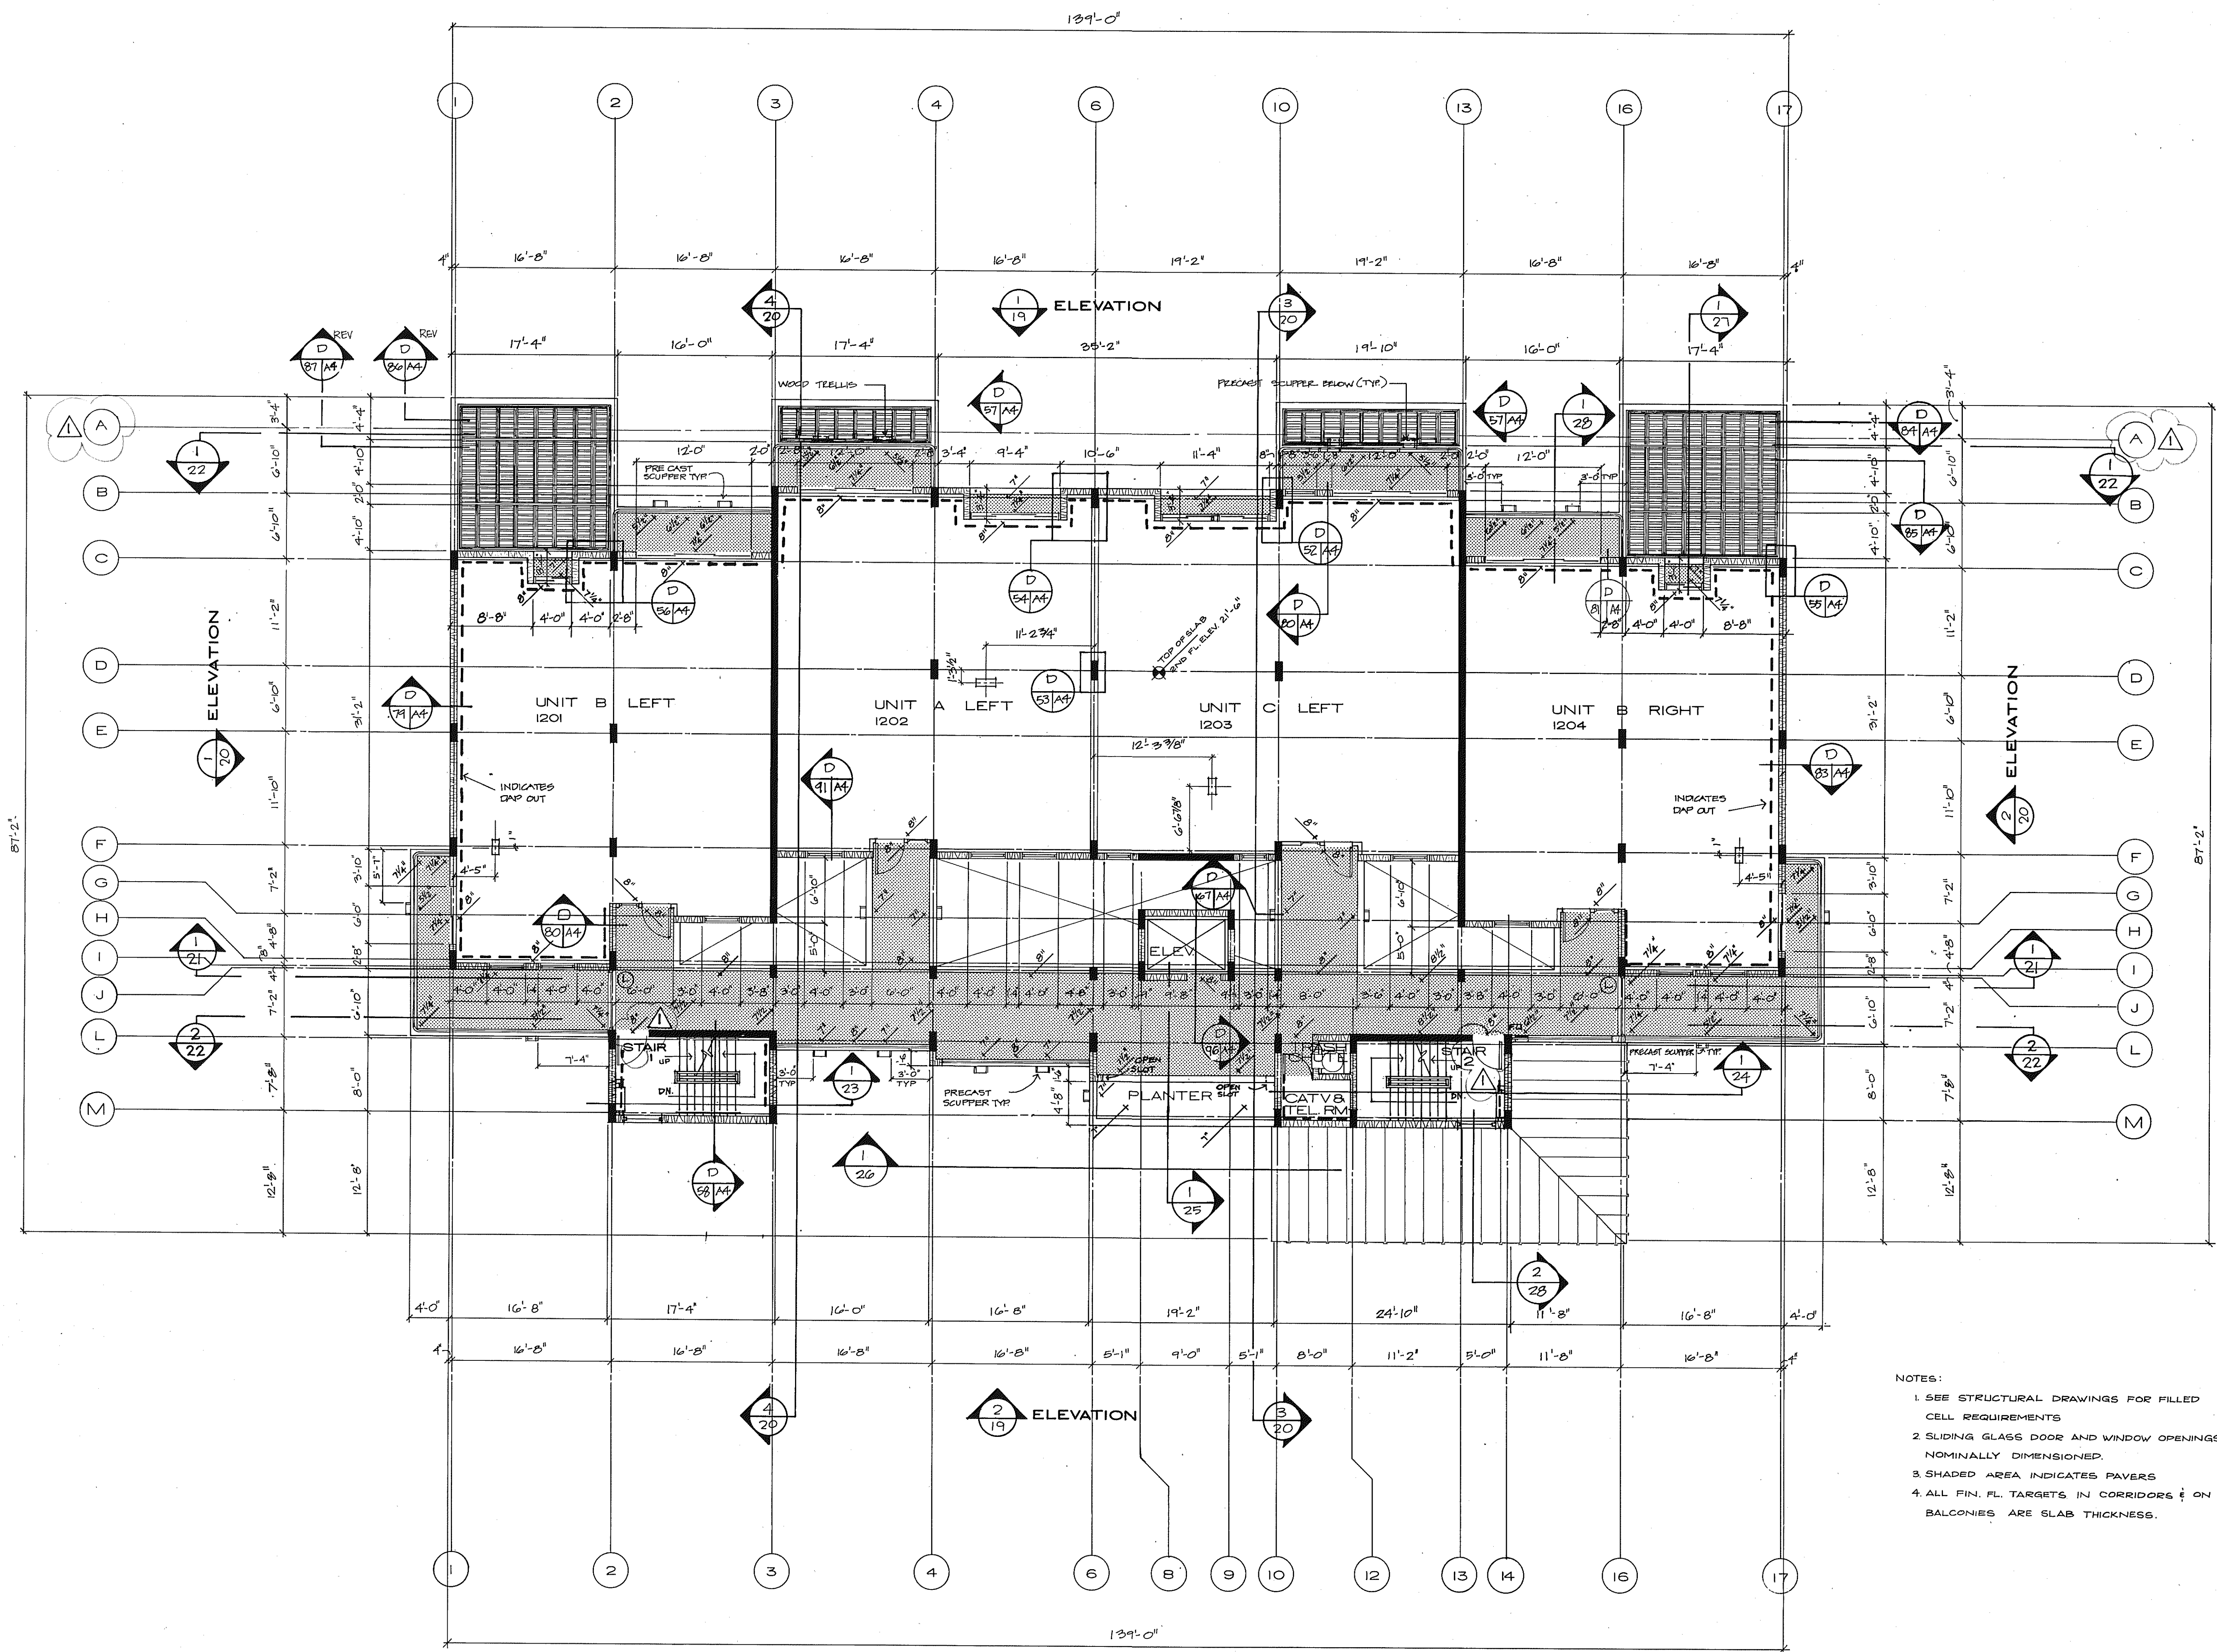

- NOTES:
1. SEE STRUCTURAL DRAWINGS FOR FILLED CELL REQUIREMENTS
  2. SLIDING GLASS DOOR AND WINDOW OPENINGS NOMINALLY DIMENSIONED.
  3. SHADED AREA INDICATES PAVERS
  4. ALL FIN. FL. TARGETS IN CORRIDORS & ON BALCONIES ARE SLAB THICKNESS.