


OVERLAYS	1
COMPOSITE	2
	4
	9
	10

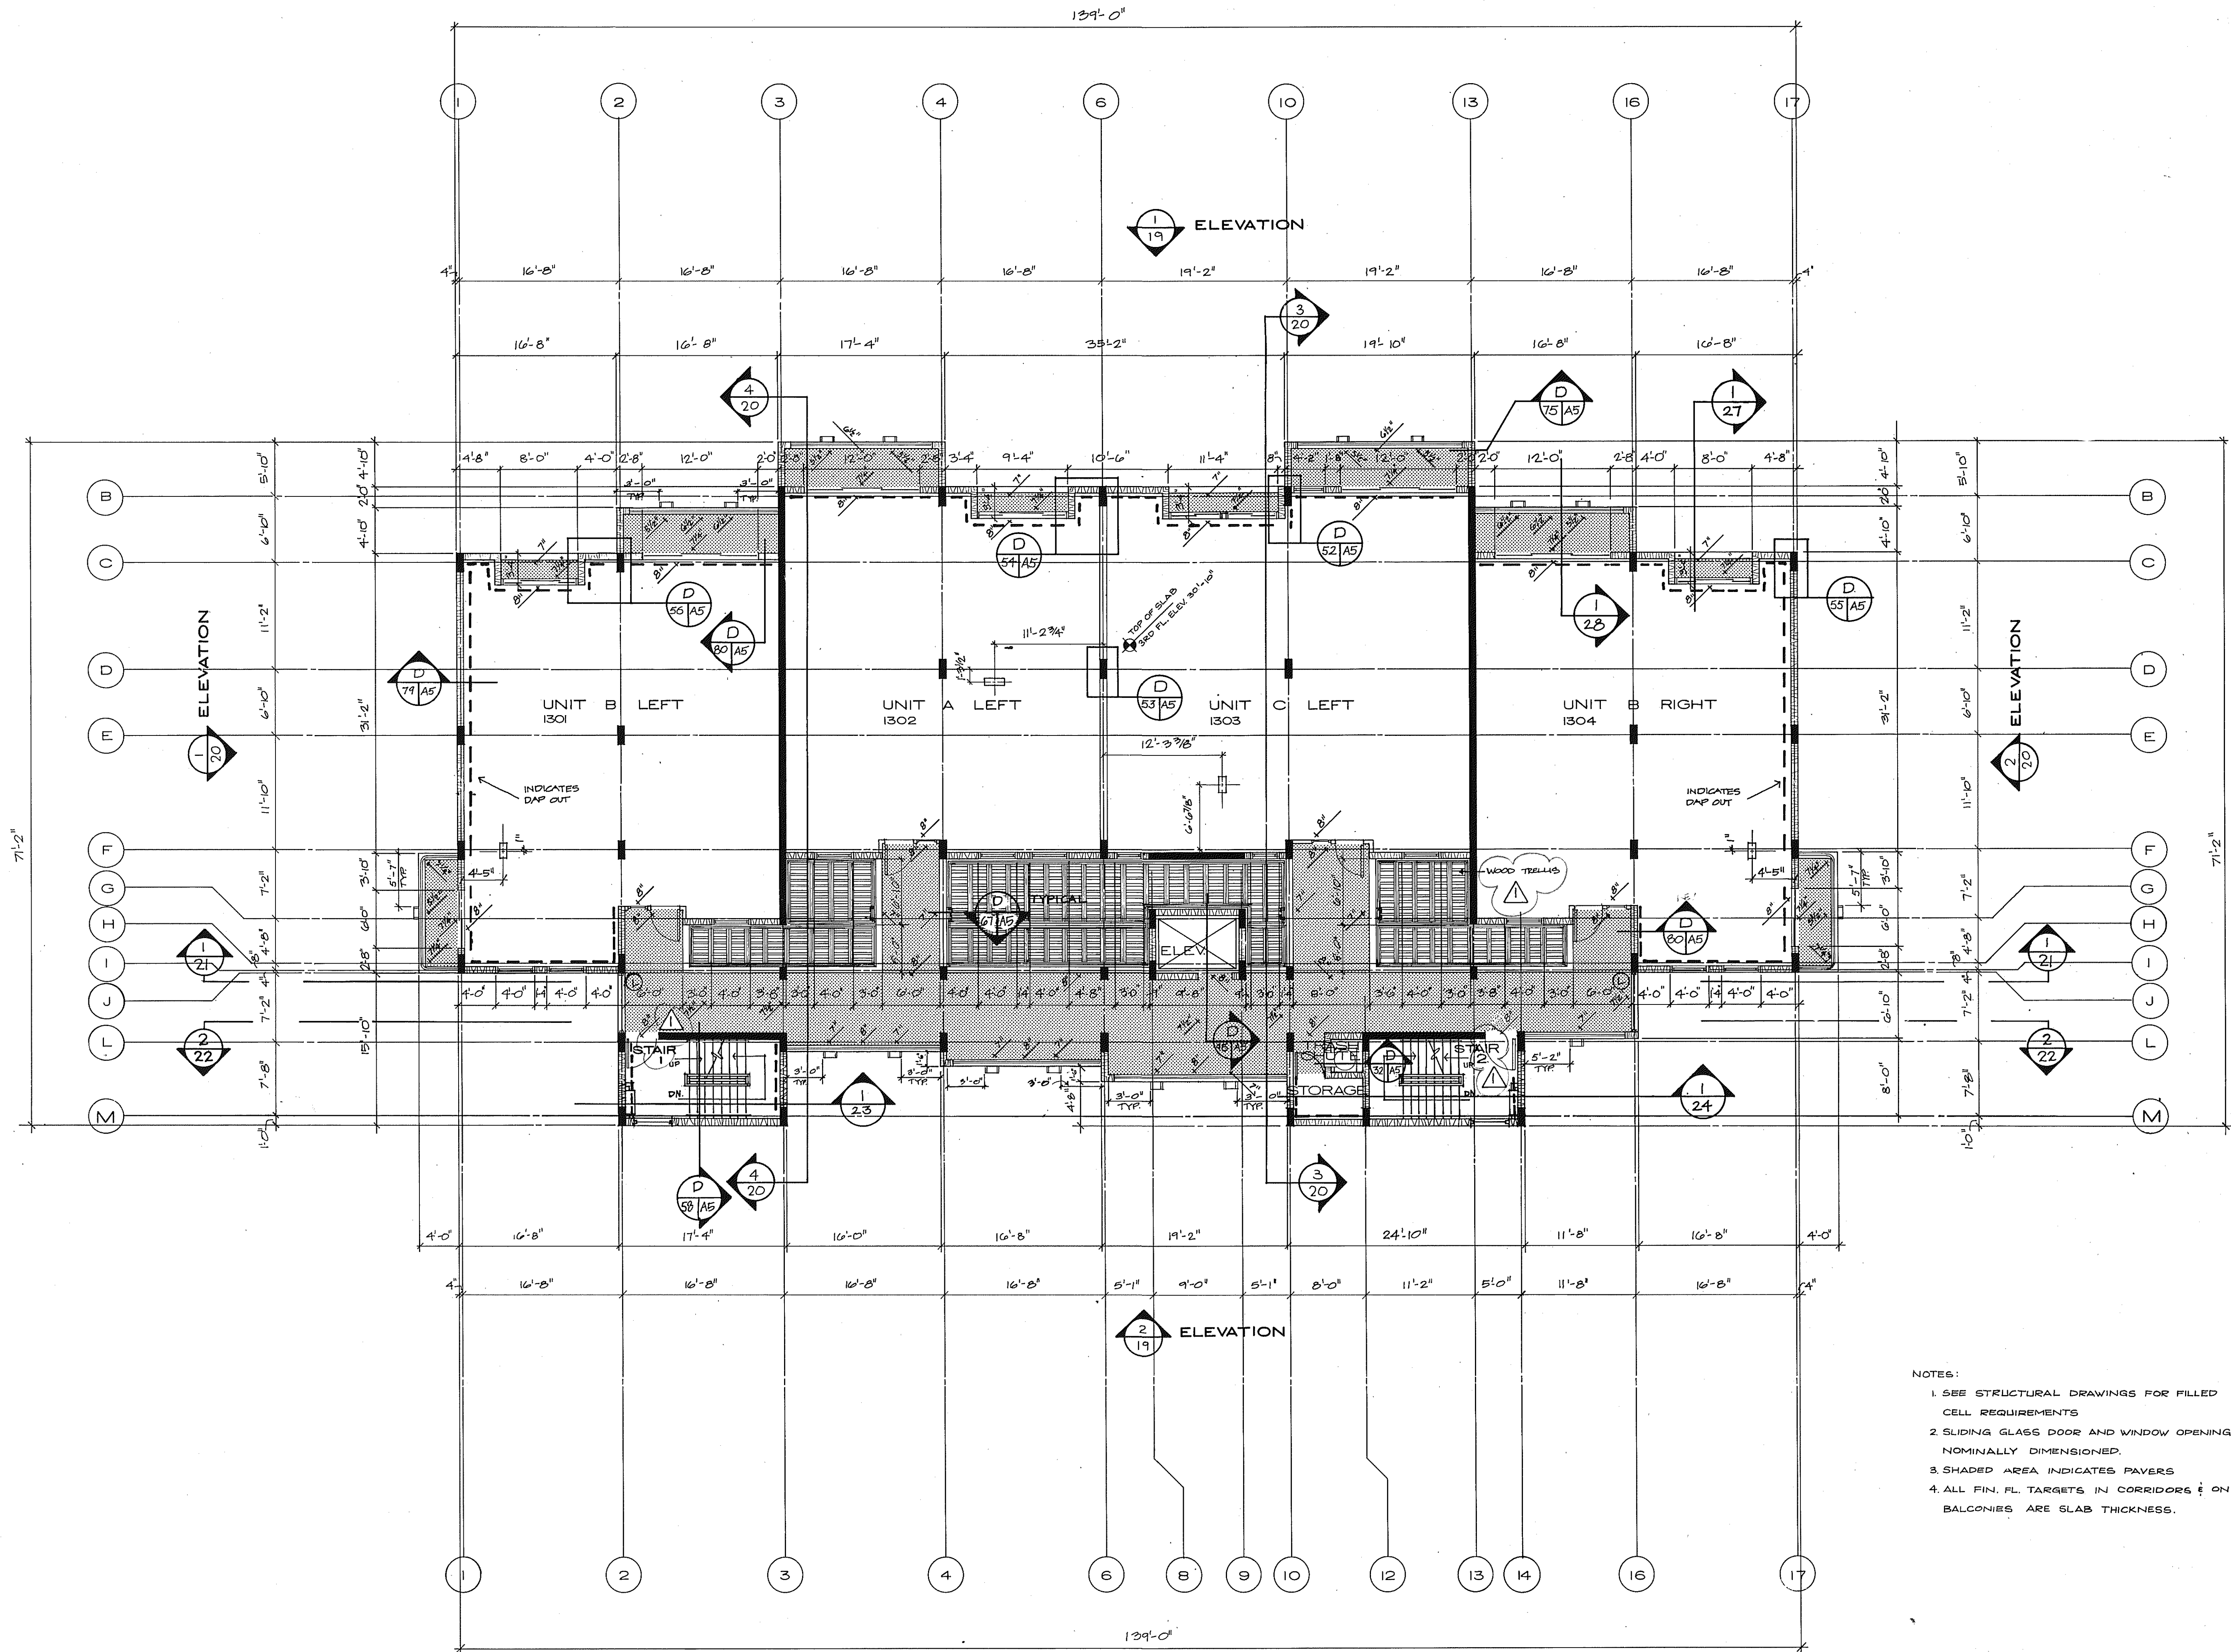

- NOTES:
1. SEE STRUCTURAL DRAWINGS FOR FILLED CELL REQUIREMENTS
 2. SLIDING GLASS DOOR AND WINDOW OPENINGS NOMINALLY DIMENSIONED.
 3. SHADED AREA INDICATES PAVERS
 4. ALL FIN. FL. TARGETS IN CORRIDORS & ON BALCONIES ARE SLAB THICKNESS.

BUILDING 1 THIRD FLOOR PLAN 1/8" = 1'-0"

ISSUED
10 DEC. 82

REVISED
4-1-83

SHEET
A.5
OF 37