


OVERLAYS	1
COMPOSITE	2
13	13

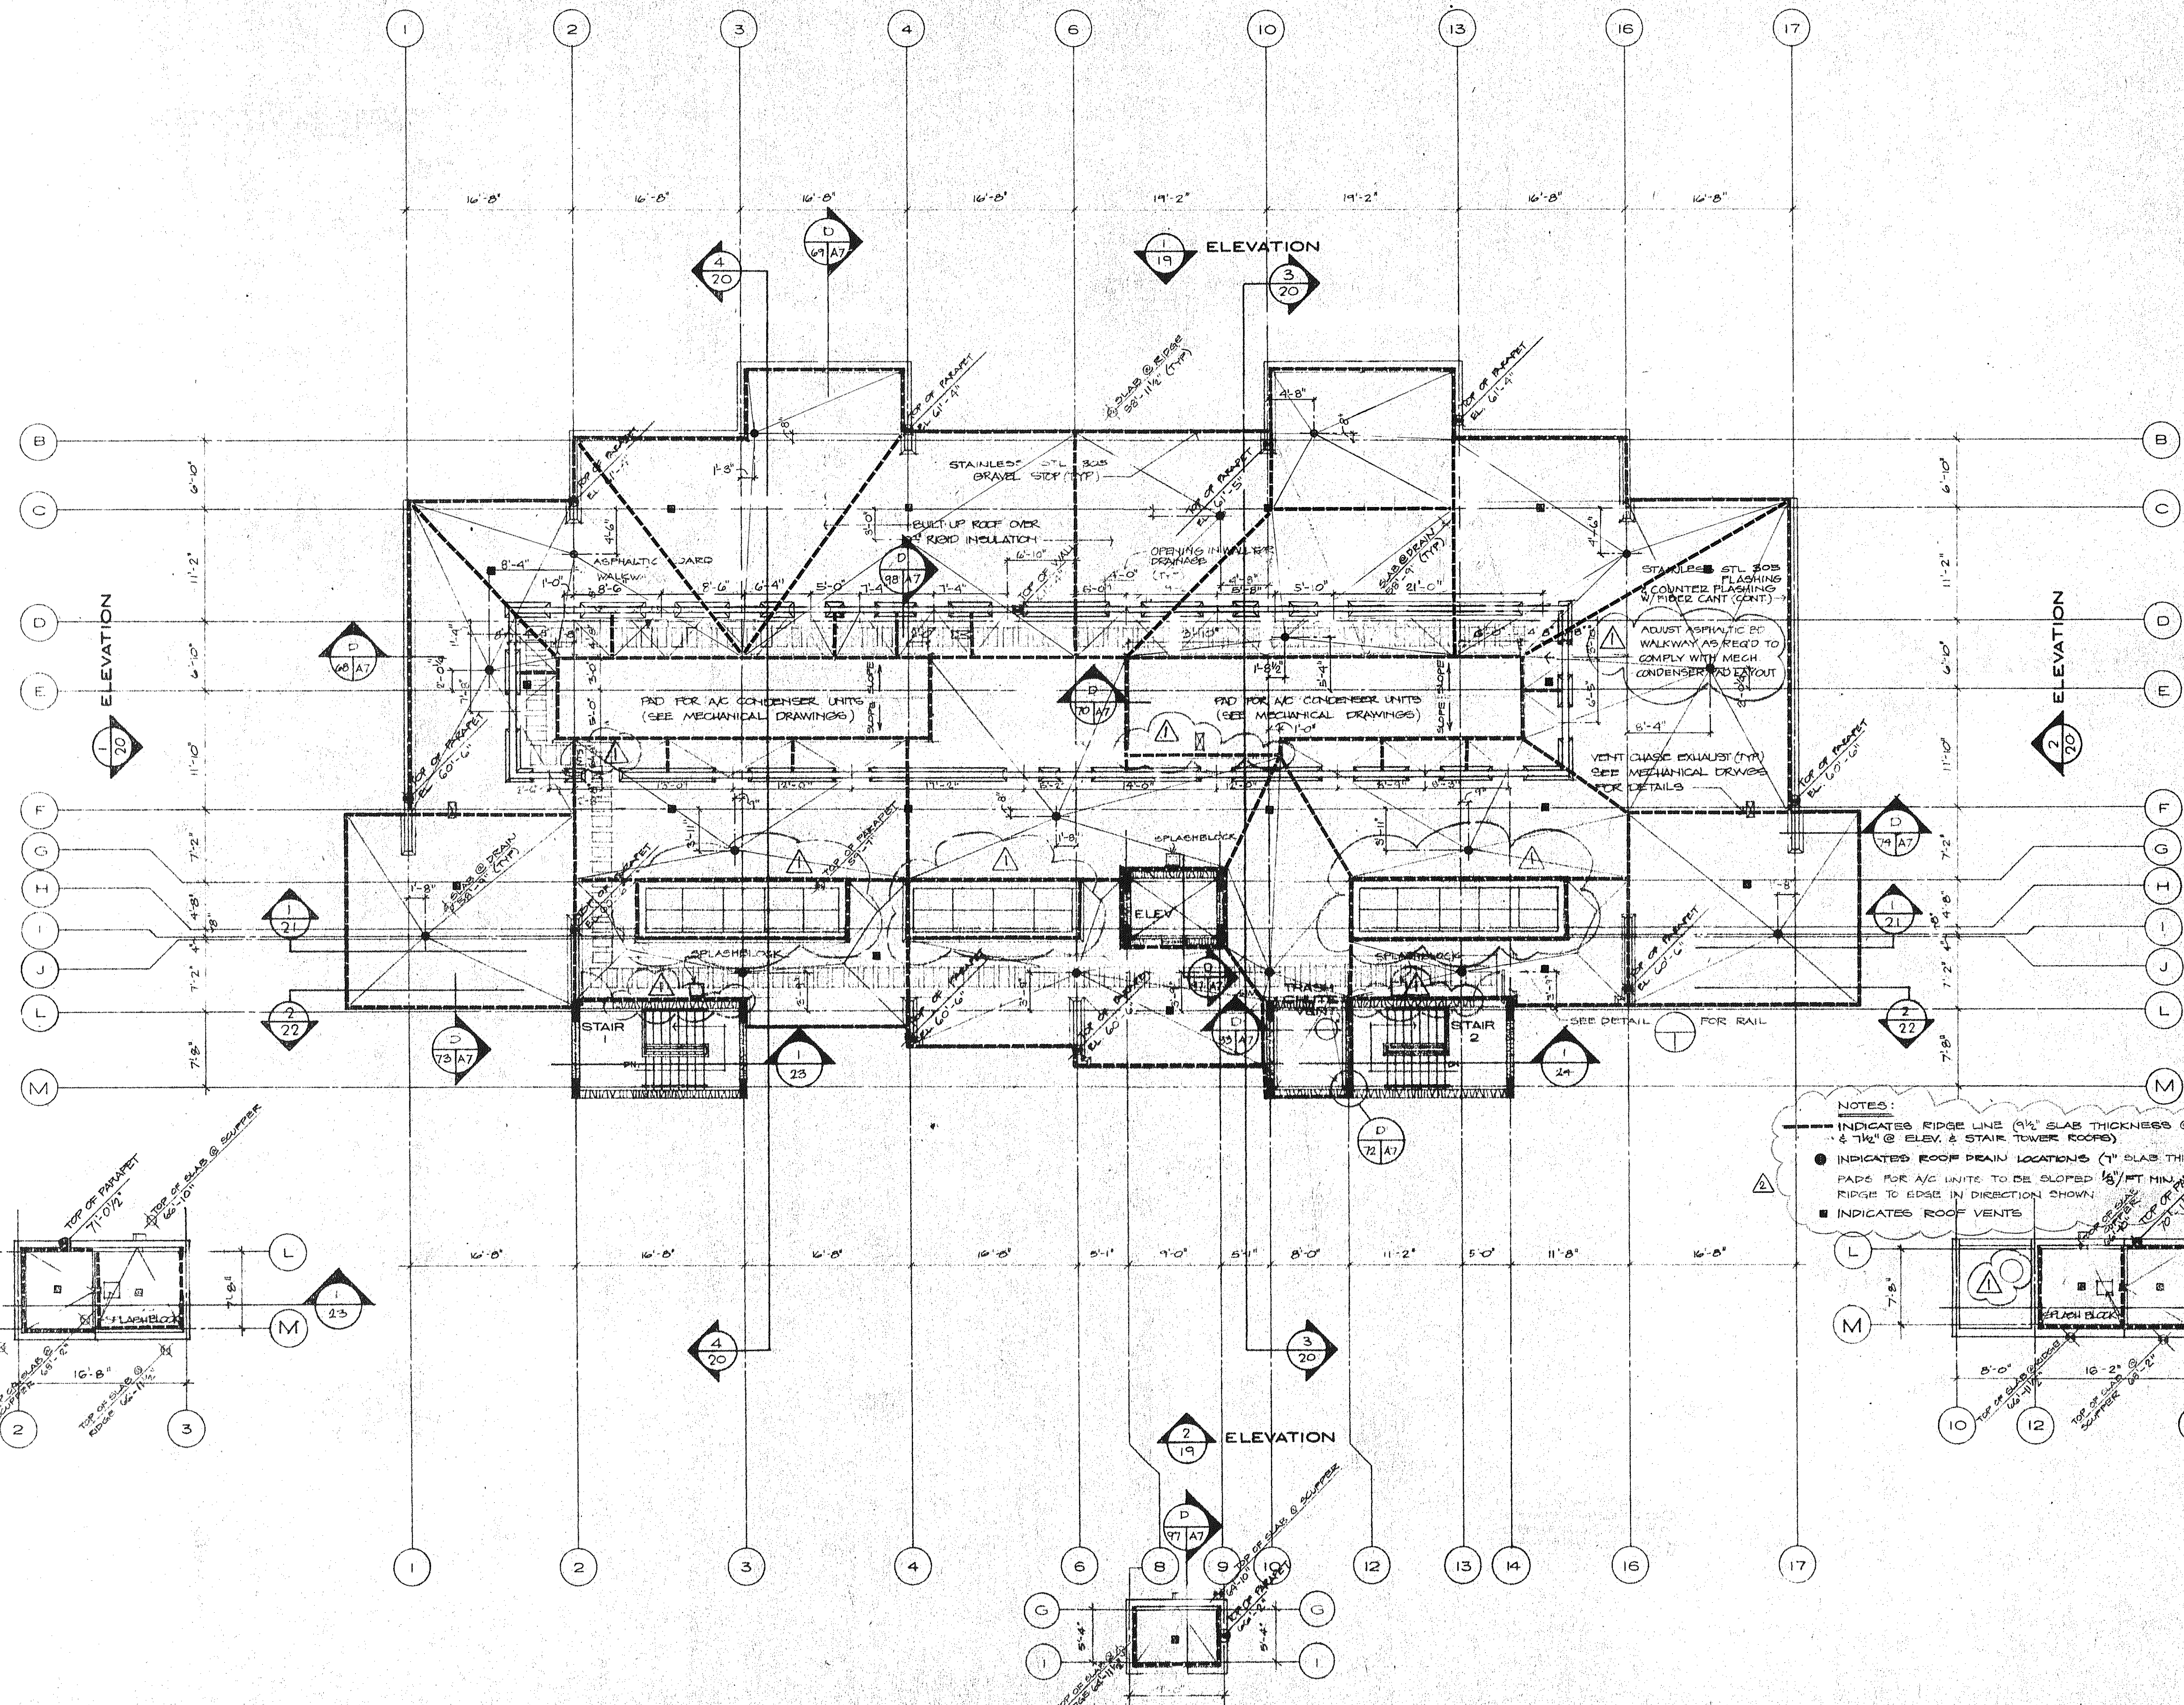

NOTES:

- PADS FOR A/C UNITS TO BE SLOPED 1/8" FT MIN. FROM RIDGE TO EDGE IN DIRECTION SHOWN
- INDICATES ROOF VENTS