


OVERLAYS	1
COMPOSITE	1
23	23
24	24
25	25
26	26
27	27

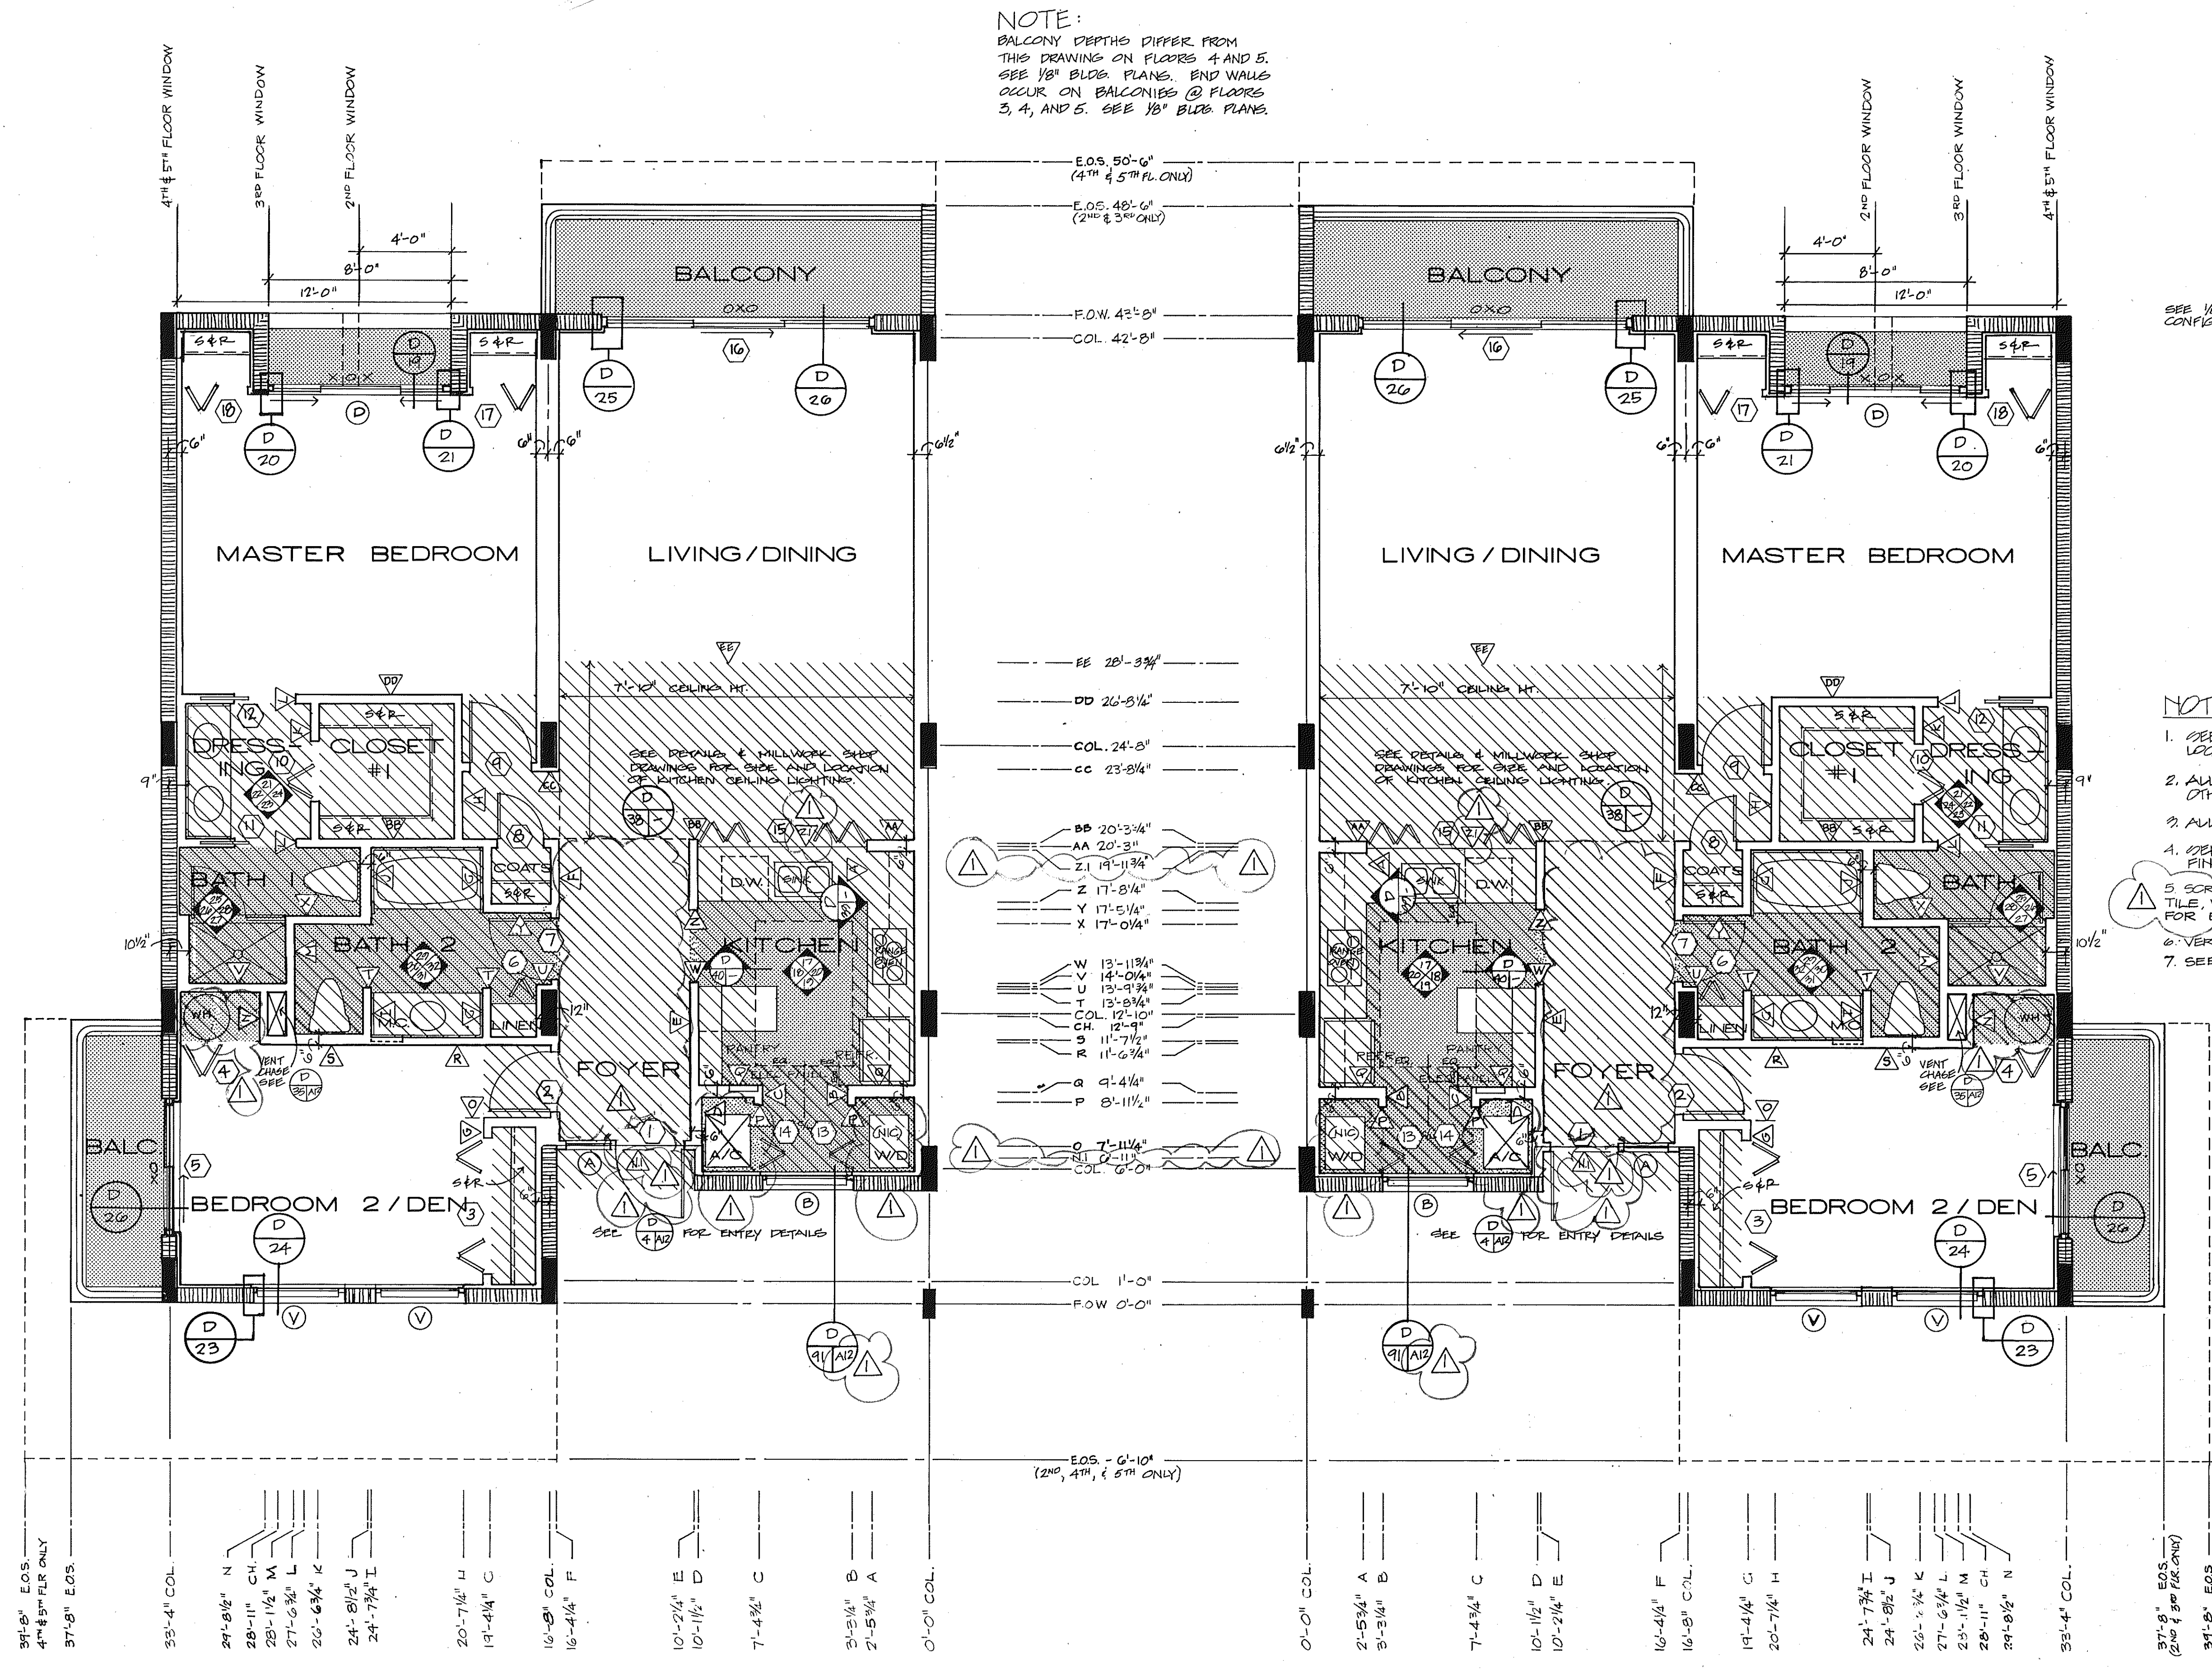

UNIT B LEFT

UNIT B RIGHT