



- NOTES:
1. SEE 1/8" BLDG. PLANS FOR COL. & SHEAR WALL LOCATIONS.
 2. ALL DROPPED CLOS. ARE 7'-0" UNLESS OTHERWISE NOTED.
 3. ALL DIMENSIONS ARE FROM CENTERLINE OF WALL.
 4. SEE DETAIL BOOKLET FOR DOOR, WINDOW & FINISH SCHEDULES.
 5. SCREEN DOT TEXTURE DENOTES PAVERS, CER. TILE, VINYL TILE OR VAT. SEE FINISH SCHEDULE FOR EXACT LOCATION.
 6. VERIFY EXACT LOCATION OF LANS. W/ ARCHITECT.
 7. DASHED LINE ABOVE THE WASHER/DRYER IS A CONTINUOUS UPPER CABINET W/ DOORS. CONSTRUCTION IS TO BE PER KITCHEN UPPER CABINETS EXCEPT DELETE ALL WOOD TRIM. FULLS TO BE RECESSED OAK.
 8. SEE SHEET A-9 FOR PLAN DIMENSIONING KEY.

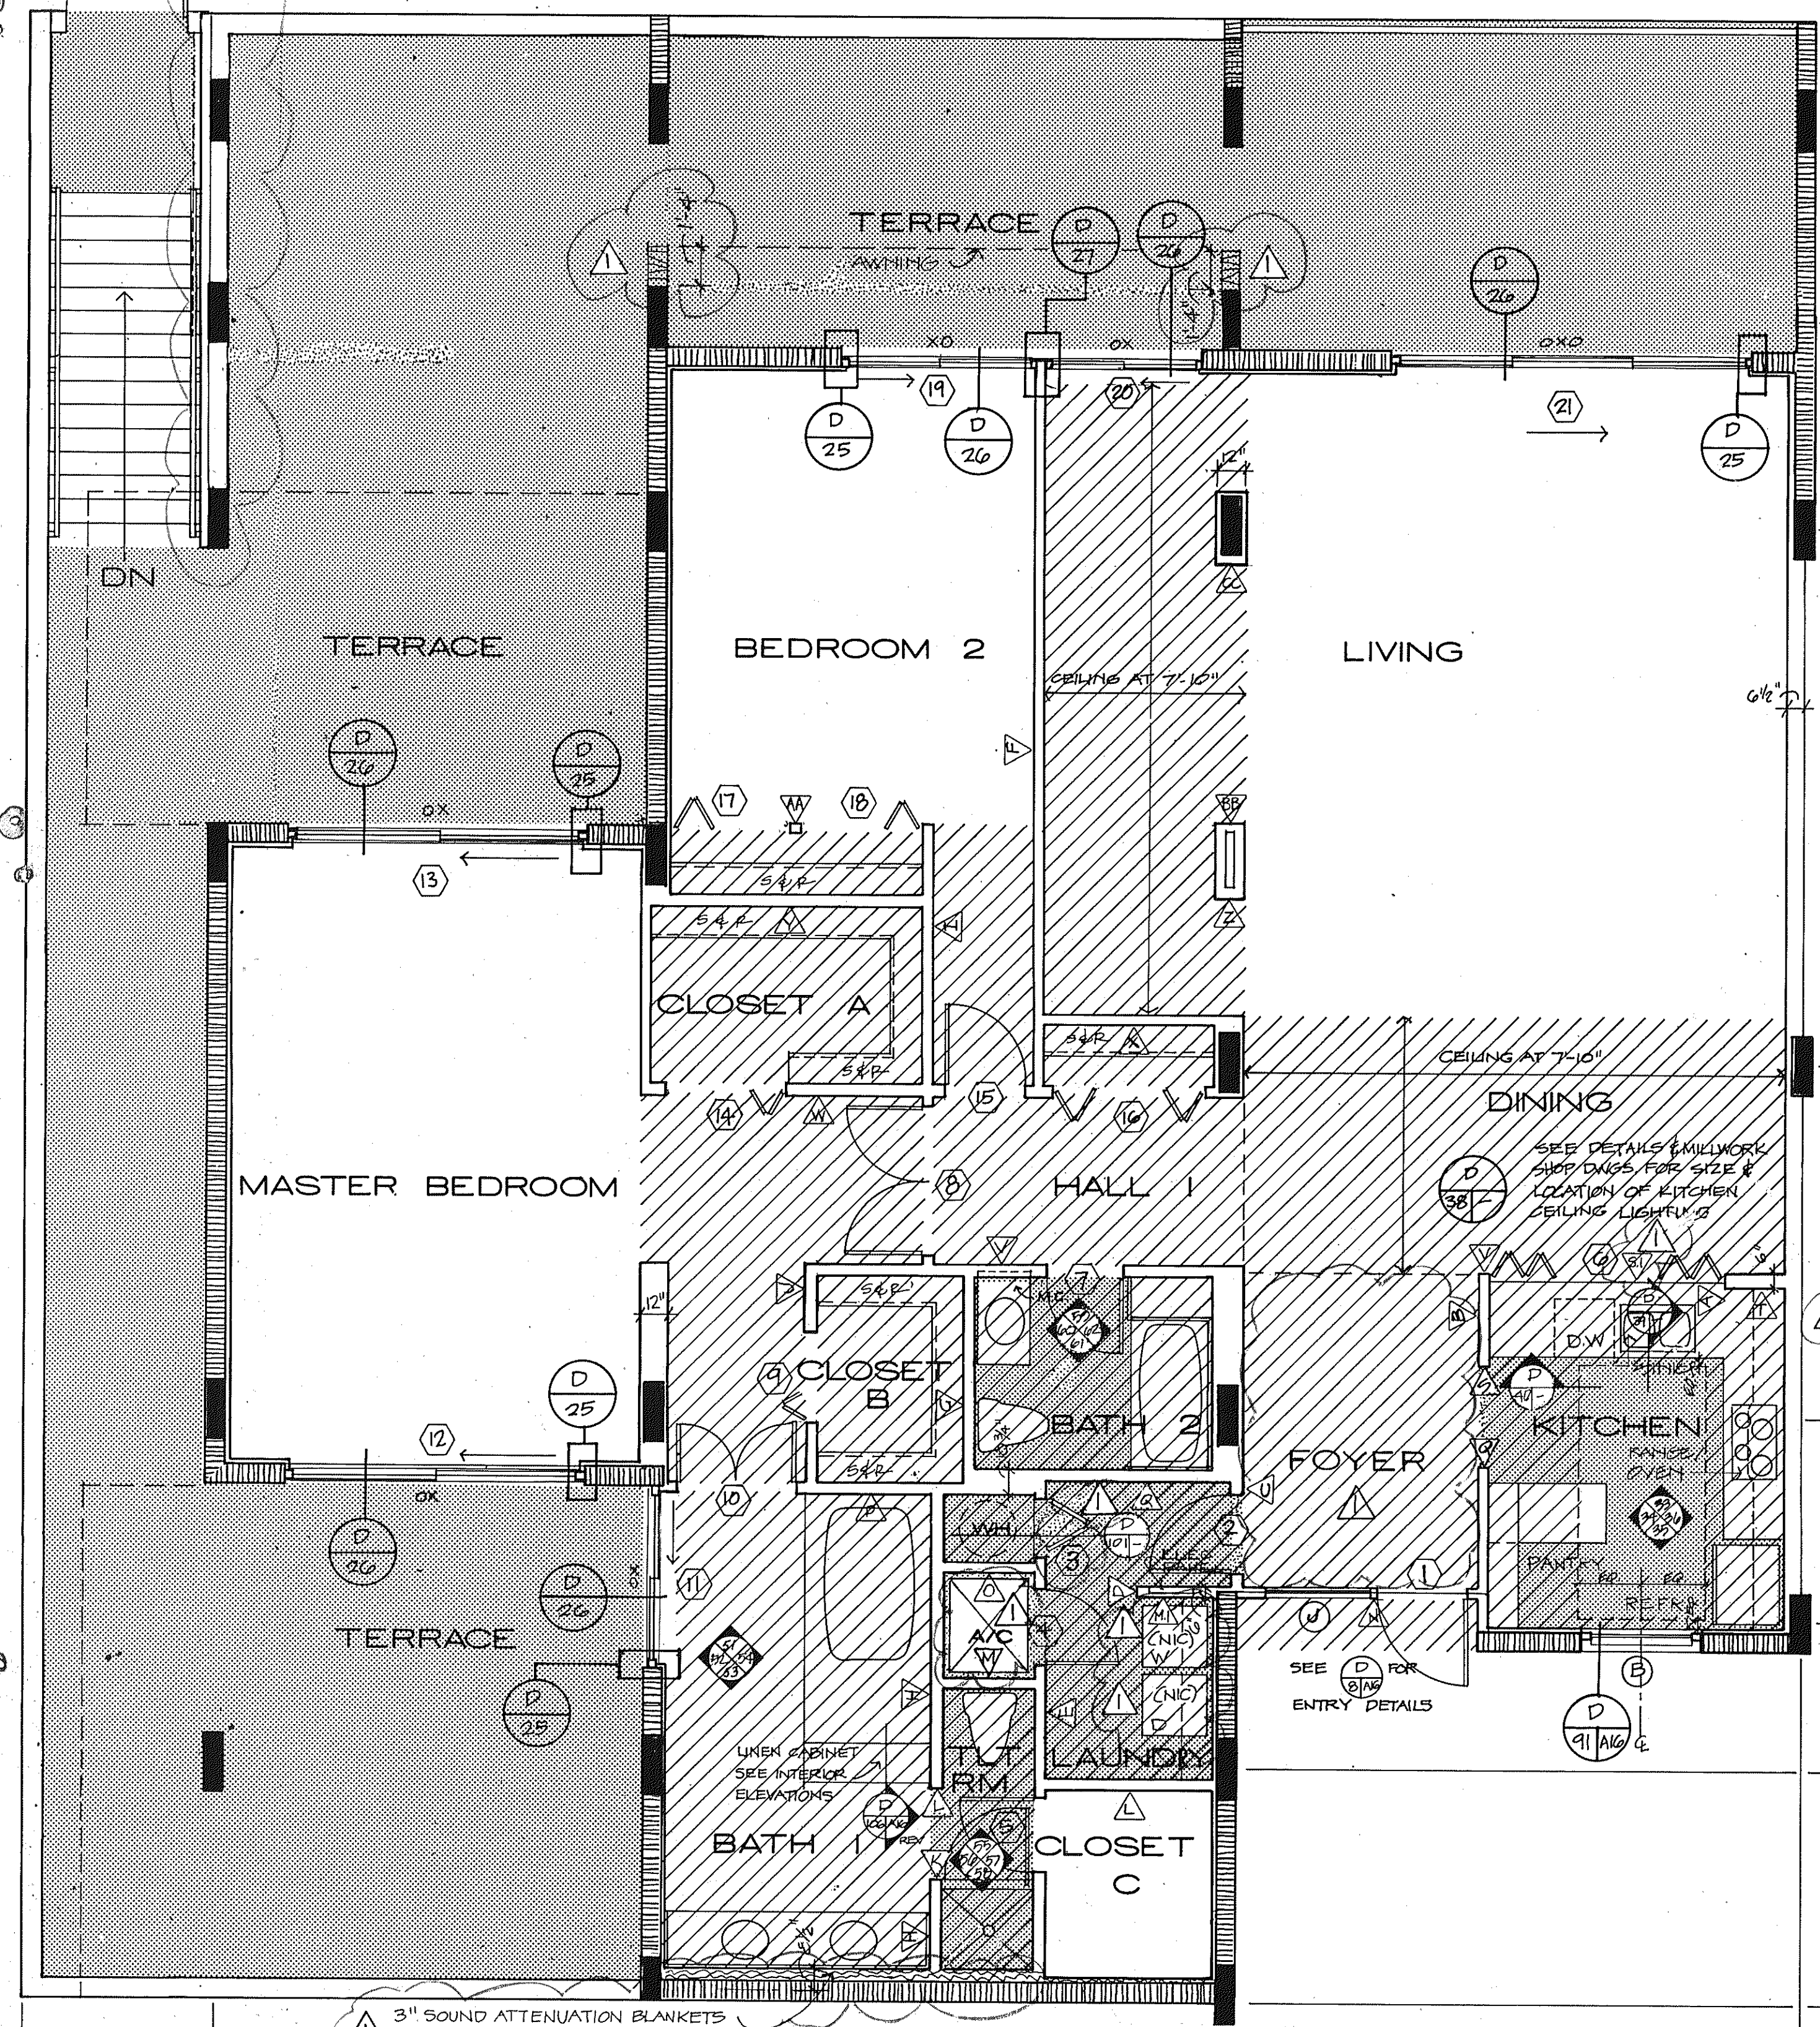

BB	39'-4"
AA	39'-3 3/4"
COL.	63'-2"
Z	37'-2"
Y	36'-10 1/4"
X	32'-10 1/4"
COL.	31'-6"
W	30'-0 1/4"
V	24'-6 3/4"
U	24'-6"
T	24'-2"
S1	24'-2 3/4"
S	21'-6 1/2"
R	DELETE
COL.	19'-8"
Q	17'-8 1/2"
P	17'-2 1/4"
O	14'-3"
N	13'-2 1/4"
COL.	12'-10"
M	10'-6 1/4"
COL.	7'-10"
L	7'-2 3/4"
K	3'-10 1/4"
FOW	0'-0"

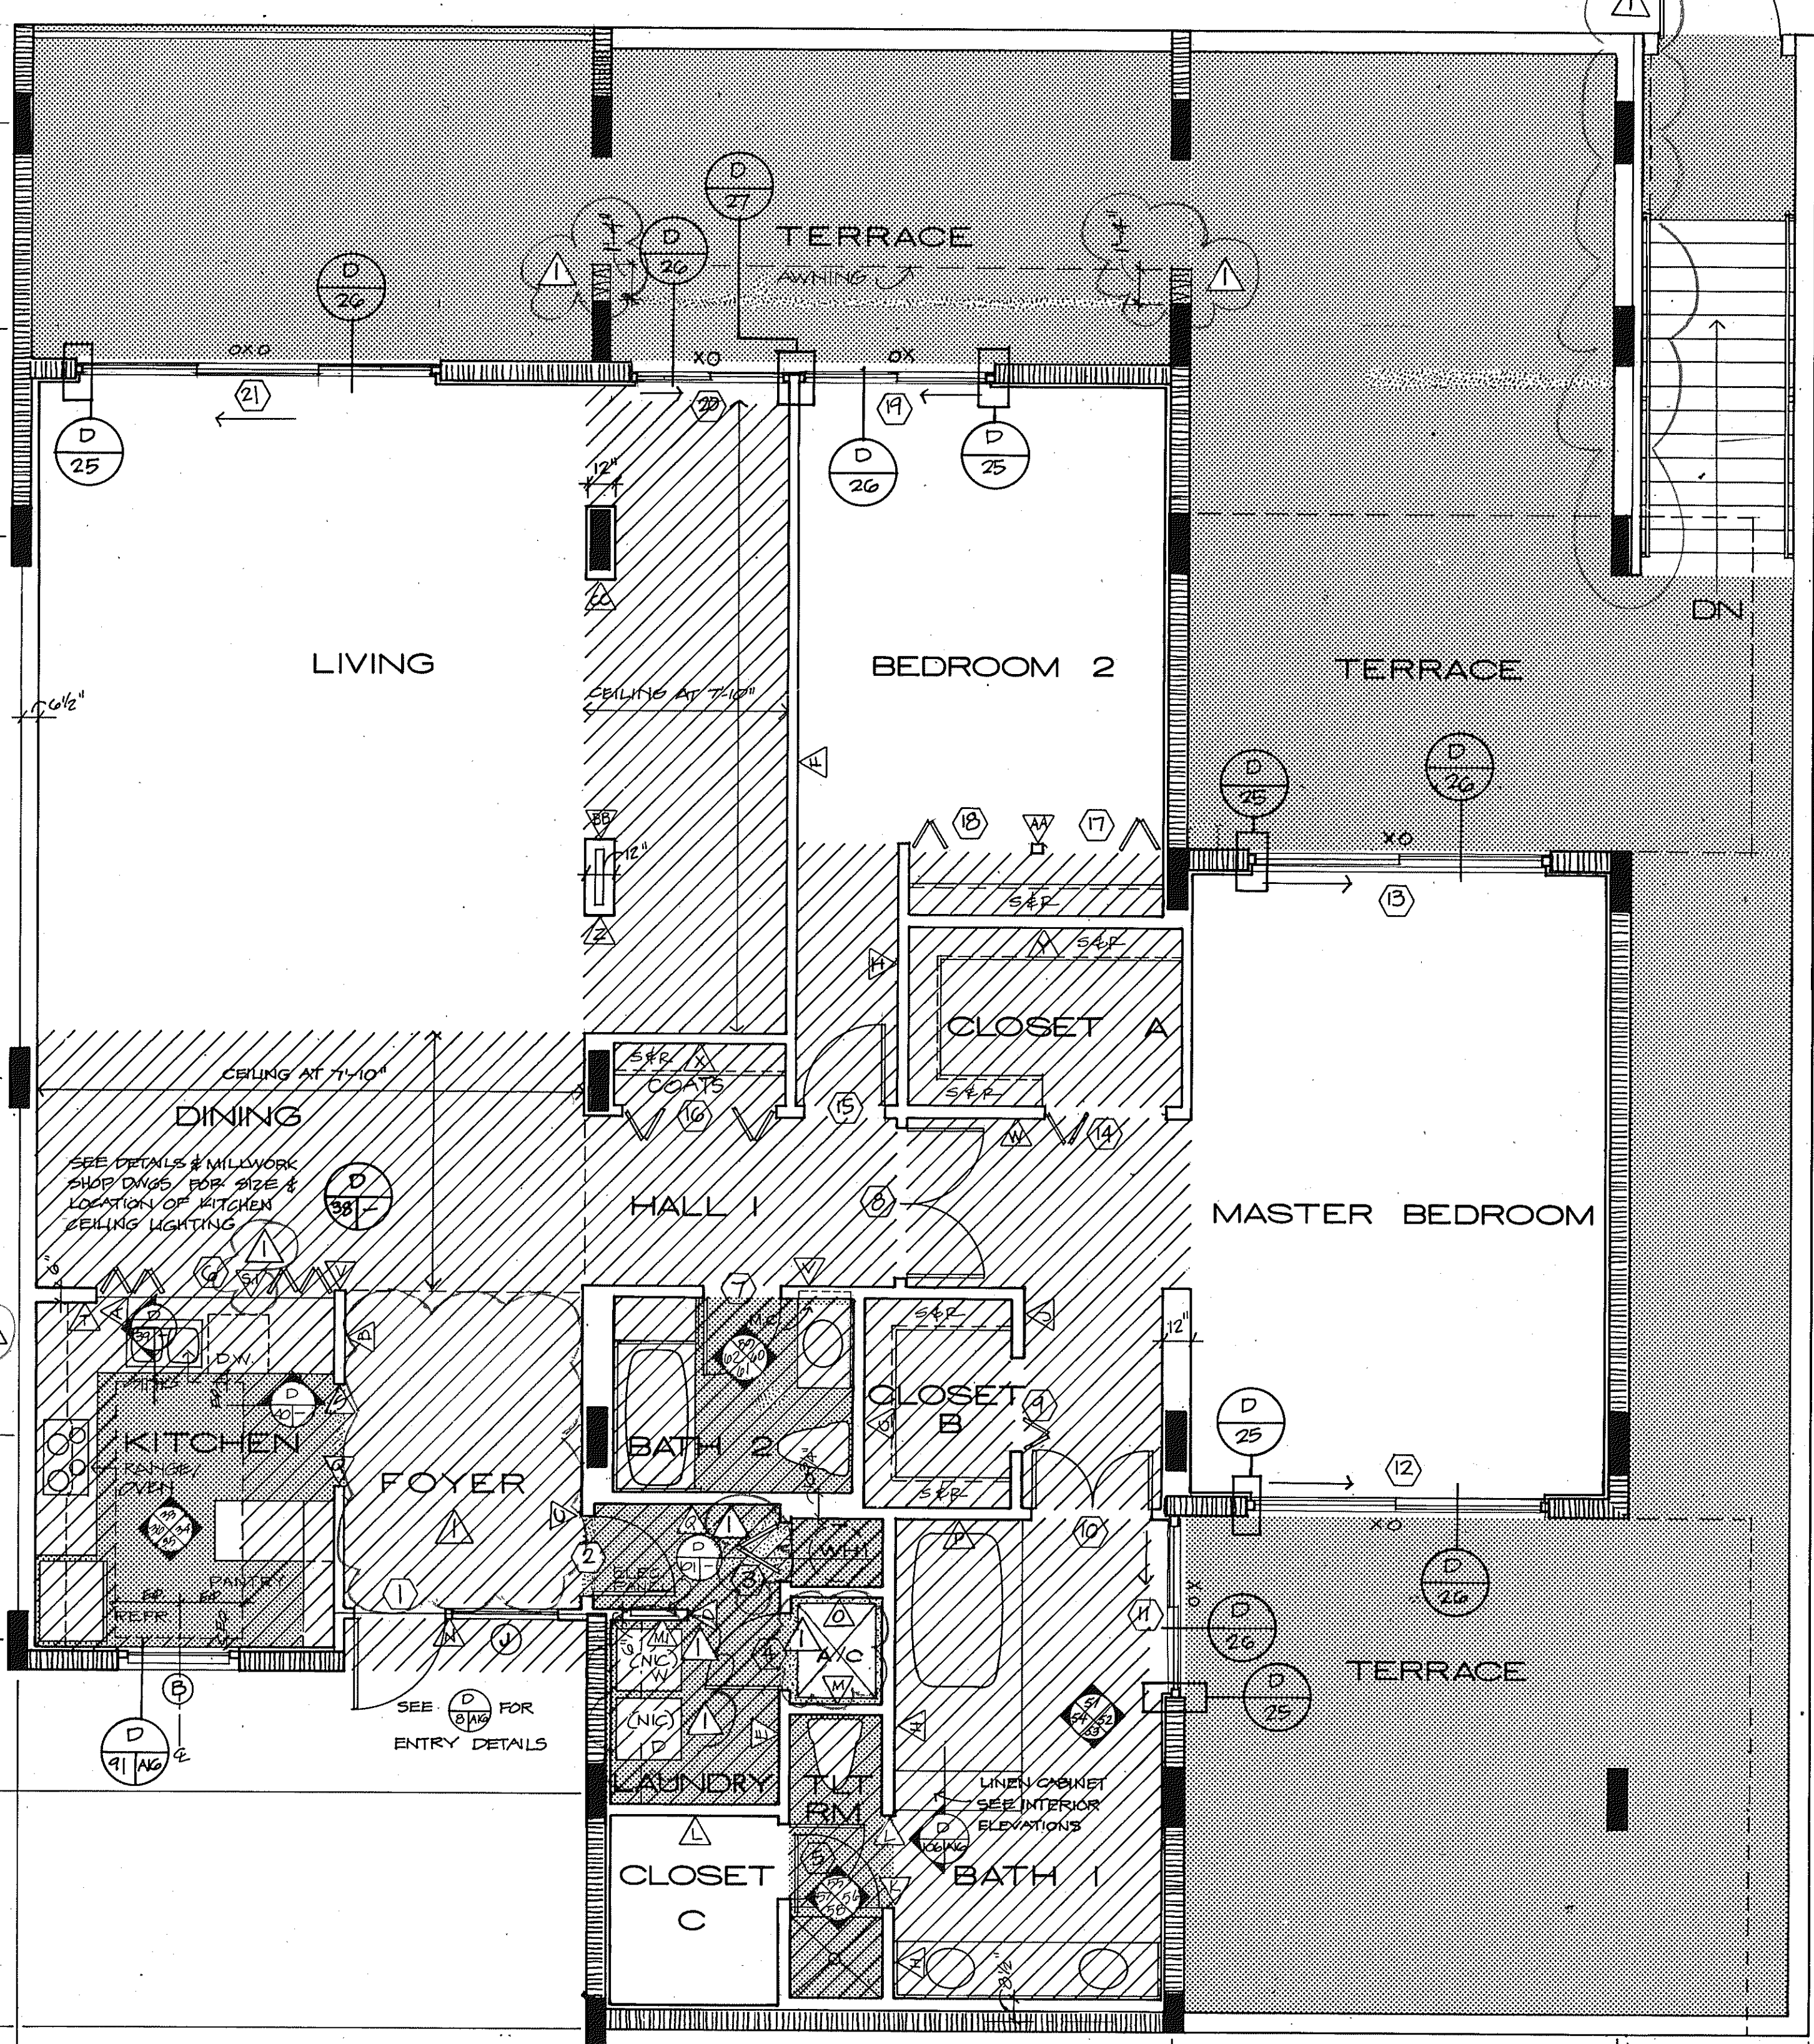

COL.	0'-0"
A	2'-3 3/4"
B	10'-8 1/4"
C	18'-10 1/4"
COL.	19'-2"
D	21'-11 1/4"
E	25'-0 1/4"
F	25'-6 1/4"
G	27'-7 1/4"
H	29'-4 1/4"
I	29'-1 1/4"
J	33'-0 3/4"
COL.	35'-4"
FOW	38'-8"
COL.	53'-0"
FOW	52'-4"

UNIT D+ LEFT

UNIT D+ RIGHT