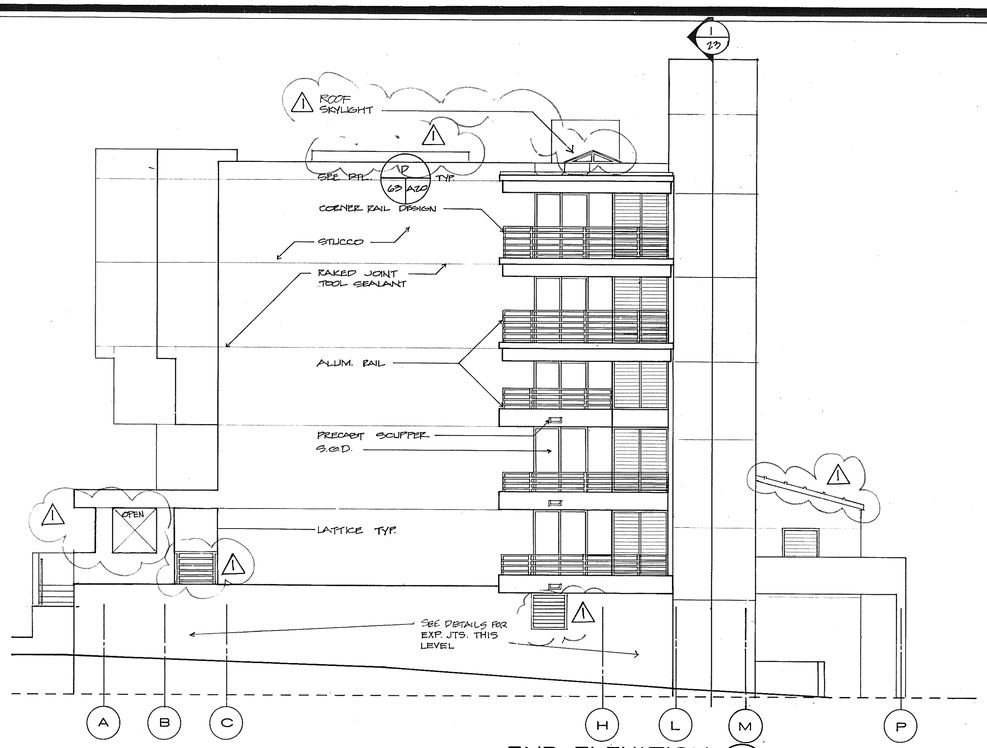

END ELEVATION 1/20

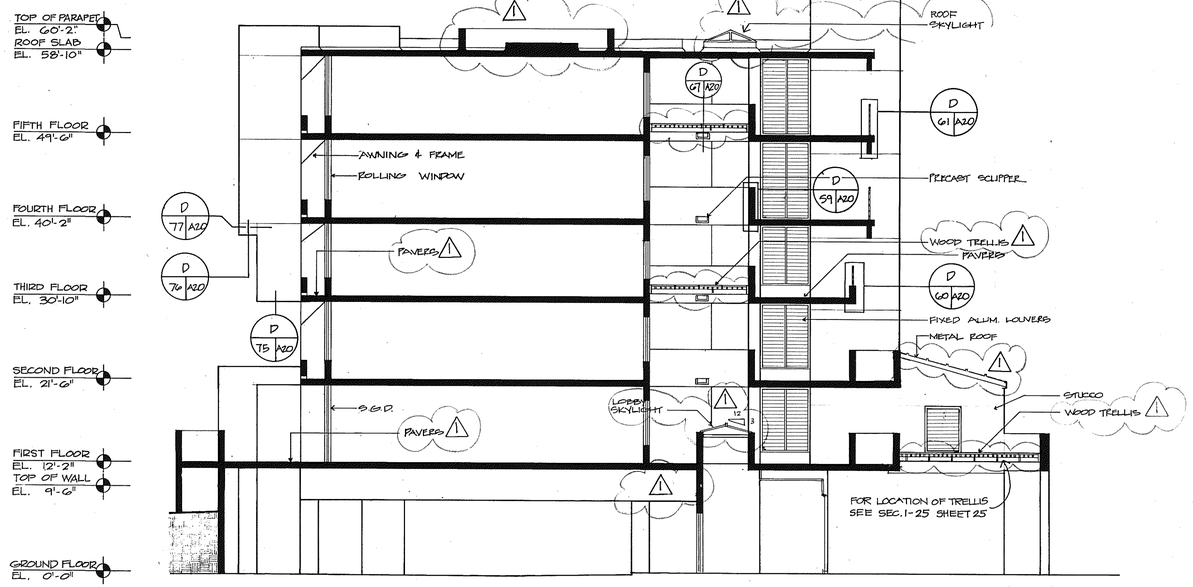

SECTION 3/20

SEE LANDSCAPE PLANS FOR RETAINER WALL LOCATIONS, GRADES & FINISHES OF SITE MATERIALS (TYPICAL)

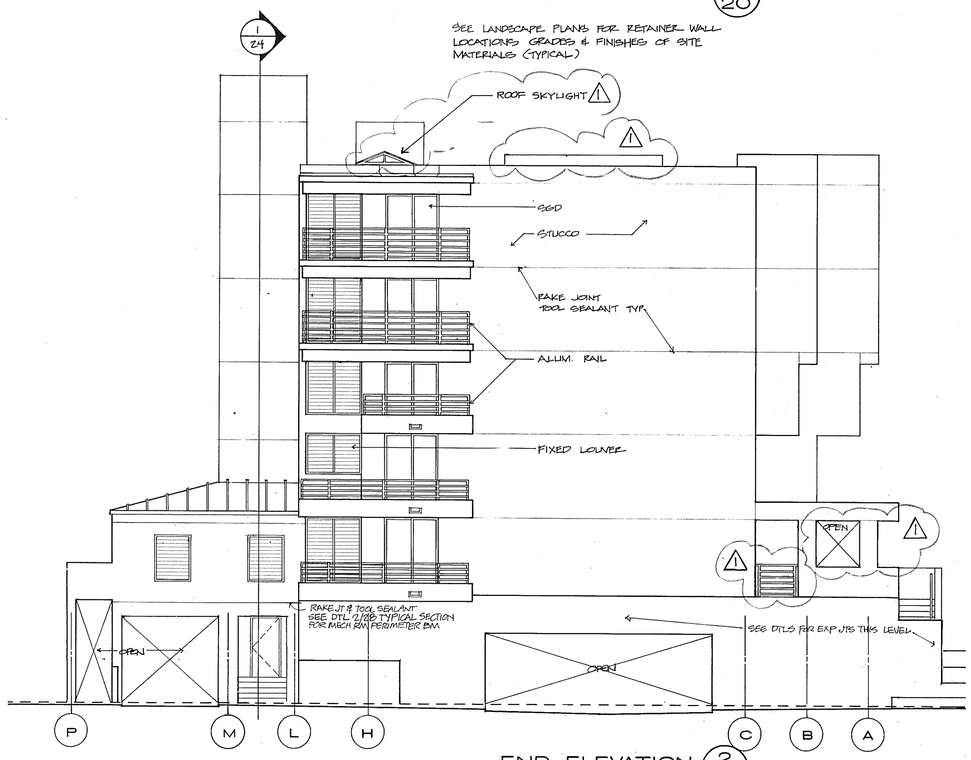

END ELEVATION 2/20

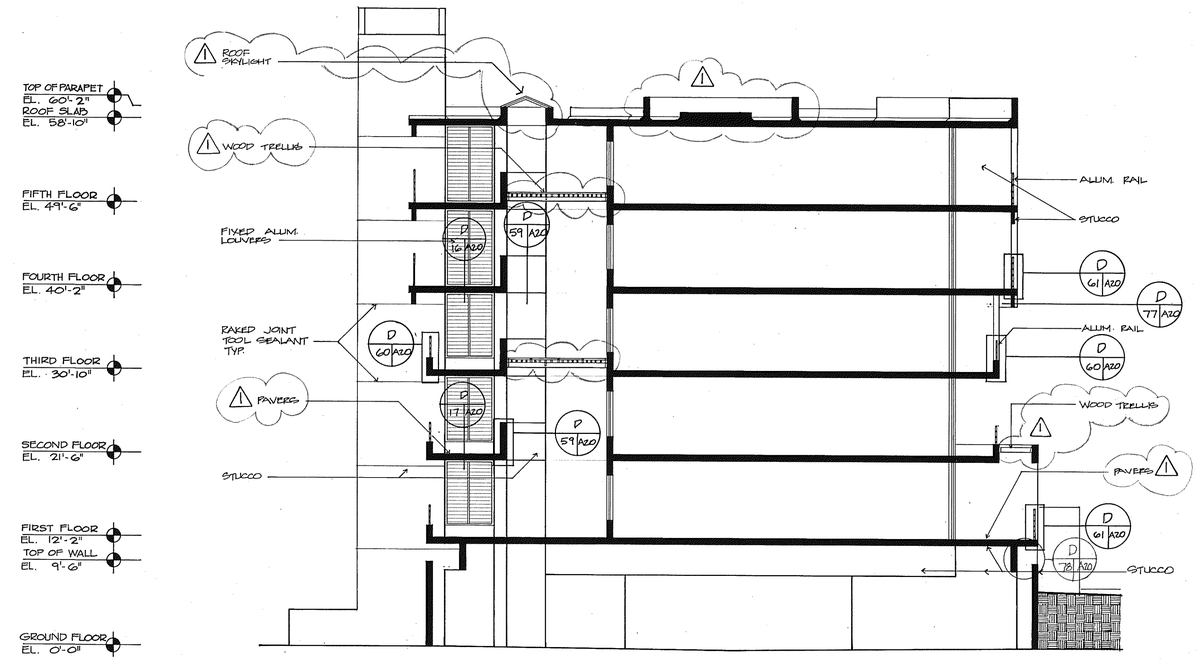

SECTION 4/20

SUNSET BEACH OF LONGBOAT KEY

BUILDING I

ELEVATIONS & SECTIONS 1/8" = 1'-0"

ARVIDA CORPORATION · EDWARD J. SEIBERT AIA ARCHITECT & PLANNER PA · THE SWA GROUP · BRABHAM KUHNS DEBAY CONSULTING ENGINEERS · OLSEN WHITE & ASSOCIATES STRUCTURAL ENGINEERS · BENNETT & BISHOP INC CONSULTING ENGINEERS & SURVEYORS

ISSUED 10 DEC. 82

REVISED 1 4-1-83

SHEET A·20 OF 37