



COMPOSITE

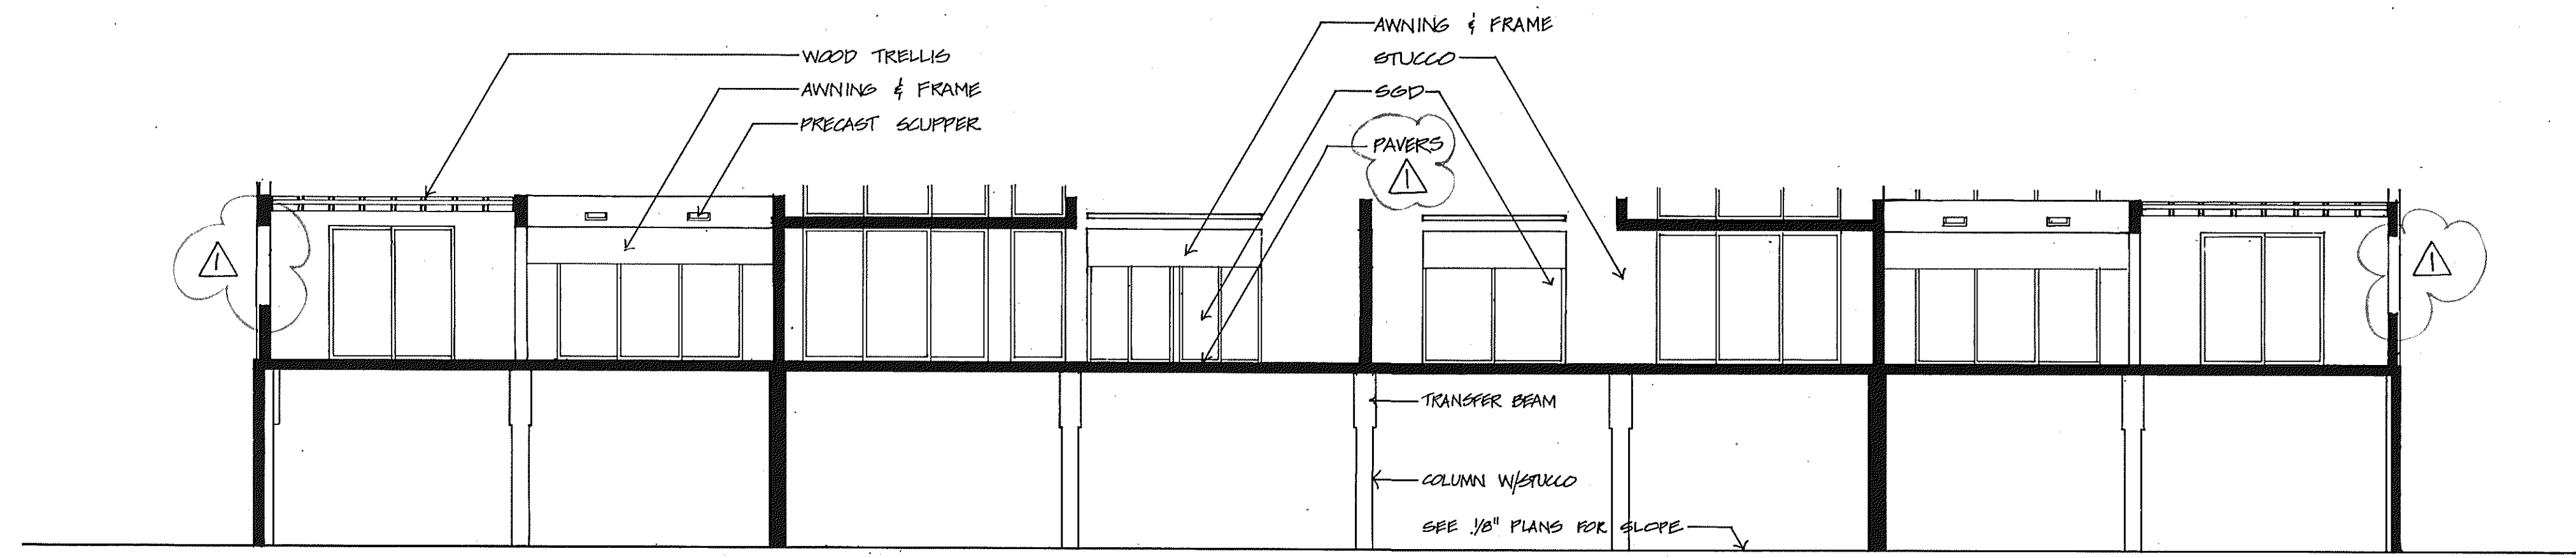

SECTION 1/22

FIRST FLOOR
EL. 12'-2"

GROUND FLOOR
EL. 0'-0"

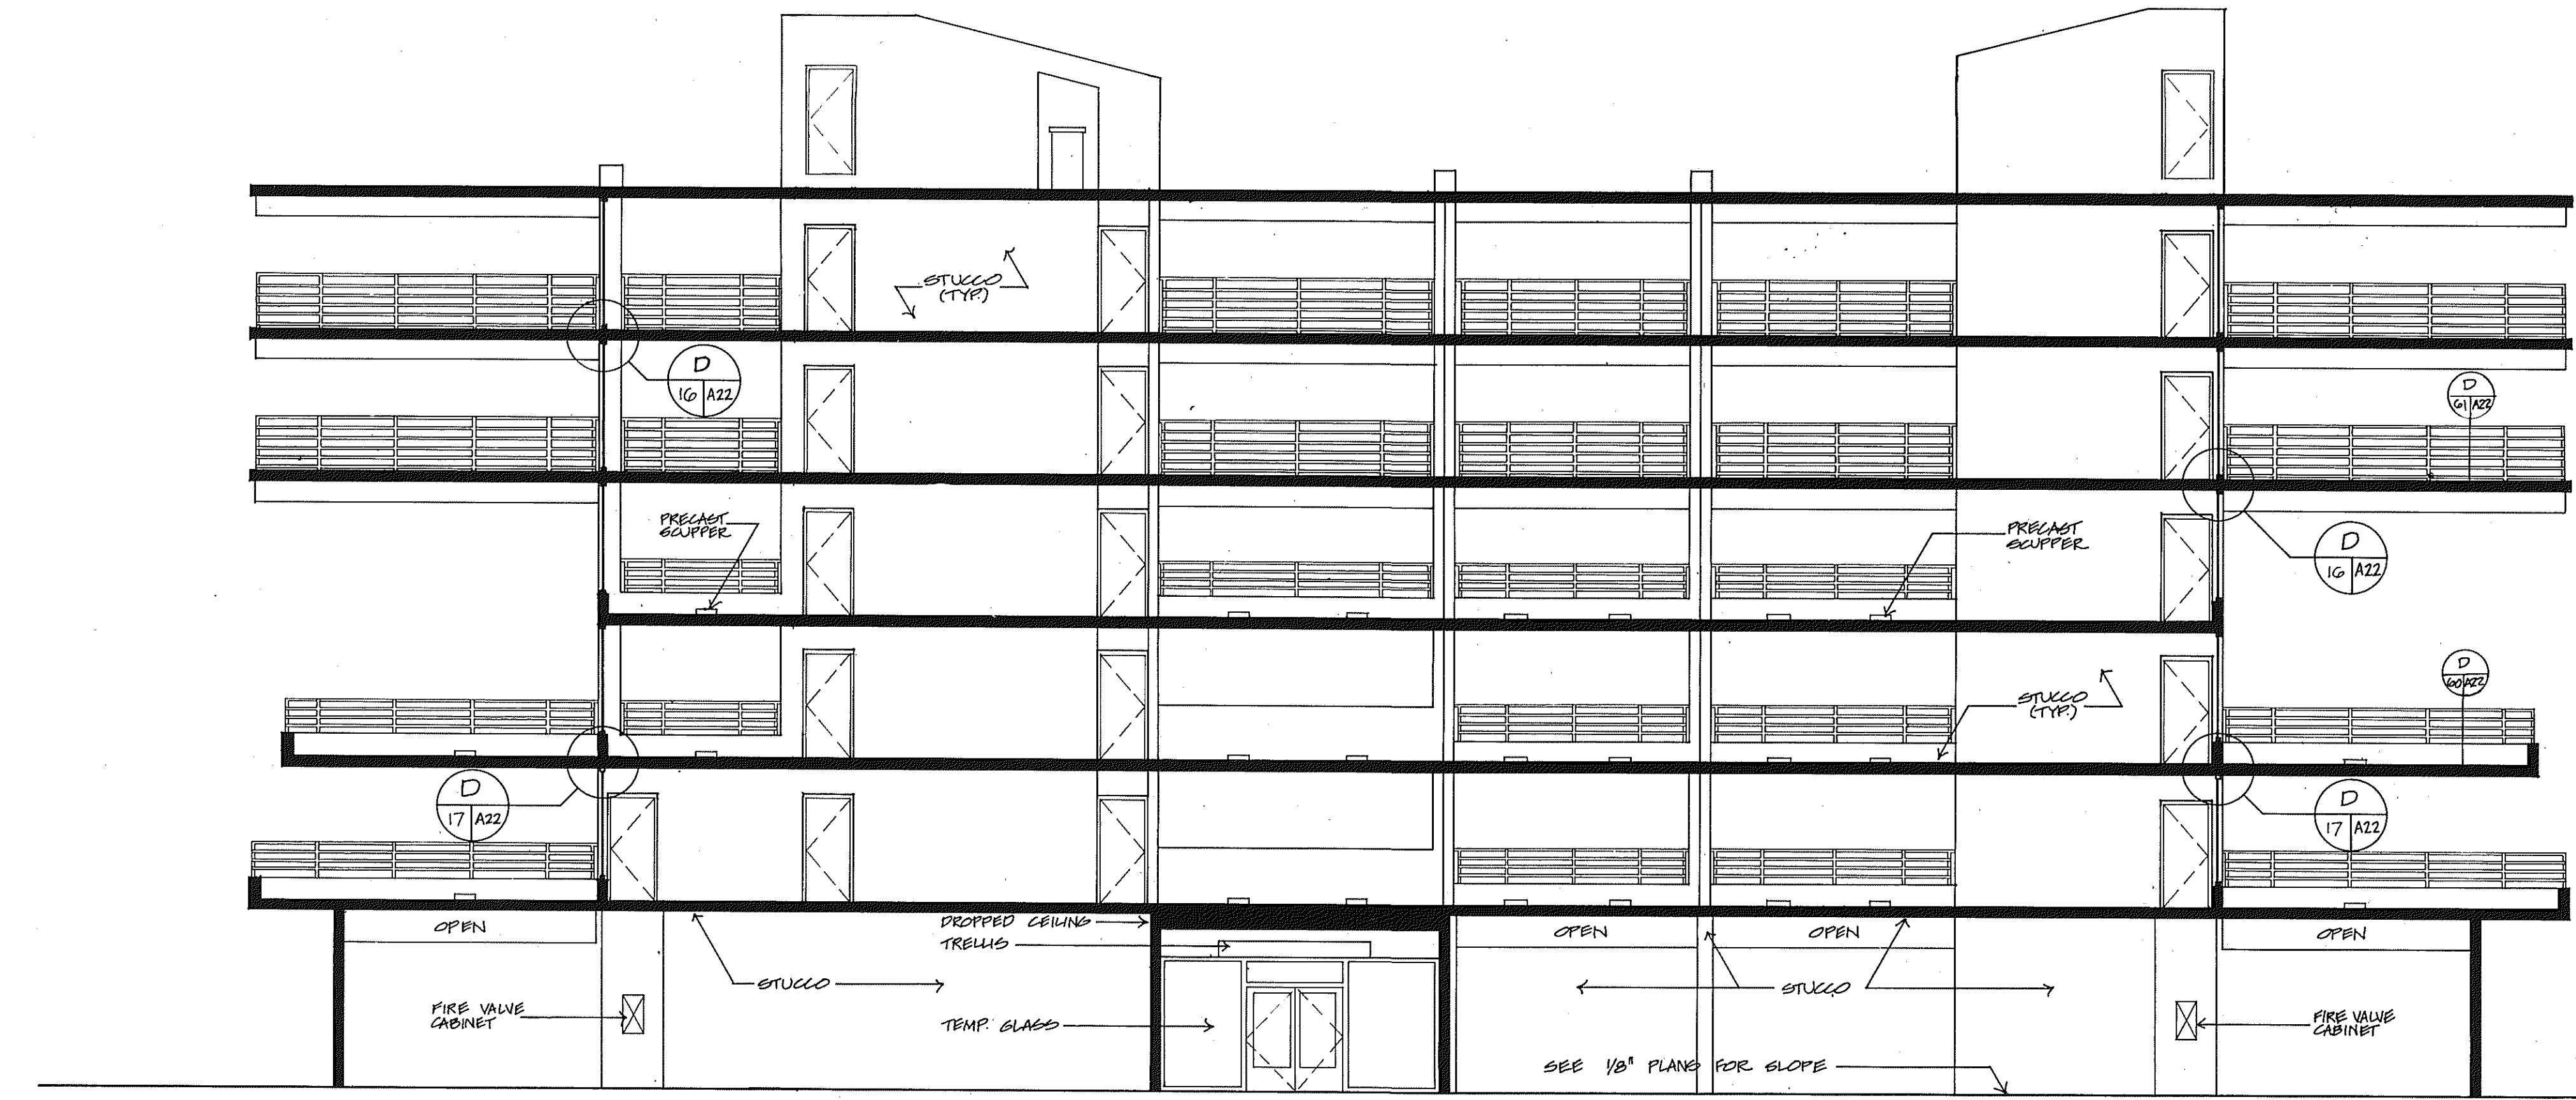

SECTION 2/22

ROOF SLAB
EL. 58'-10"

FIFTH FLOOR
EL. 44'-6"

FOURTH FLOOR
EL. 40'-2"

THIRD FLOOR
EL. 30'-10"

SECOND FLOOR
EL. 21'-6"

FIRST FLOOR
EL. 12'-2"

GROUND FLOOR
EL. 0'-0"