


OVERLAYS
COMPOSITE

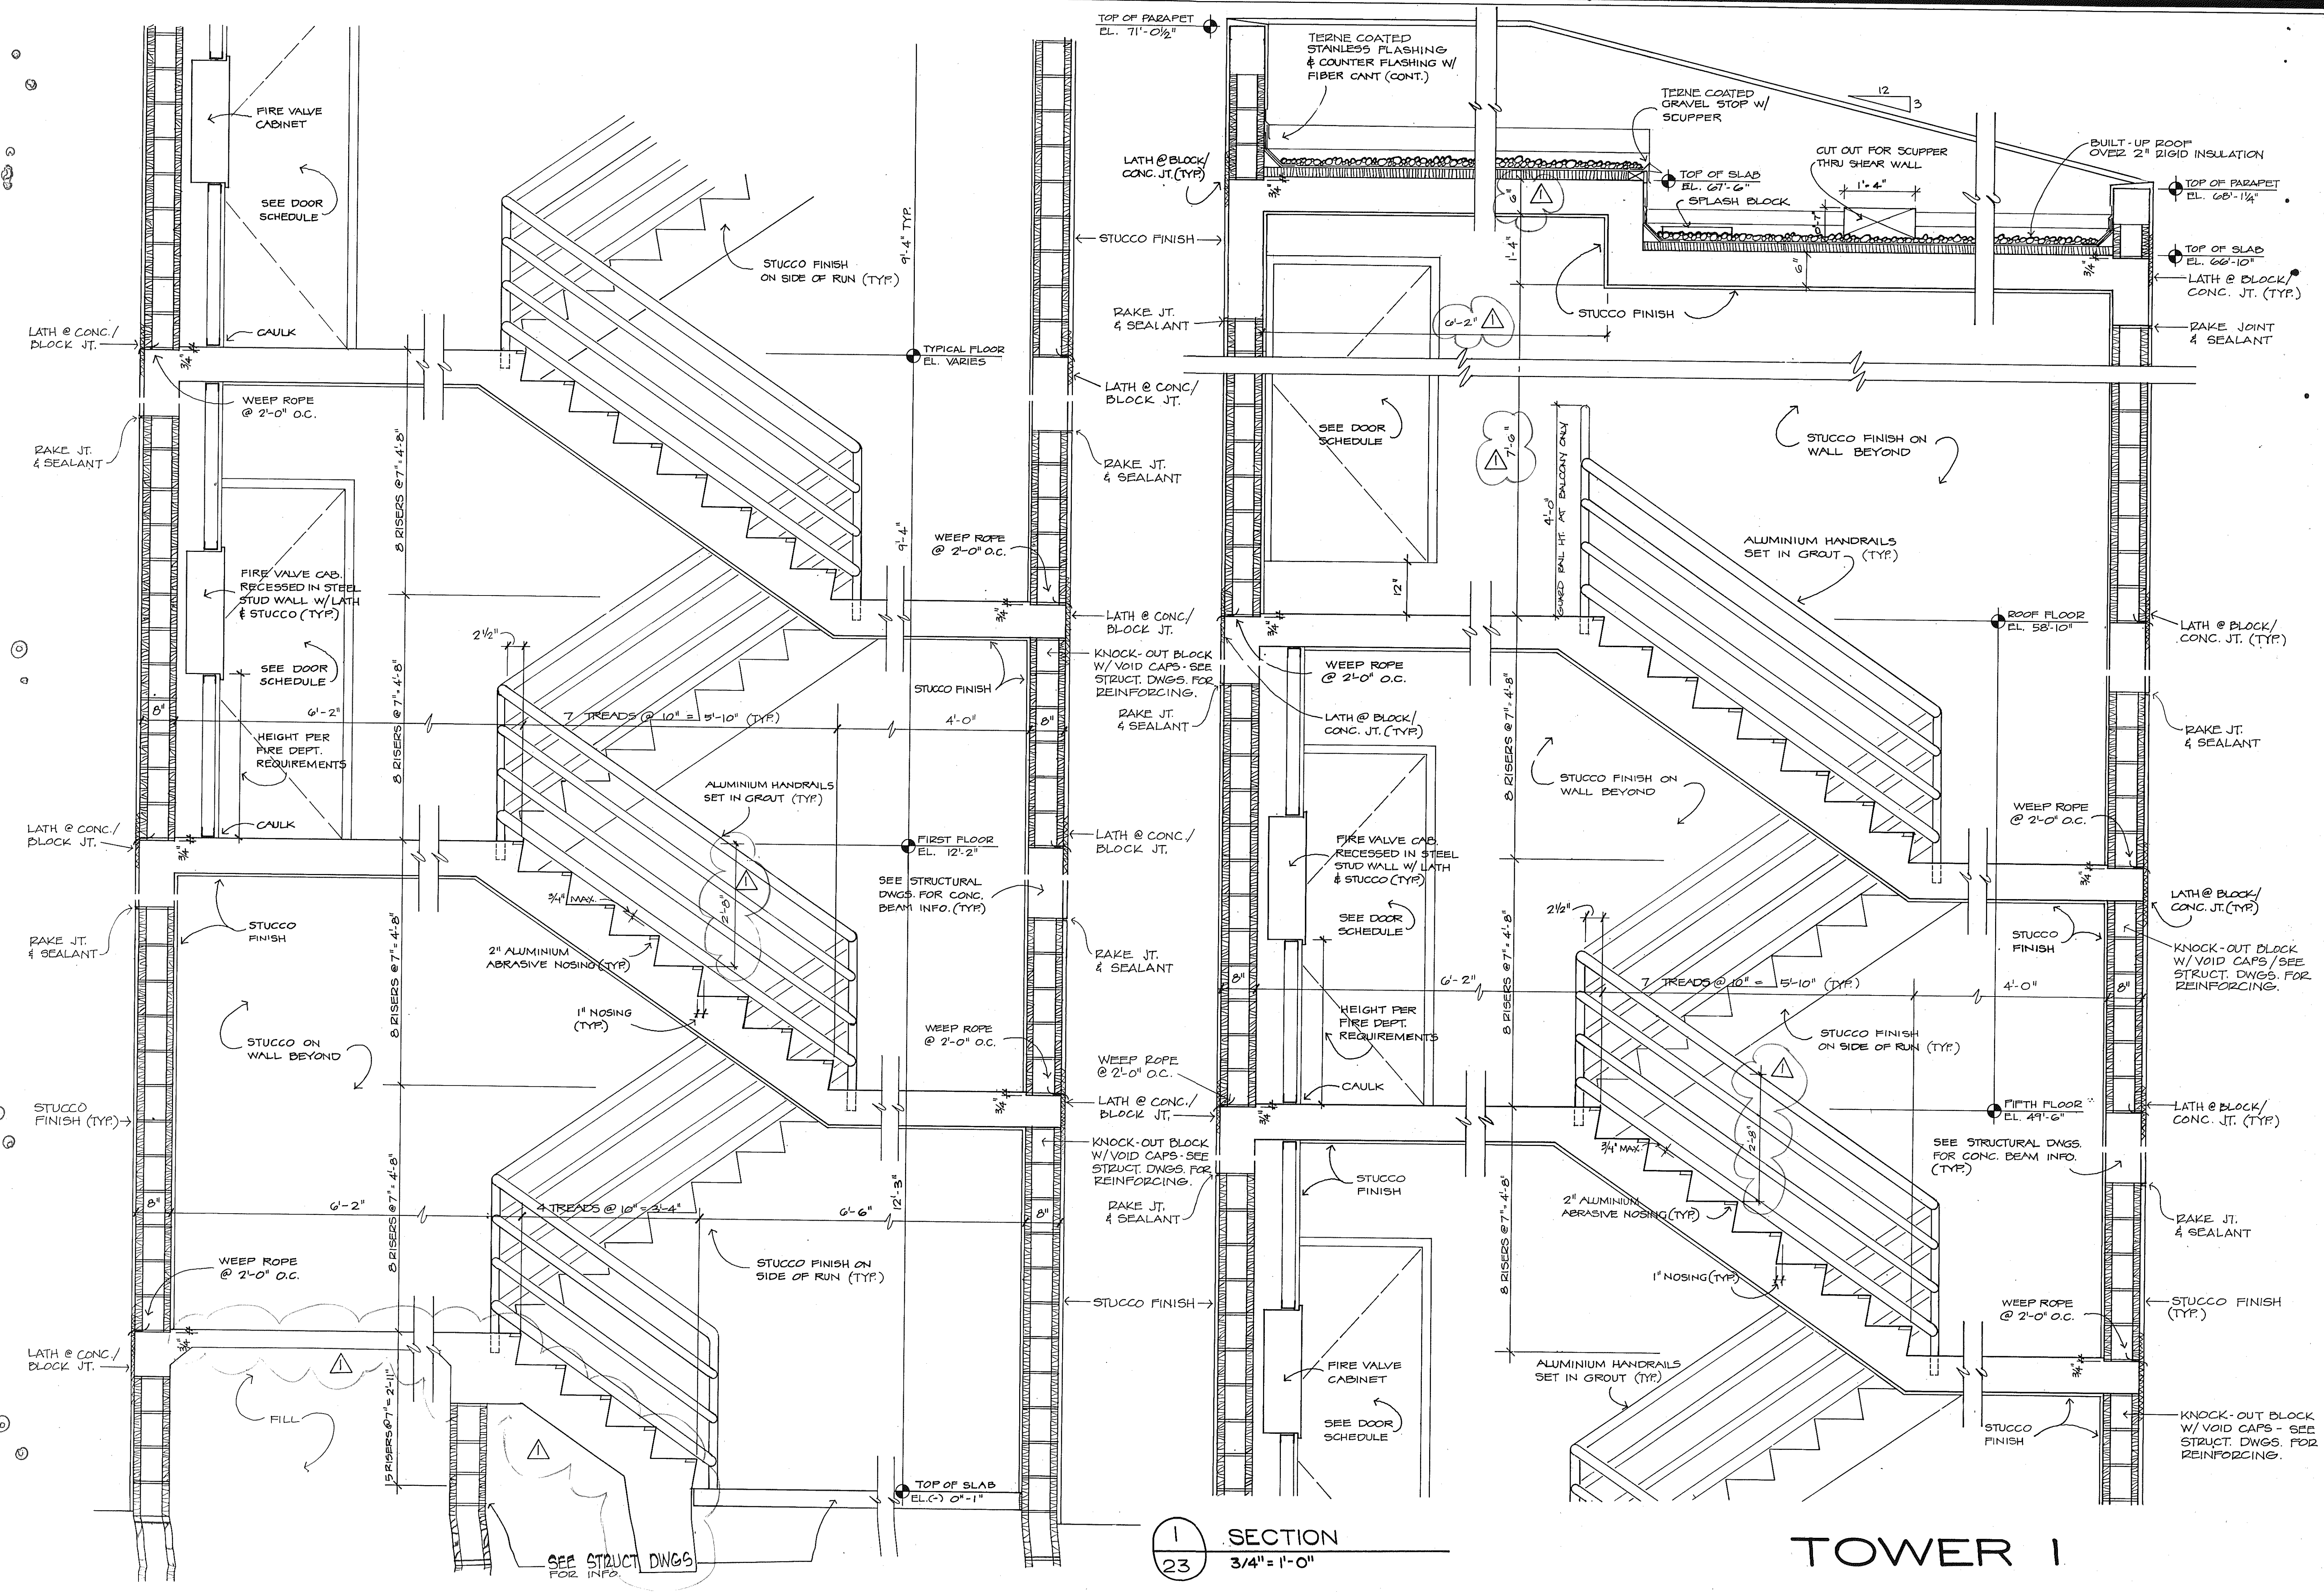

SECTION
23 3/4" = 1'-0"

TOWER 1

BUILDING 1 STAIR SECTIONS 3/4" = 1'-0"
 SUNSET BEACH BOAT KEY
 OF LONG BEACH BOAT KEY
 BUILDING 1 STAIR SECTIONS 3/4" = 1'-0"
 EDWARD J. SEIBERT AIA ARCHITECT & PLANNER PA · THE SWA GROUP
 BRABHAM, KUHNS DEBAY CONSULTING ENGINEERS · OLSEN WHITE & ASSOCIATES STRUCTURAL ENGINEERS · BENNETT & BISHOP INC CONSULTING ENGINEERS & SURVEYORS
 ISSUED 10 DEC 82
 REVISED 4-1-83
 SHEET A-23 OF 37