


10  
 11  
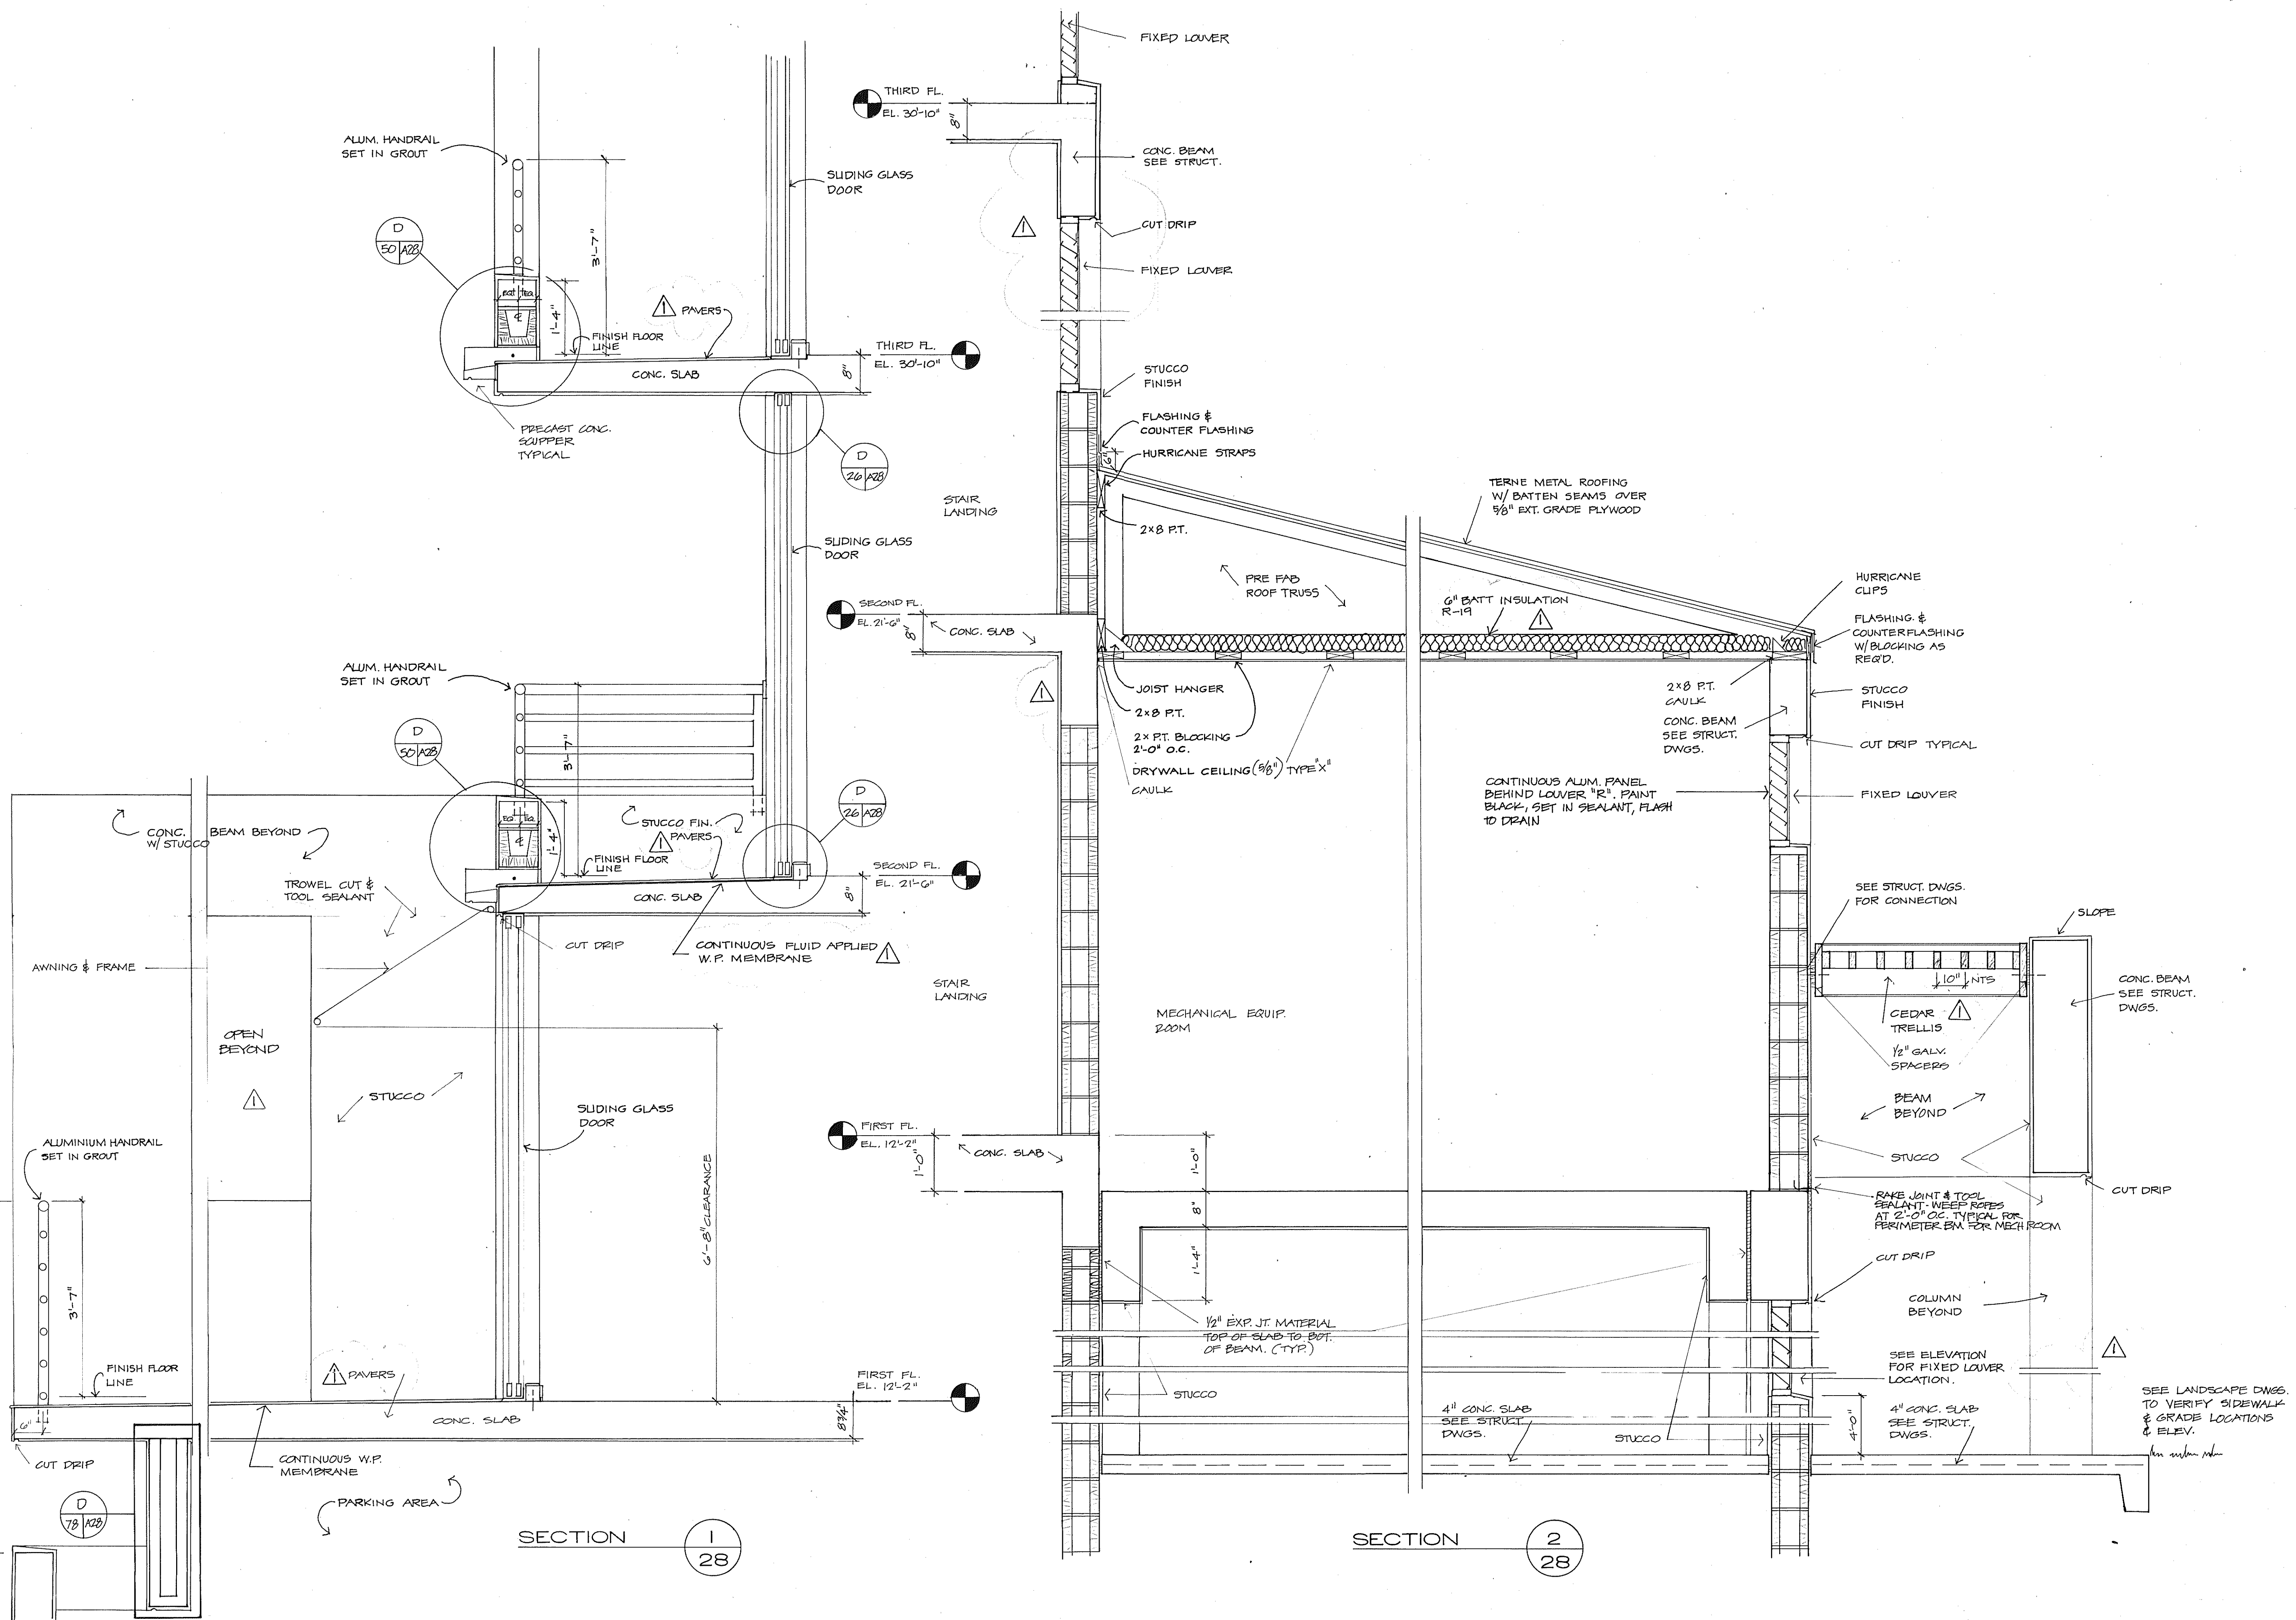

SECTION 1 28

SECTION 2 28

**SUNSET BEACH**  
 SOF LONG BOAT KEY  
 BLDG. 1 & BLDG. 2 REV. BUILDING SECTION 3/4" = 1'-0"  
 ARVIDA CORPORATION · EDWARD J. SEIBERT AIA ARCHITECT & PLANNER PA · THE SWA GROUP  
 BRABHAM KUHN DEBAY CONSULTING ENGINEERS · OLSEN WHITE & ASSOCIATES STRUCTURAL ENGINEERS · BENNETT & BISHOP INC CONSULTING ENGINEERS & SURVEYORS  
 ISSUED 10 DEC. 82  
 REVISED 4-1-83  
 SHEET A-28 OF 37  
 SEE LANDSCAPE DWGS. TO VERIFY SIDEWALK & GRADE LOCATIONS & ELEV.