


SECTION 1  
3/8"=1'-0" 29 BUILDING 3


SECTION 2  
3/8"=1'-0" 29 BUILDING 3

\* MEASURED FROM INTERIOR FINISH FLOOR LINE. TYP ALL LANDINGS


NOTES  
ALUMINUM RAIL GATES: PIVOT HINGES AND LATCH HARDWARE TO BE PROVIDED BY ALUM. RAIL FABRICATOR. SUBMIT SAMPLES TO ARCHITECT FOR APPROVAL PRIOR TO FABRICATION.

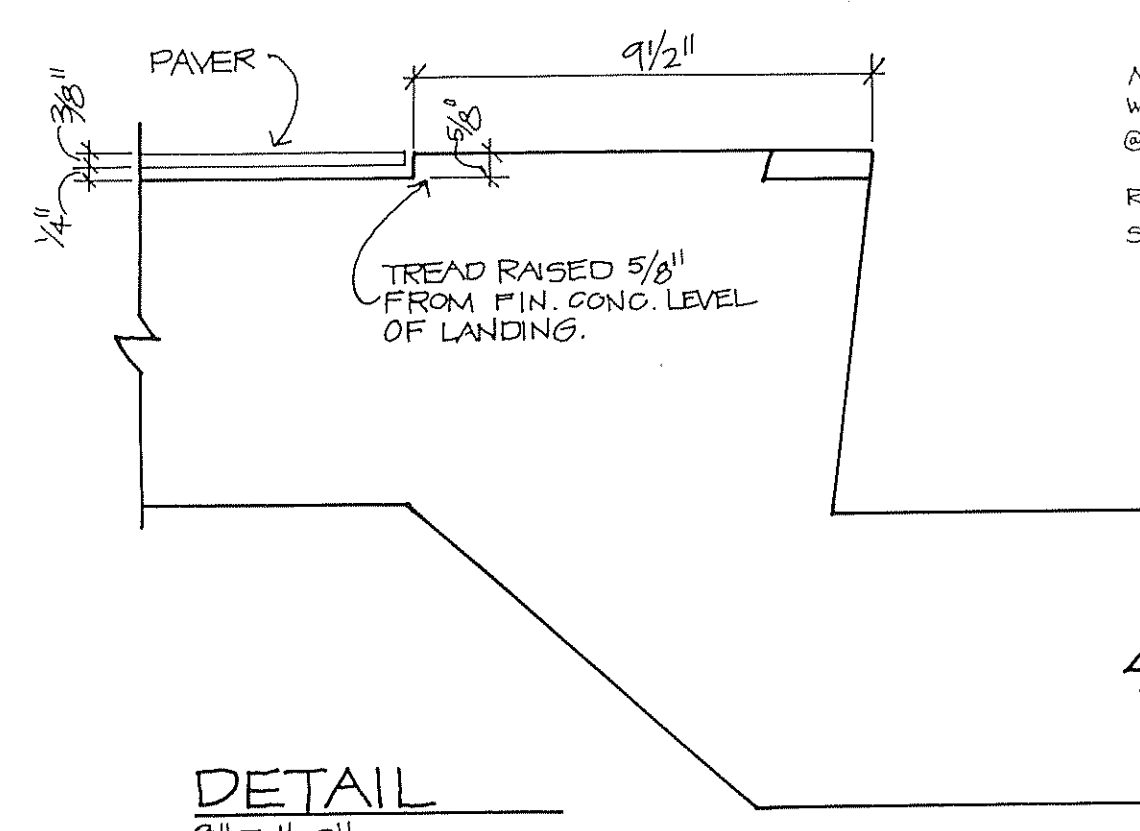


DETAIL 1  
3/8"=1'-0"

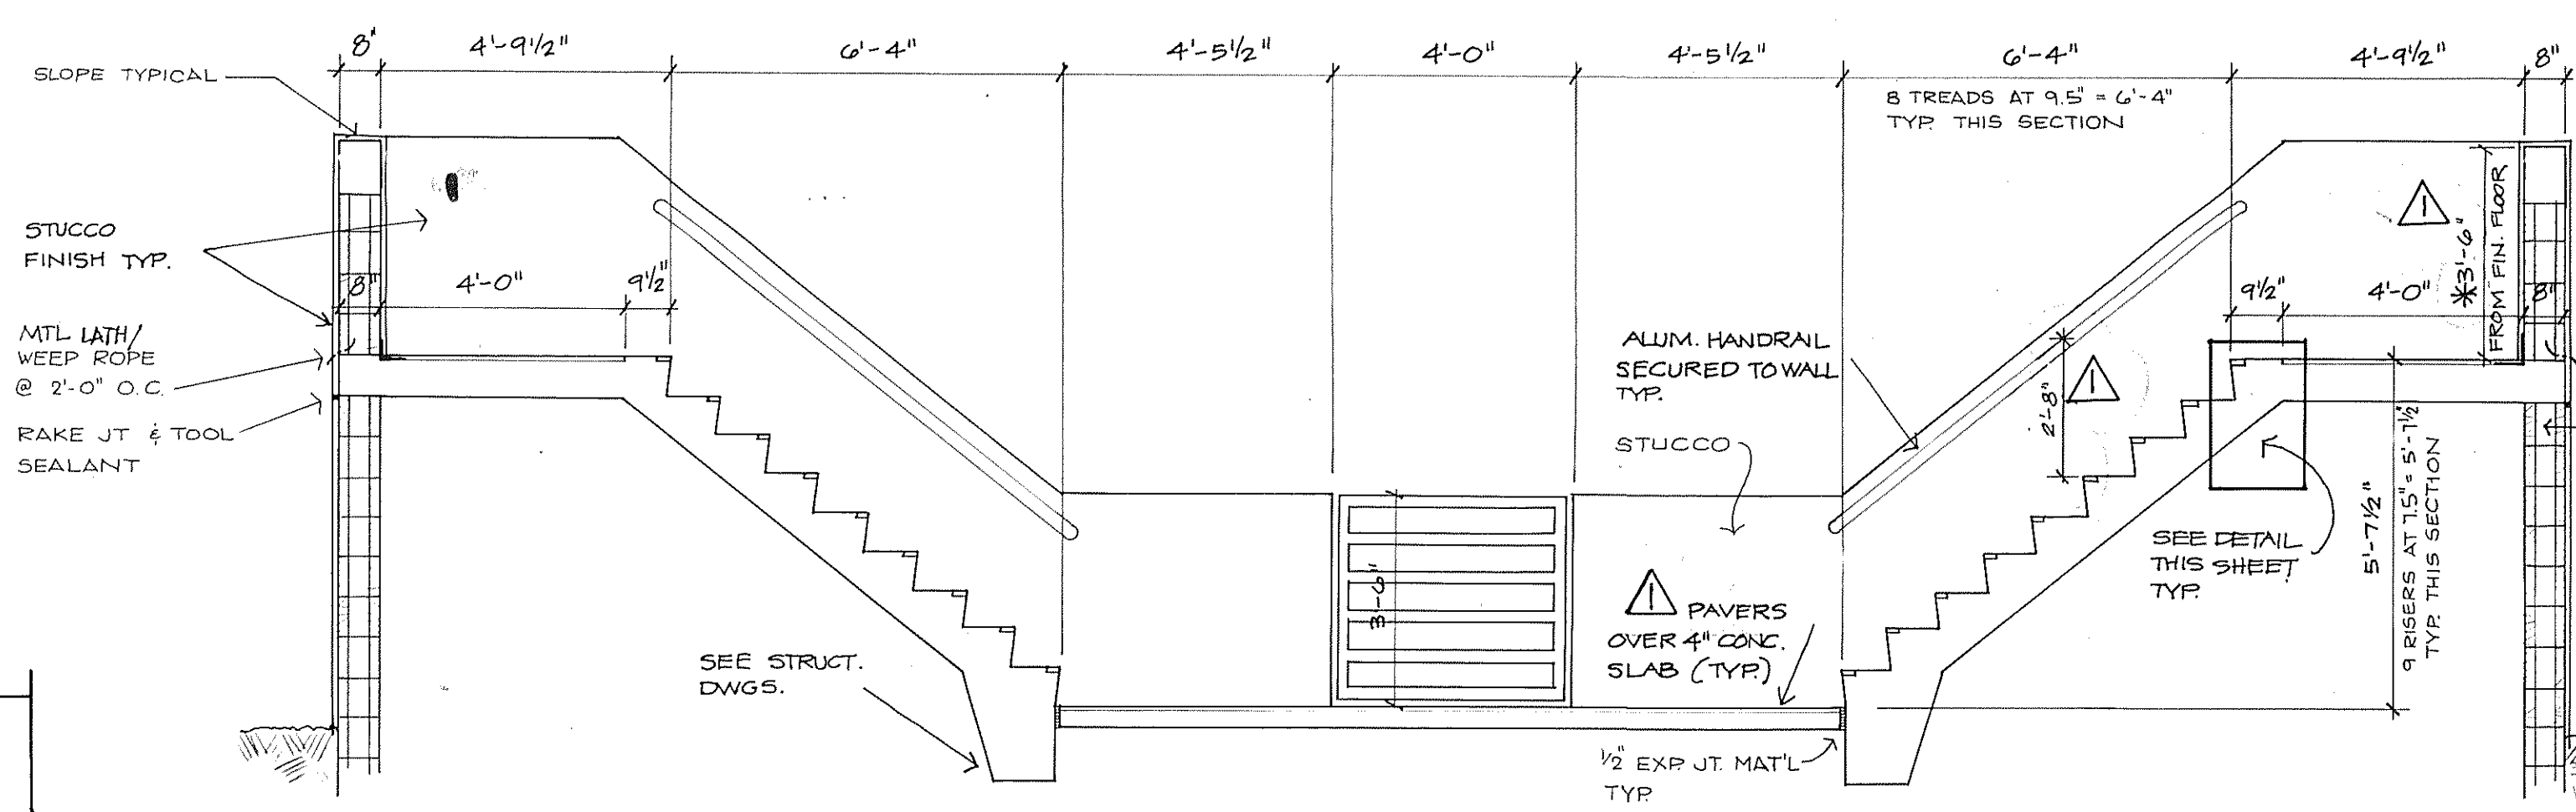


SECTION 3  
3/8"=1'-0" 29 BUILDING 2

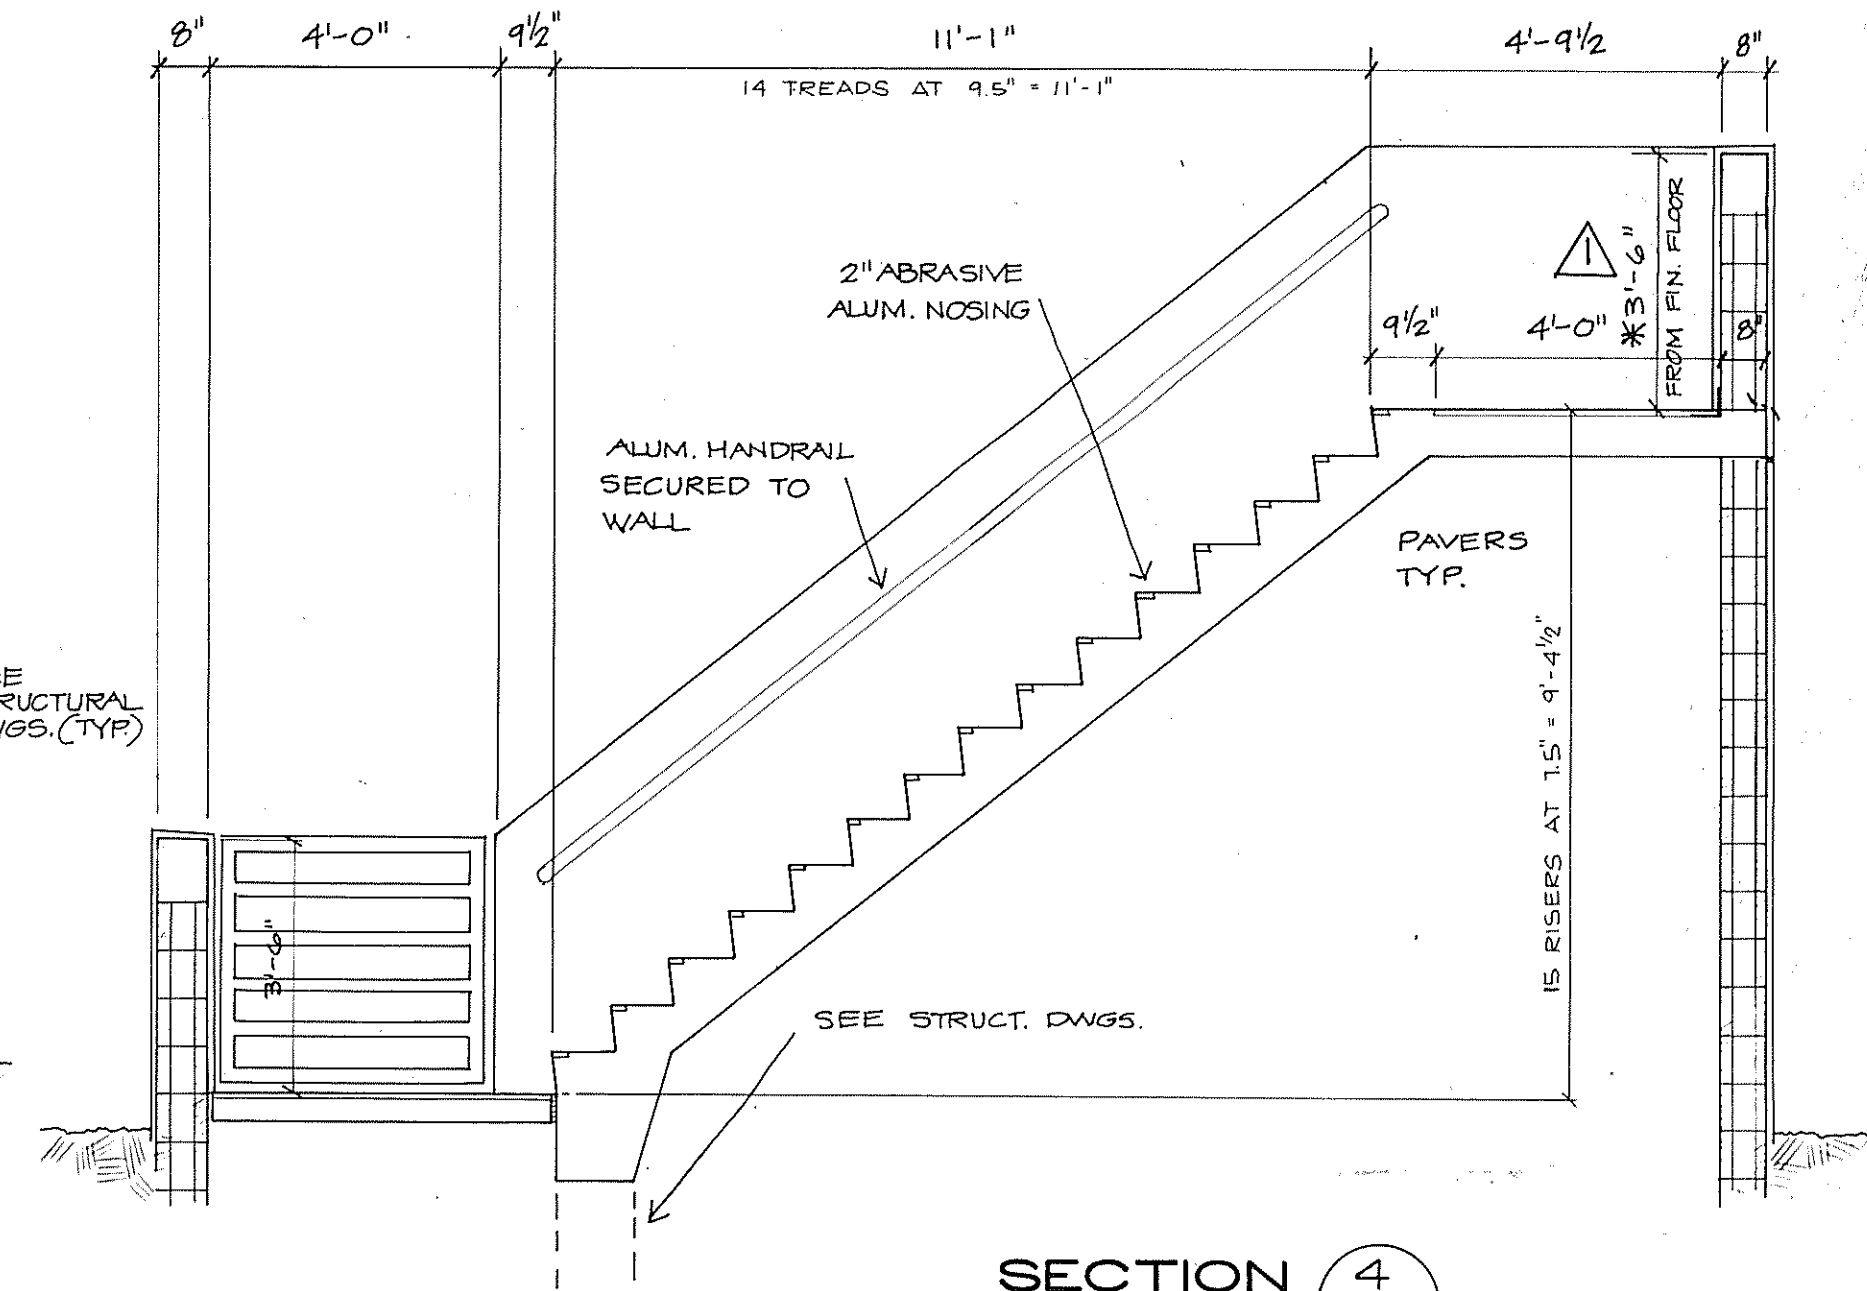


SECTION 4  
3/8"=1'-0" 29 BUILDING 3

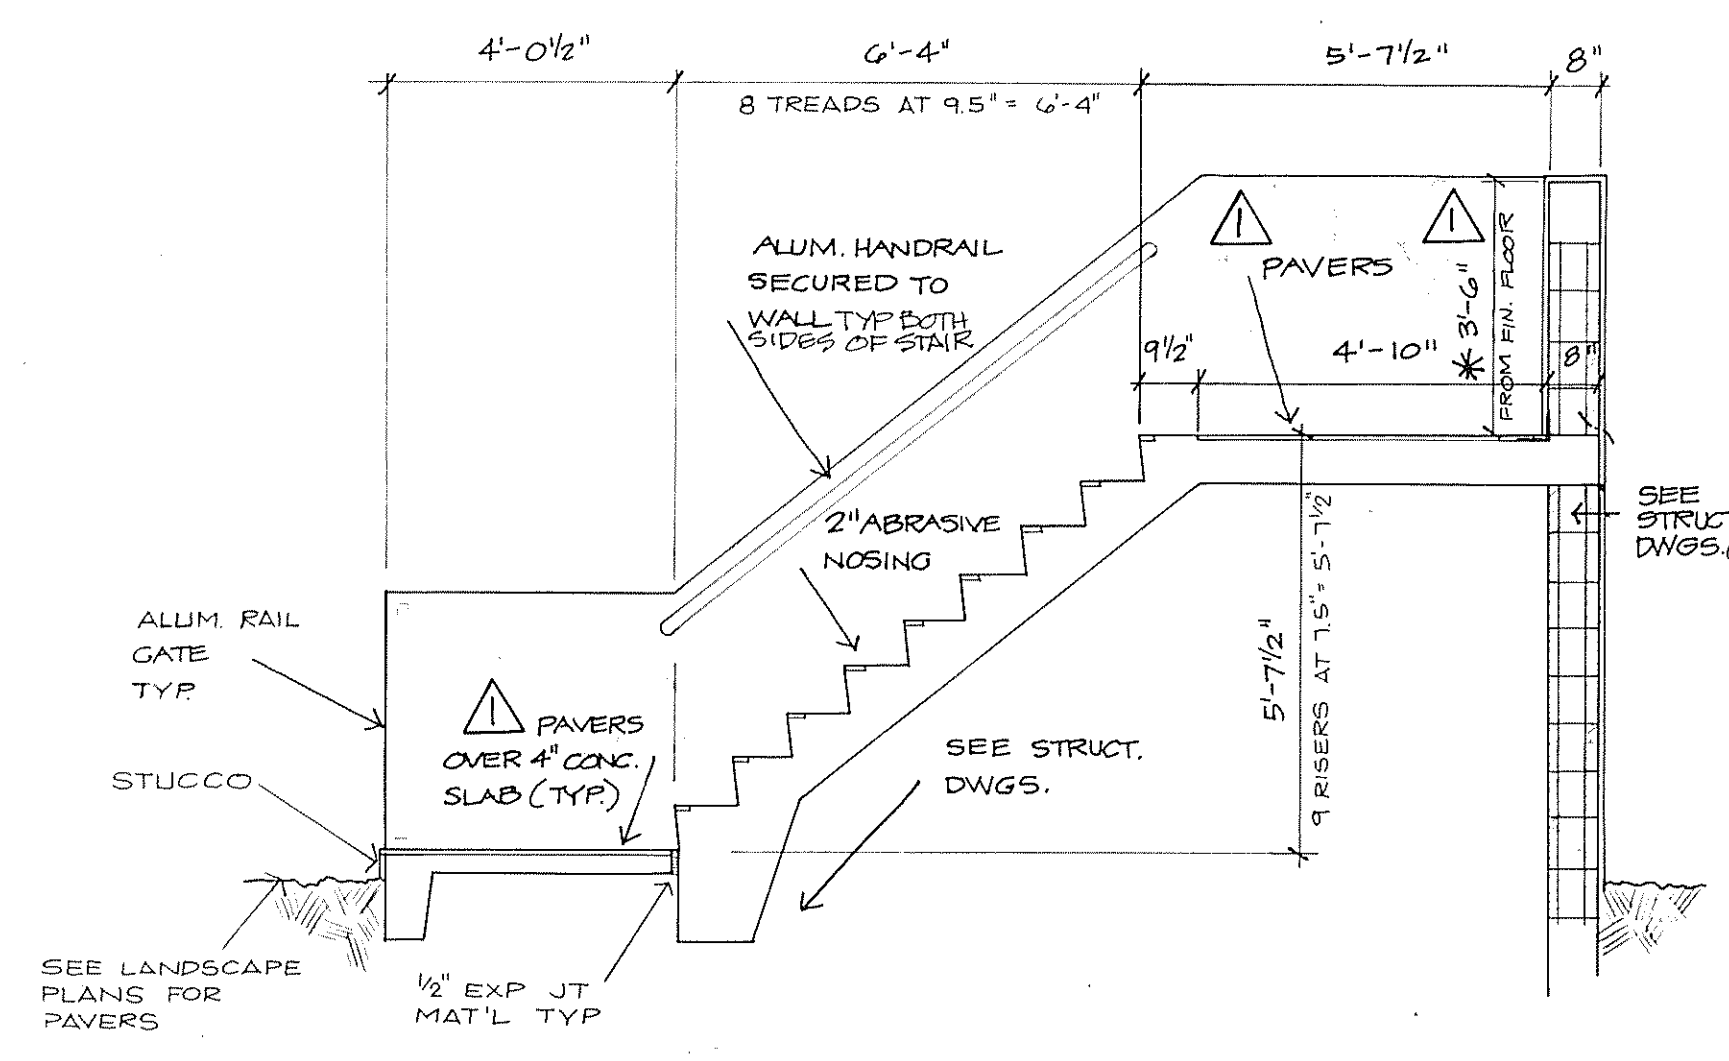

SECTION 5  
3/8"=1'-0" 29 BUILDING 2

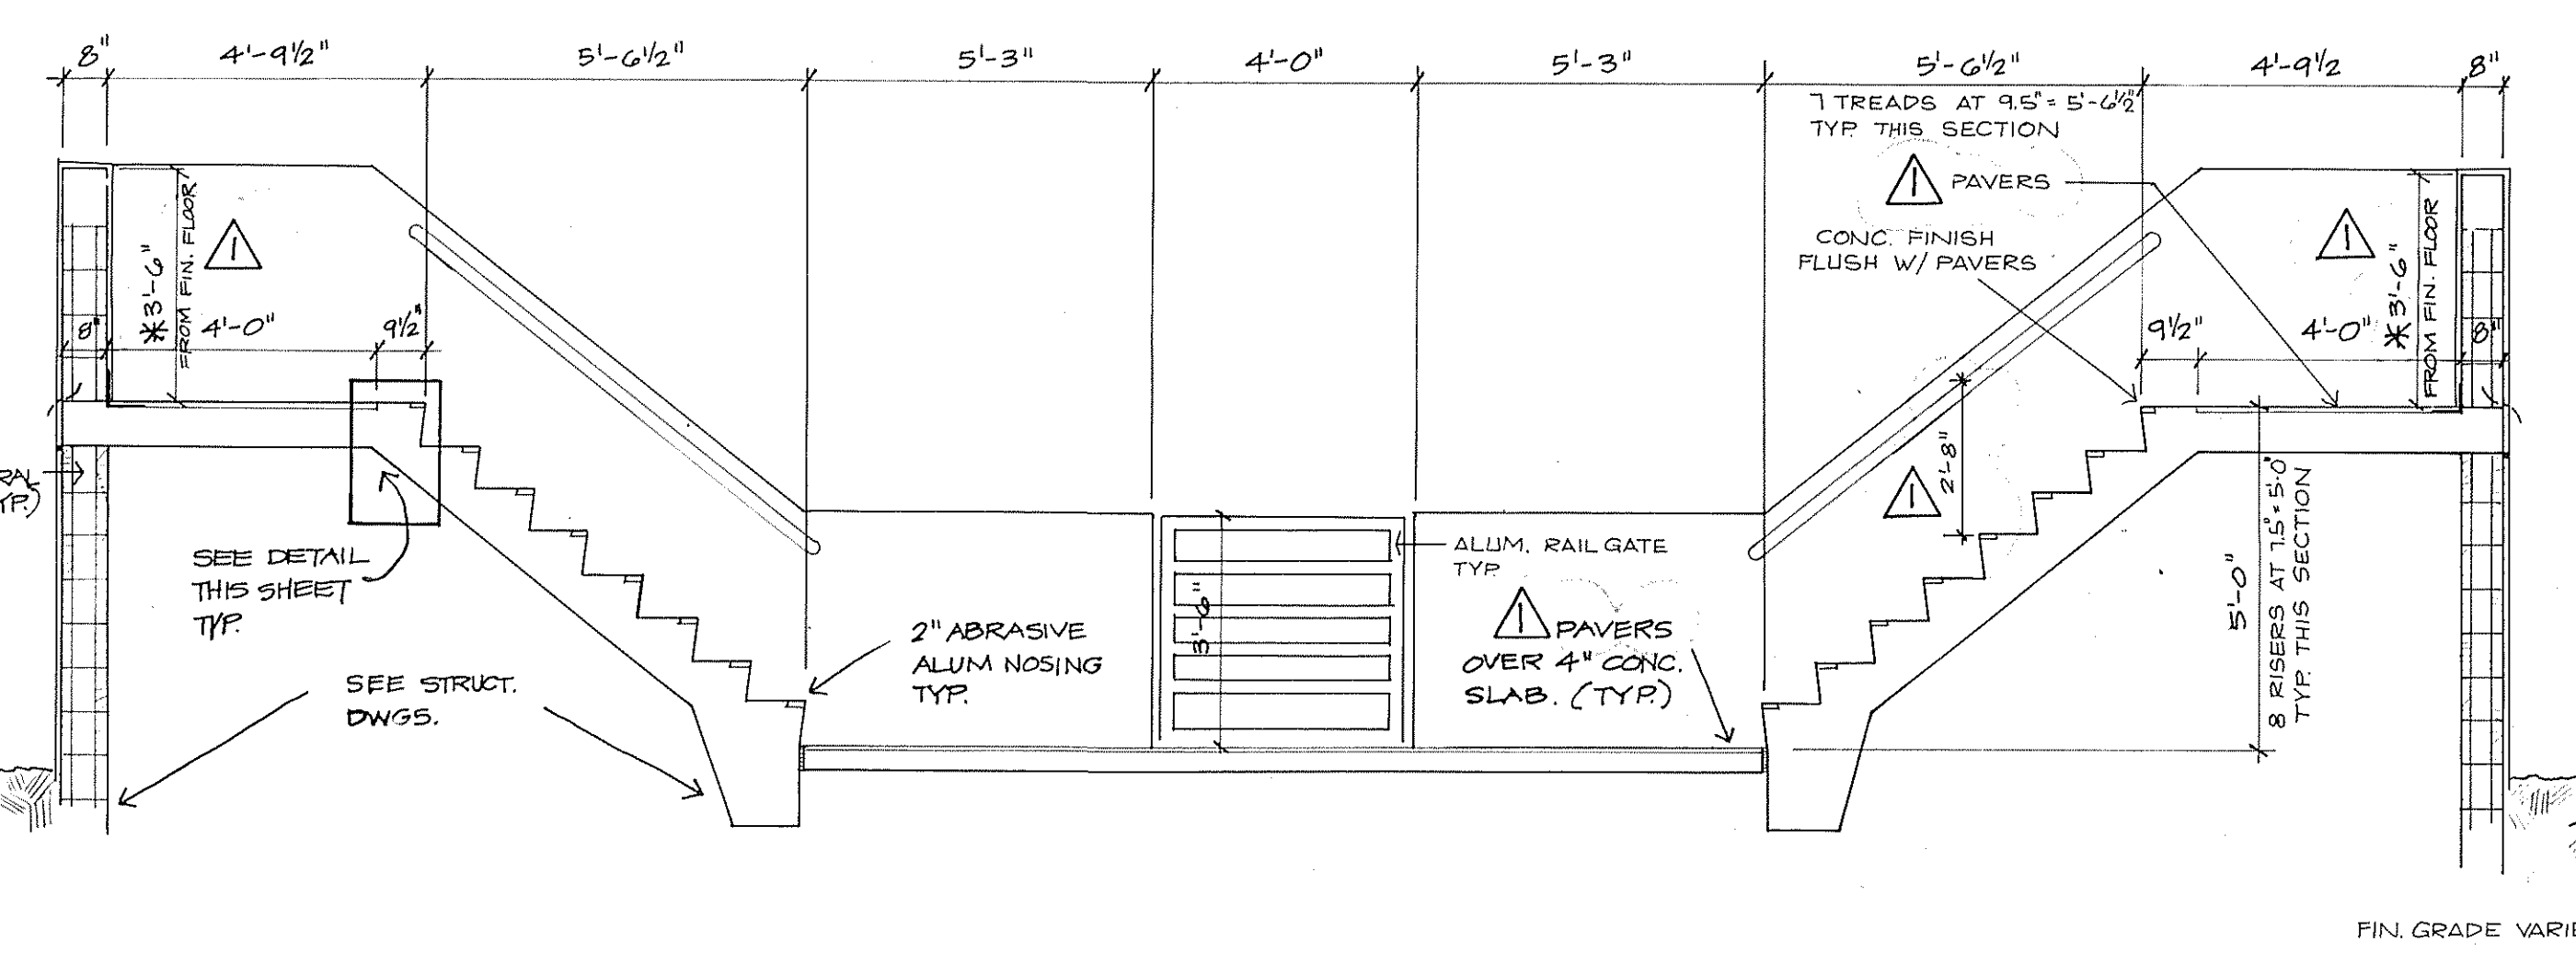

SECTION 6  
3/8"=1'-0" 29 BUILDING 1

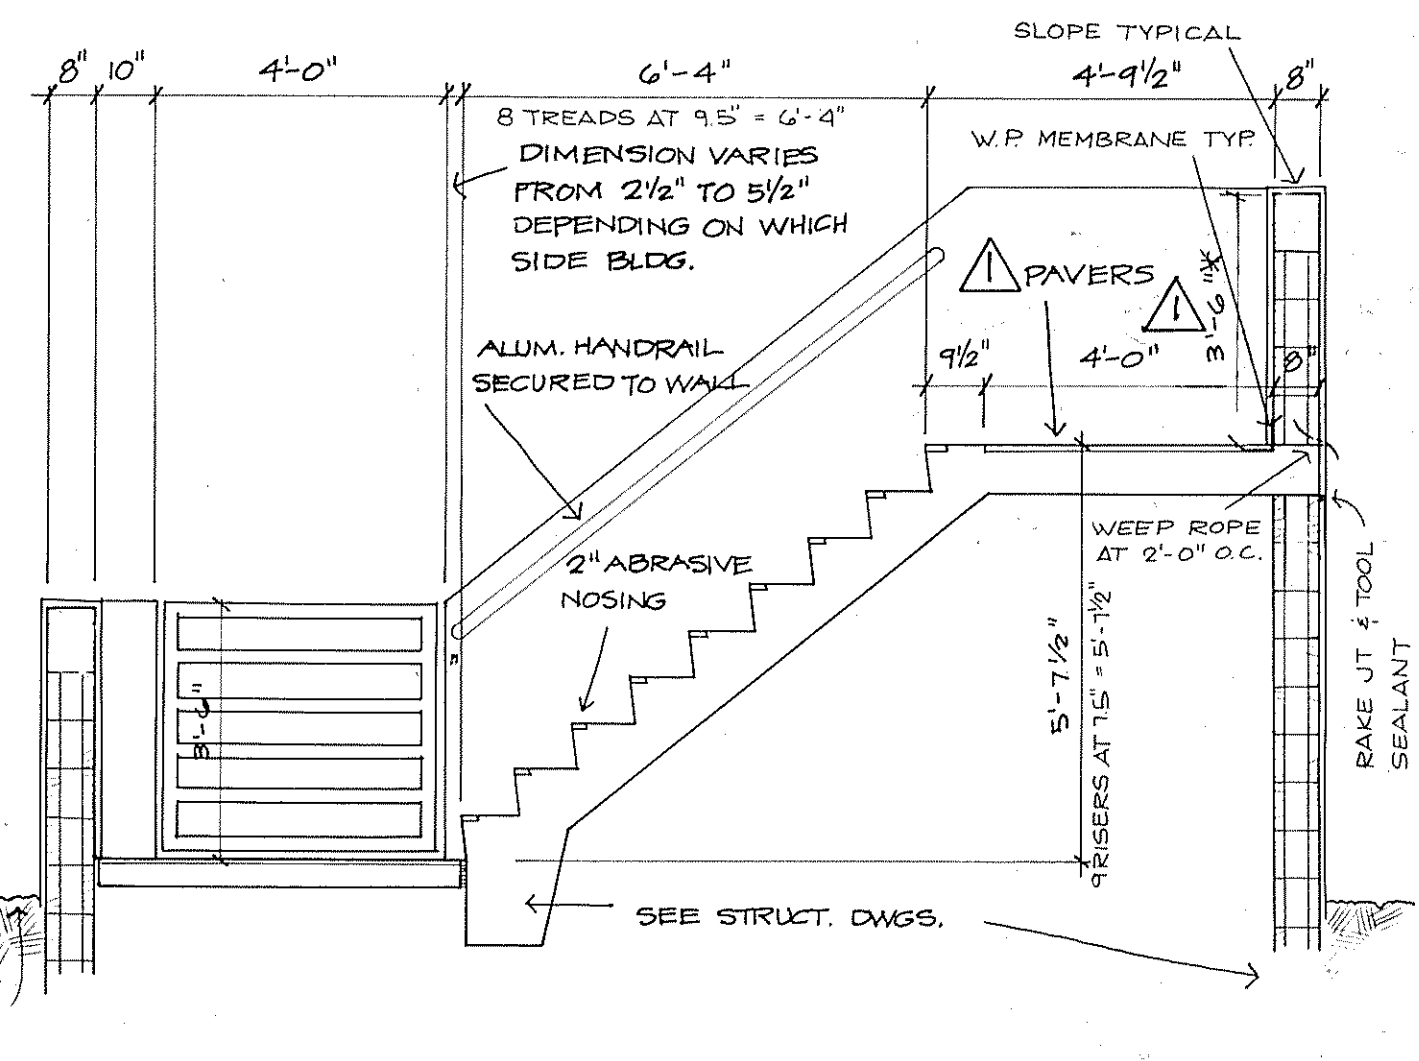

SECTION 7  
3/8"=1'-0" 29 BUILDINGS 1&2